


PLAT OF SURVEY  
-OF-


LOT 59, WHISPERING PINES SECOND ADDITION, BEING PART OF THE NORTHWEST 1/4 OF THE SOUTHEAST 1/4 OF SECTION 13, TOWN 2 NORTH, RANGE 15 EAST, IN THE CITY OF DELAVAN, COUNTY OF WALWORTH, STATE OF WISCONSIN.

SURVEY FOR: SOUTHEASTERN WISCONSIN HOUSING CORP.  
PROPOSED ADDRESS: SPRUCE STREET


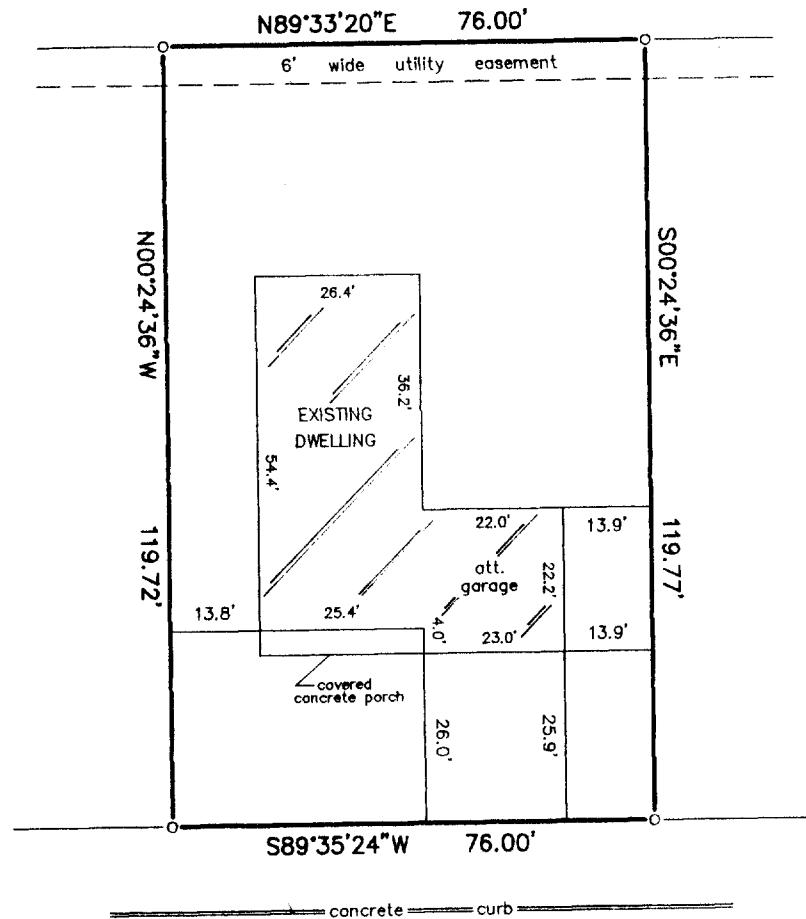


LEGEND

- FOUND IRON PIPE
- SET IRON PIPE

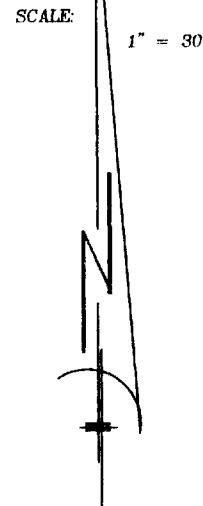

— SPRUCE — (66' WIDE) — STREET —

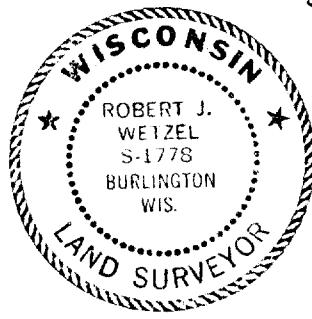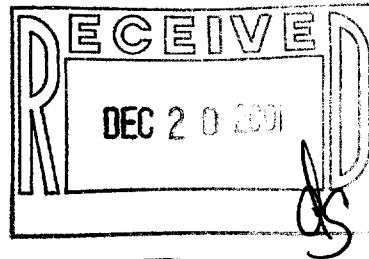

THIS IS NOT AN ORIGINAL PRINT  
UNLESS THIS SEAL IS RED.

*Robert J. Wetzel*  
ROBERT J. WETZEL S-1778

OCTOBER 23, 2001

4773

DATE

JOB NUMBER



B.W. SURVEYING

412 N. PINE STREET  
BURLINGTON, WI 53105  
(414)-767-0225

XWP2-6 002-1949