




SCALE - 1" = 20'
O = IRON PIPE

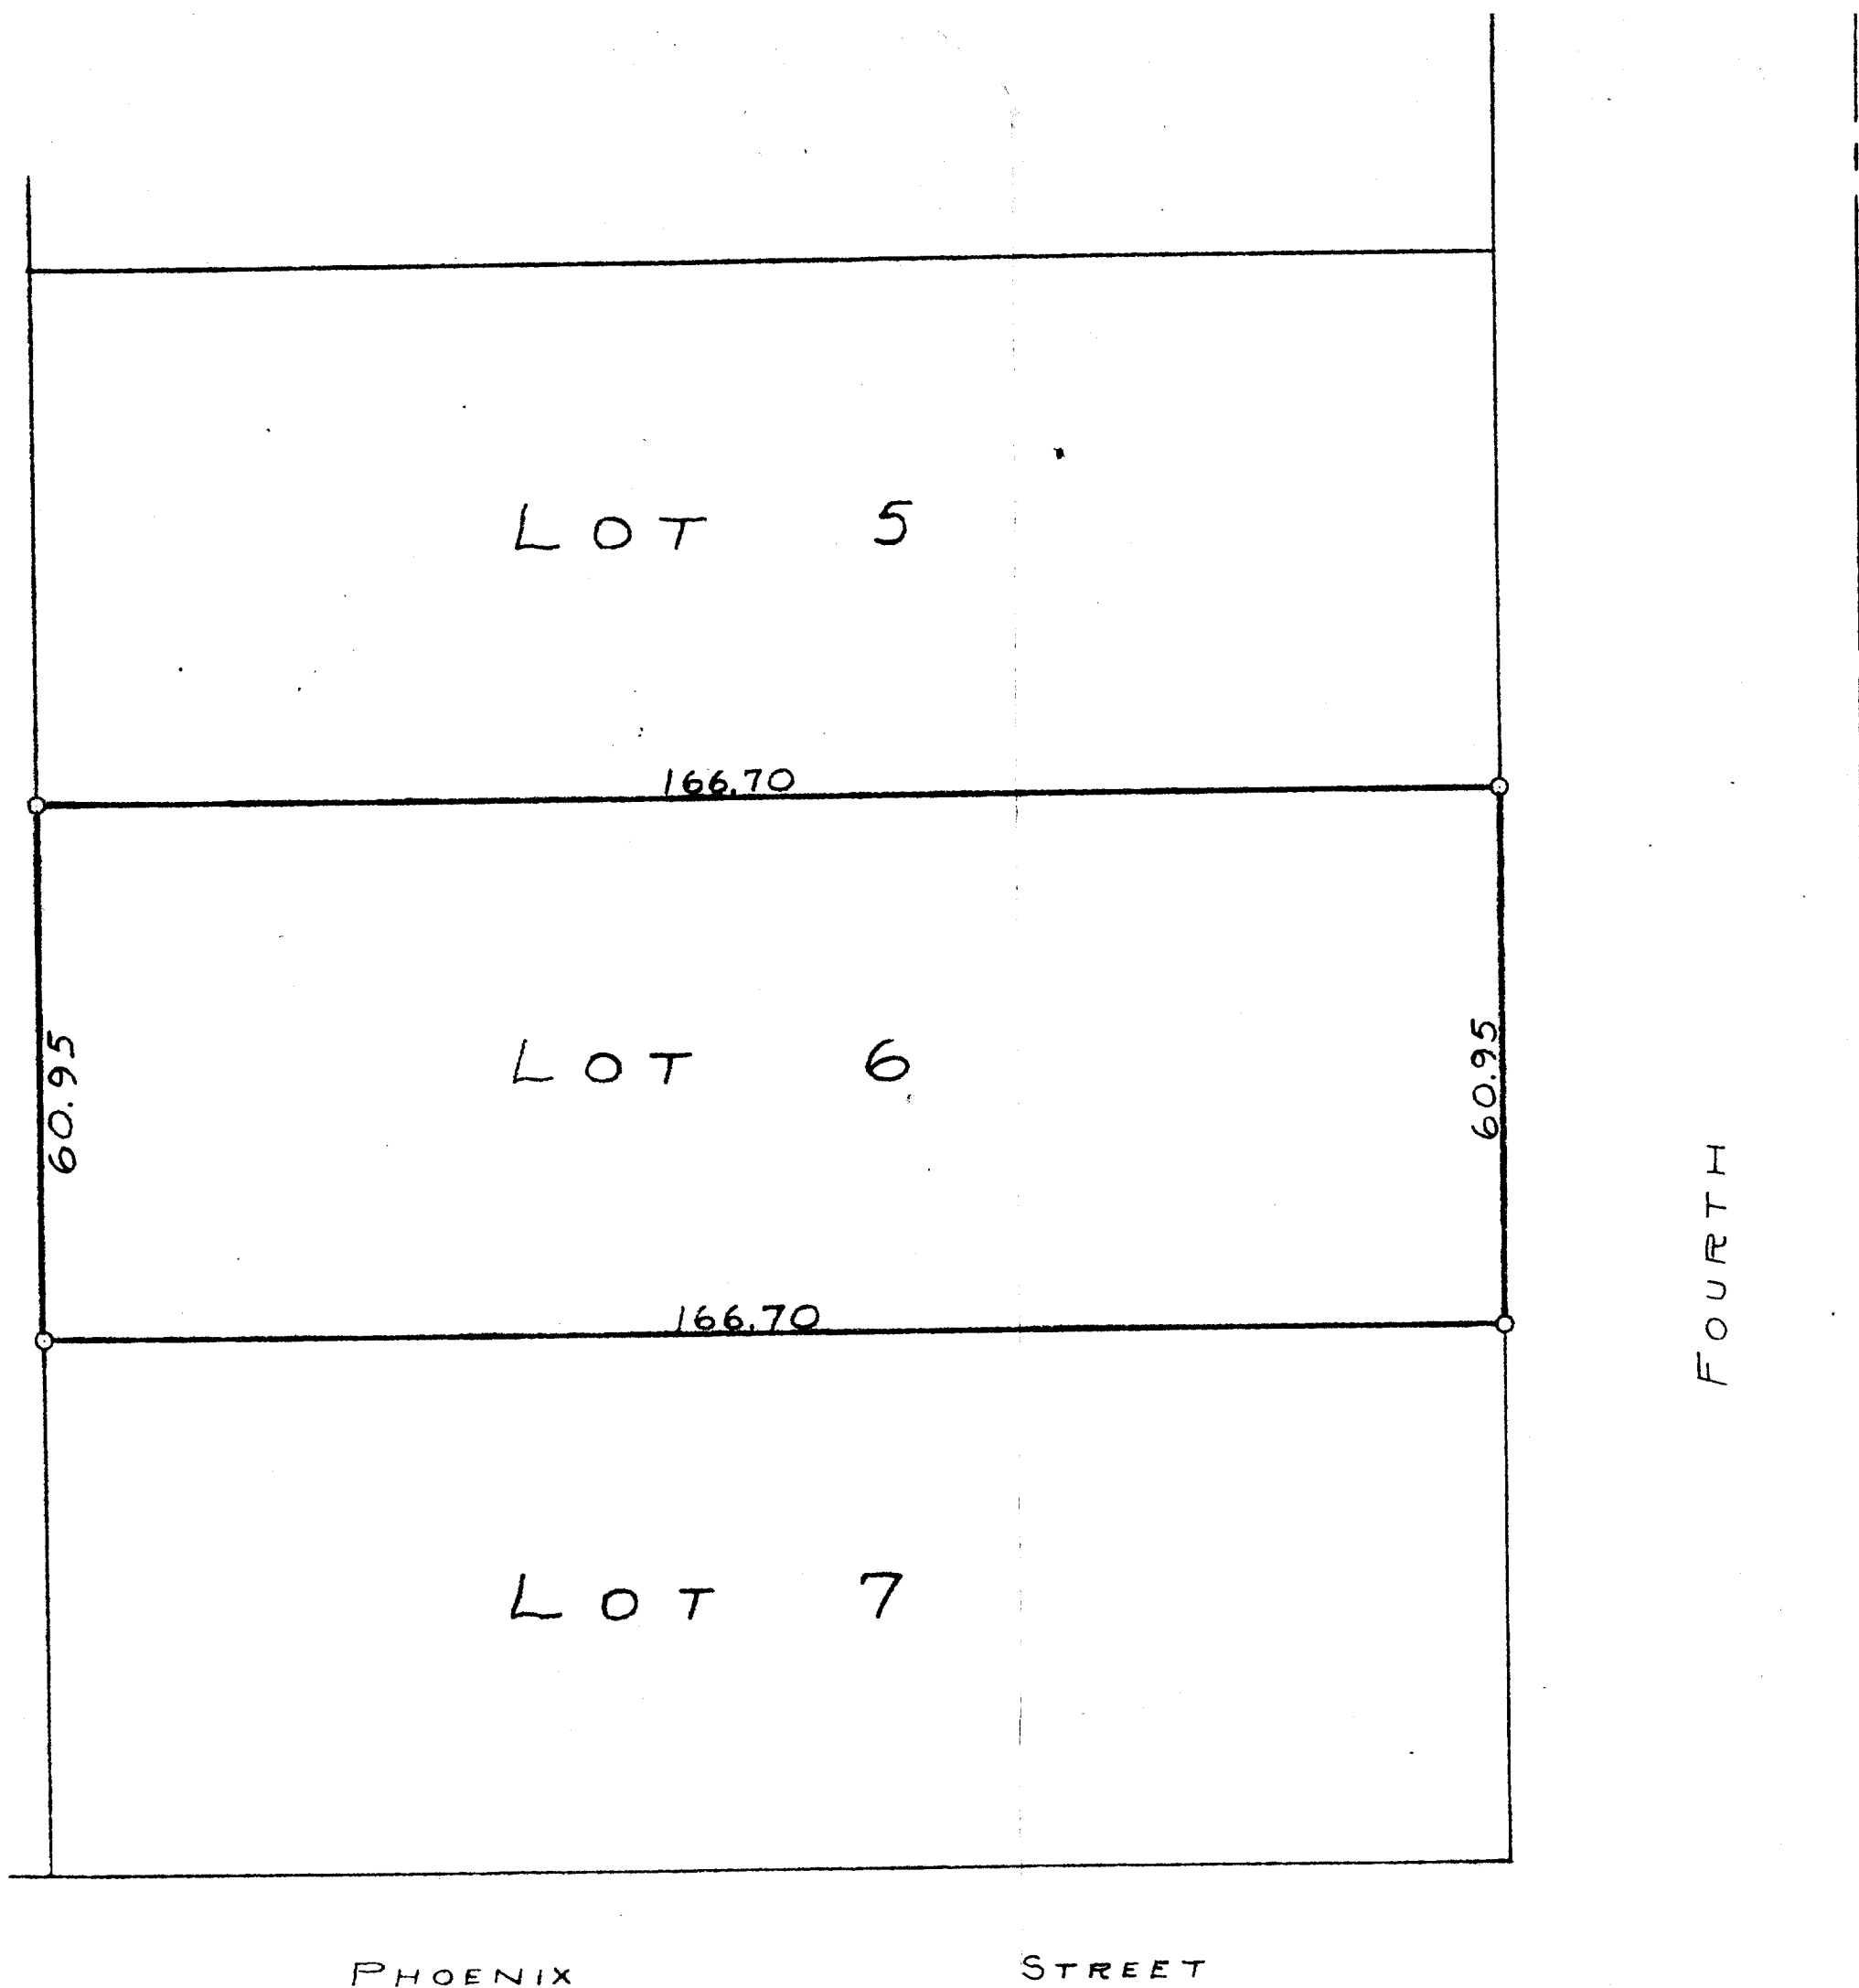

STATE OF WISCONSIN)SS
COUNTY OF WALWORTH)

I, GEORGE T. DUNHAM, DO HEREBY CERTIFY THAT I HAVE SURVEYED
THE PROPERTY DESCRIBED AS FOLLOWS:

LOT 6, BLOCK 2, SARAH A. PHOENIX ADDITION LOCATED
IN THE CITY OF DELAVAN, WALWORTH COUNTY, WISCONSIN
AND THAT THE PLAT SHOWN ABOVE IS A CORRECT REPRESENTATION OF THE
PROPERTY LINES

George T. Dunham
GEORGE T. DUNHAM SURVEYOR
DELAVAN WISCONSIN