


V XV-123

Washington Street



# Plat of Survey

of  
**Lot 7 of Block 2 of Sunset View Subdivision,**  
located in the Southwest 1/4 of Section 18, Town 2 North,  
Range 16 East, City of Delavan, Walworth County, Wisconsin.

Surveyed for: **Hibl's Real Estate Sales, Inc.**  
1034 B Ann Street  
Delavan, Wisconsin. 53115

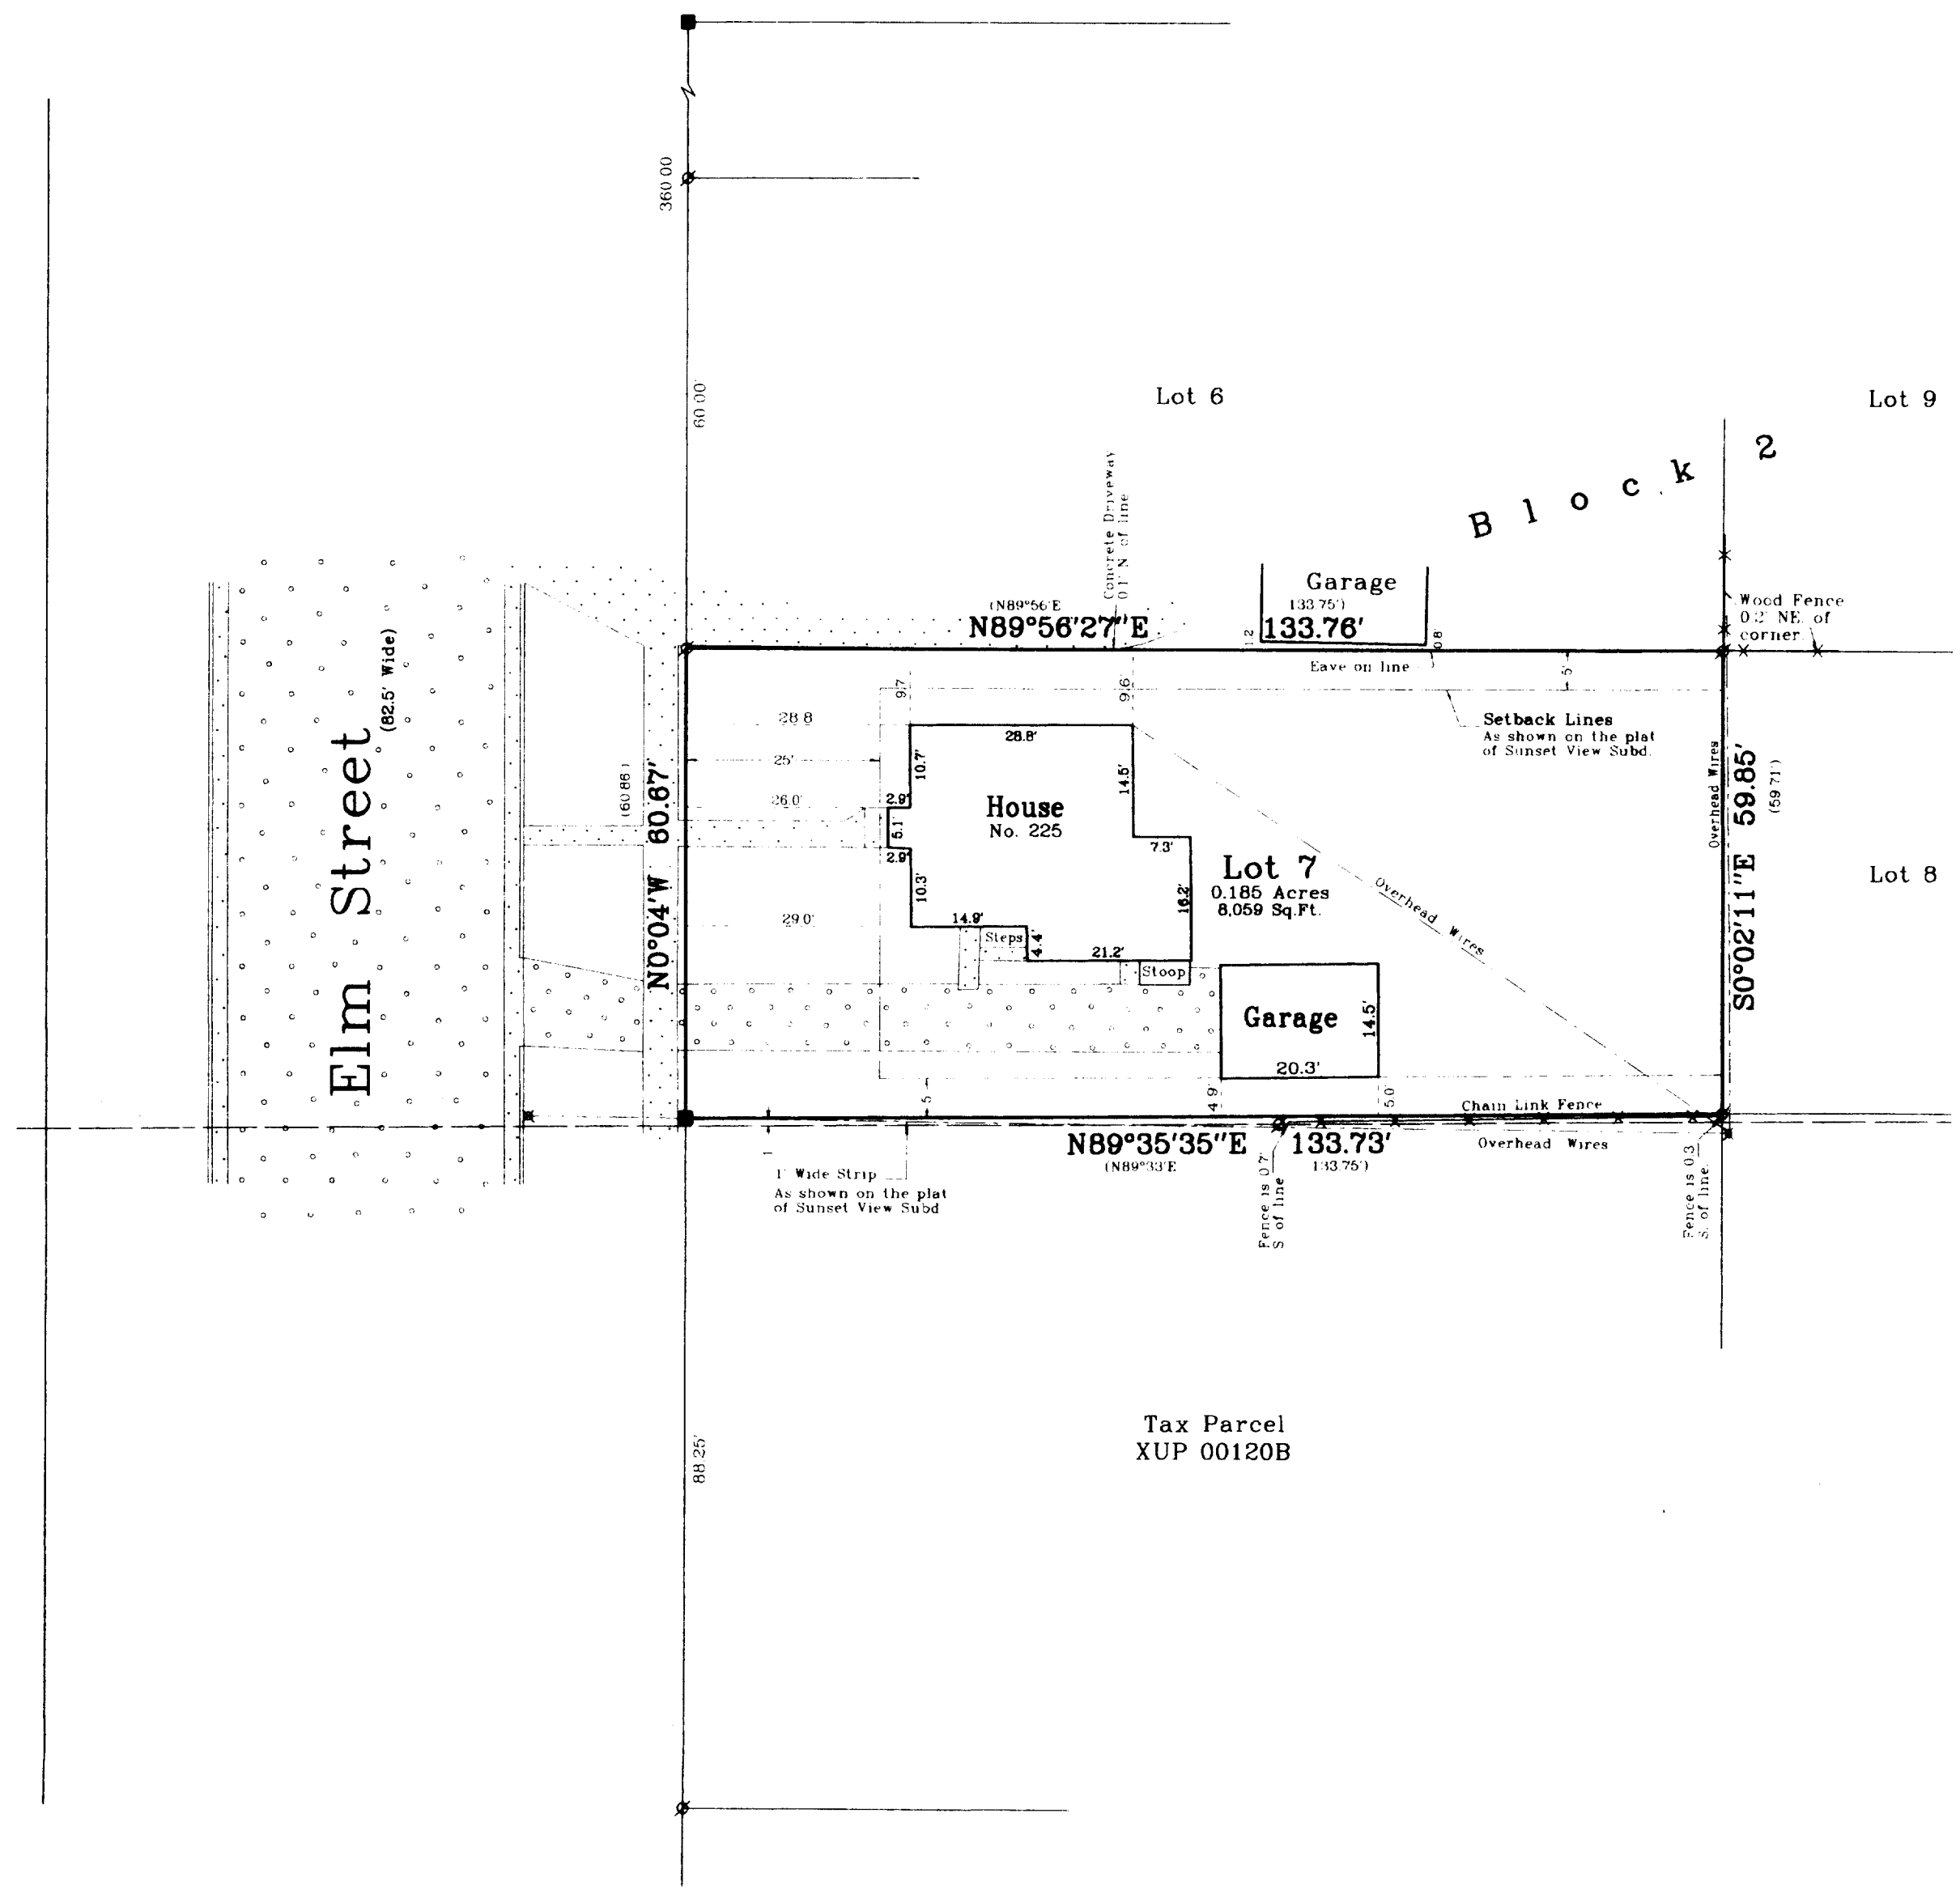

Tax Parcel  
XUP 00120B

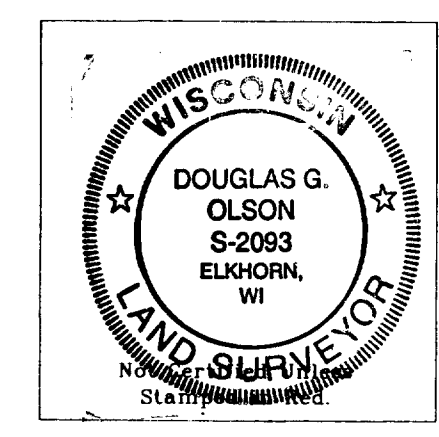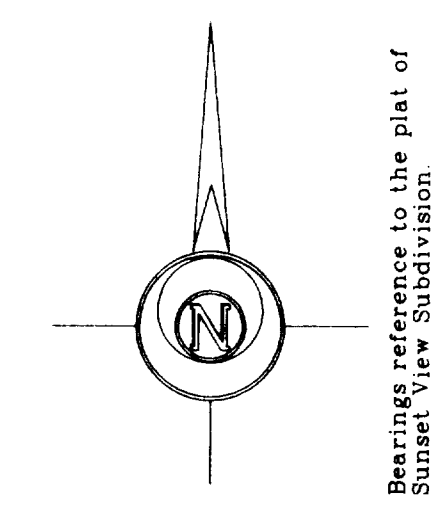

- Notes: 1) This survey plat is not certified unless signed and sealed in red ink.  
2) This survey is subject to Wisconsin lien laws. This Plat of Survey is the notice of intent to file lien. Lien waiver required.

Copyright © 2001 by Jensen & Olson Land Surveying, LLC.  
All rights reserved. No part of this survey plat may be reproduced or transmitted in any form by any means - graphic, electronic, or mechanical, including photocopying, tracing, or information storage and retrieval systems - without permission in writing from Douglas G. Olson, Jensen & Olson Land Surveying, LLC.  
I hereby certify that I have surveyed the above described property and the map hereon is correct to the best of my professional knowledge and belief and shows the size and location of the property, its exterior boundaries, the location and dimensions of all visible structures thereon, boundary fences, apparent easements and roadways and visible encroachments, if any.  
This survey is made for the exclusive use of the present owners of property, and also those who purchase, mortgage or guarantee title thereto, within one year from the date hereof.  
Douglas G. Olson  
Wisconsin Registered Land Surveyor - 2093

|                                                                                                                                                                             |                                                                |
|-----------------------------------------------------------------------------------------------------------------------------------------------------------------------------|----------------------------------------------------------------|
| Survey Date: October 12, 2001.<br>Revisions:                                                                                                                                |                                                                |
| Scale in Feet<br>1" = 20'<br>0' 10' 20' 40'                                                                                                                                 |                                                                |
| <b>Jensen &amp; Olson Land Surveying, LLC</b><br>45 South Wisconsin Street P.O. Box 322<br>Elkhorn, Wisconsin 53121<br>Telephone (262) 723-3434<br>Facsimile (262) 723-8044 |                                                                |
| Legend<br>Found Concrete Monument<br>Found Iron Pipe<br>Recorded Information<br>Utility Pole<br>Concrete Surface<br>Asphalt Surface                                         | Sheet 1 of 1 Sheets<br>Job Reference Number<br><b>2001.140</b> |
| 2001.140                                                                                                                                                                    |                                                                |