


GEORGE T. DUNHAM
SURVEYING & SUBDIVIDING
DELAVAN, WISCONSIN

N

Scale - 1" = 20'
O = Iron Pipe

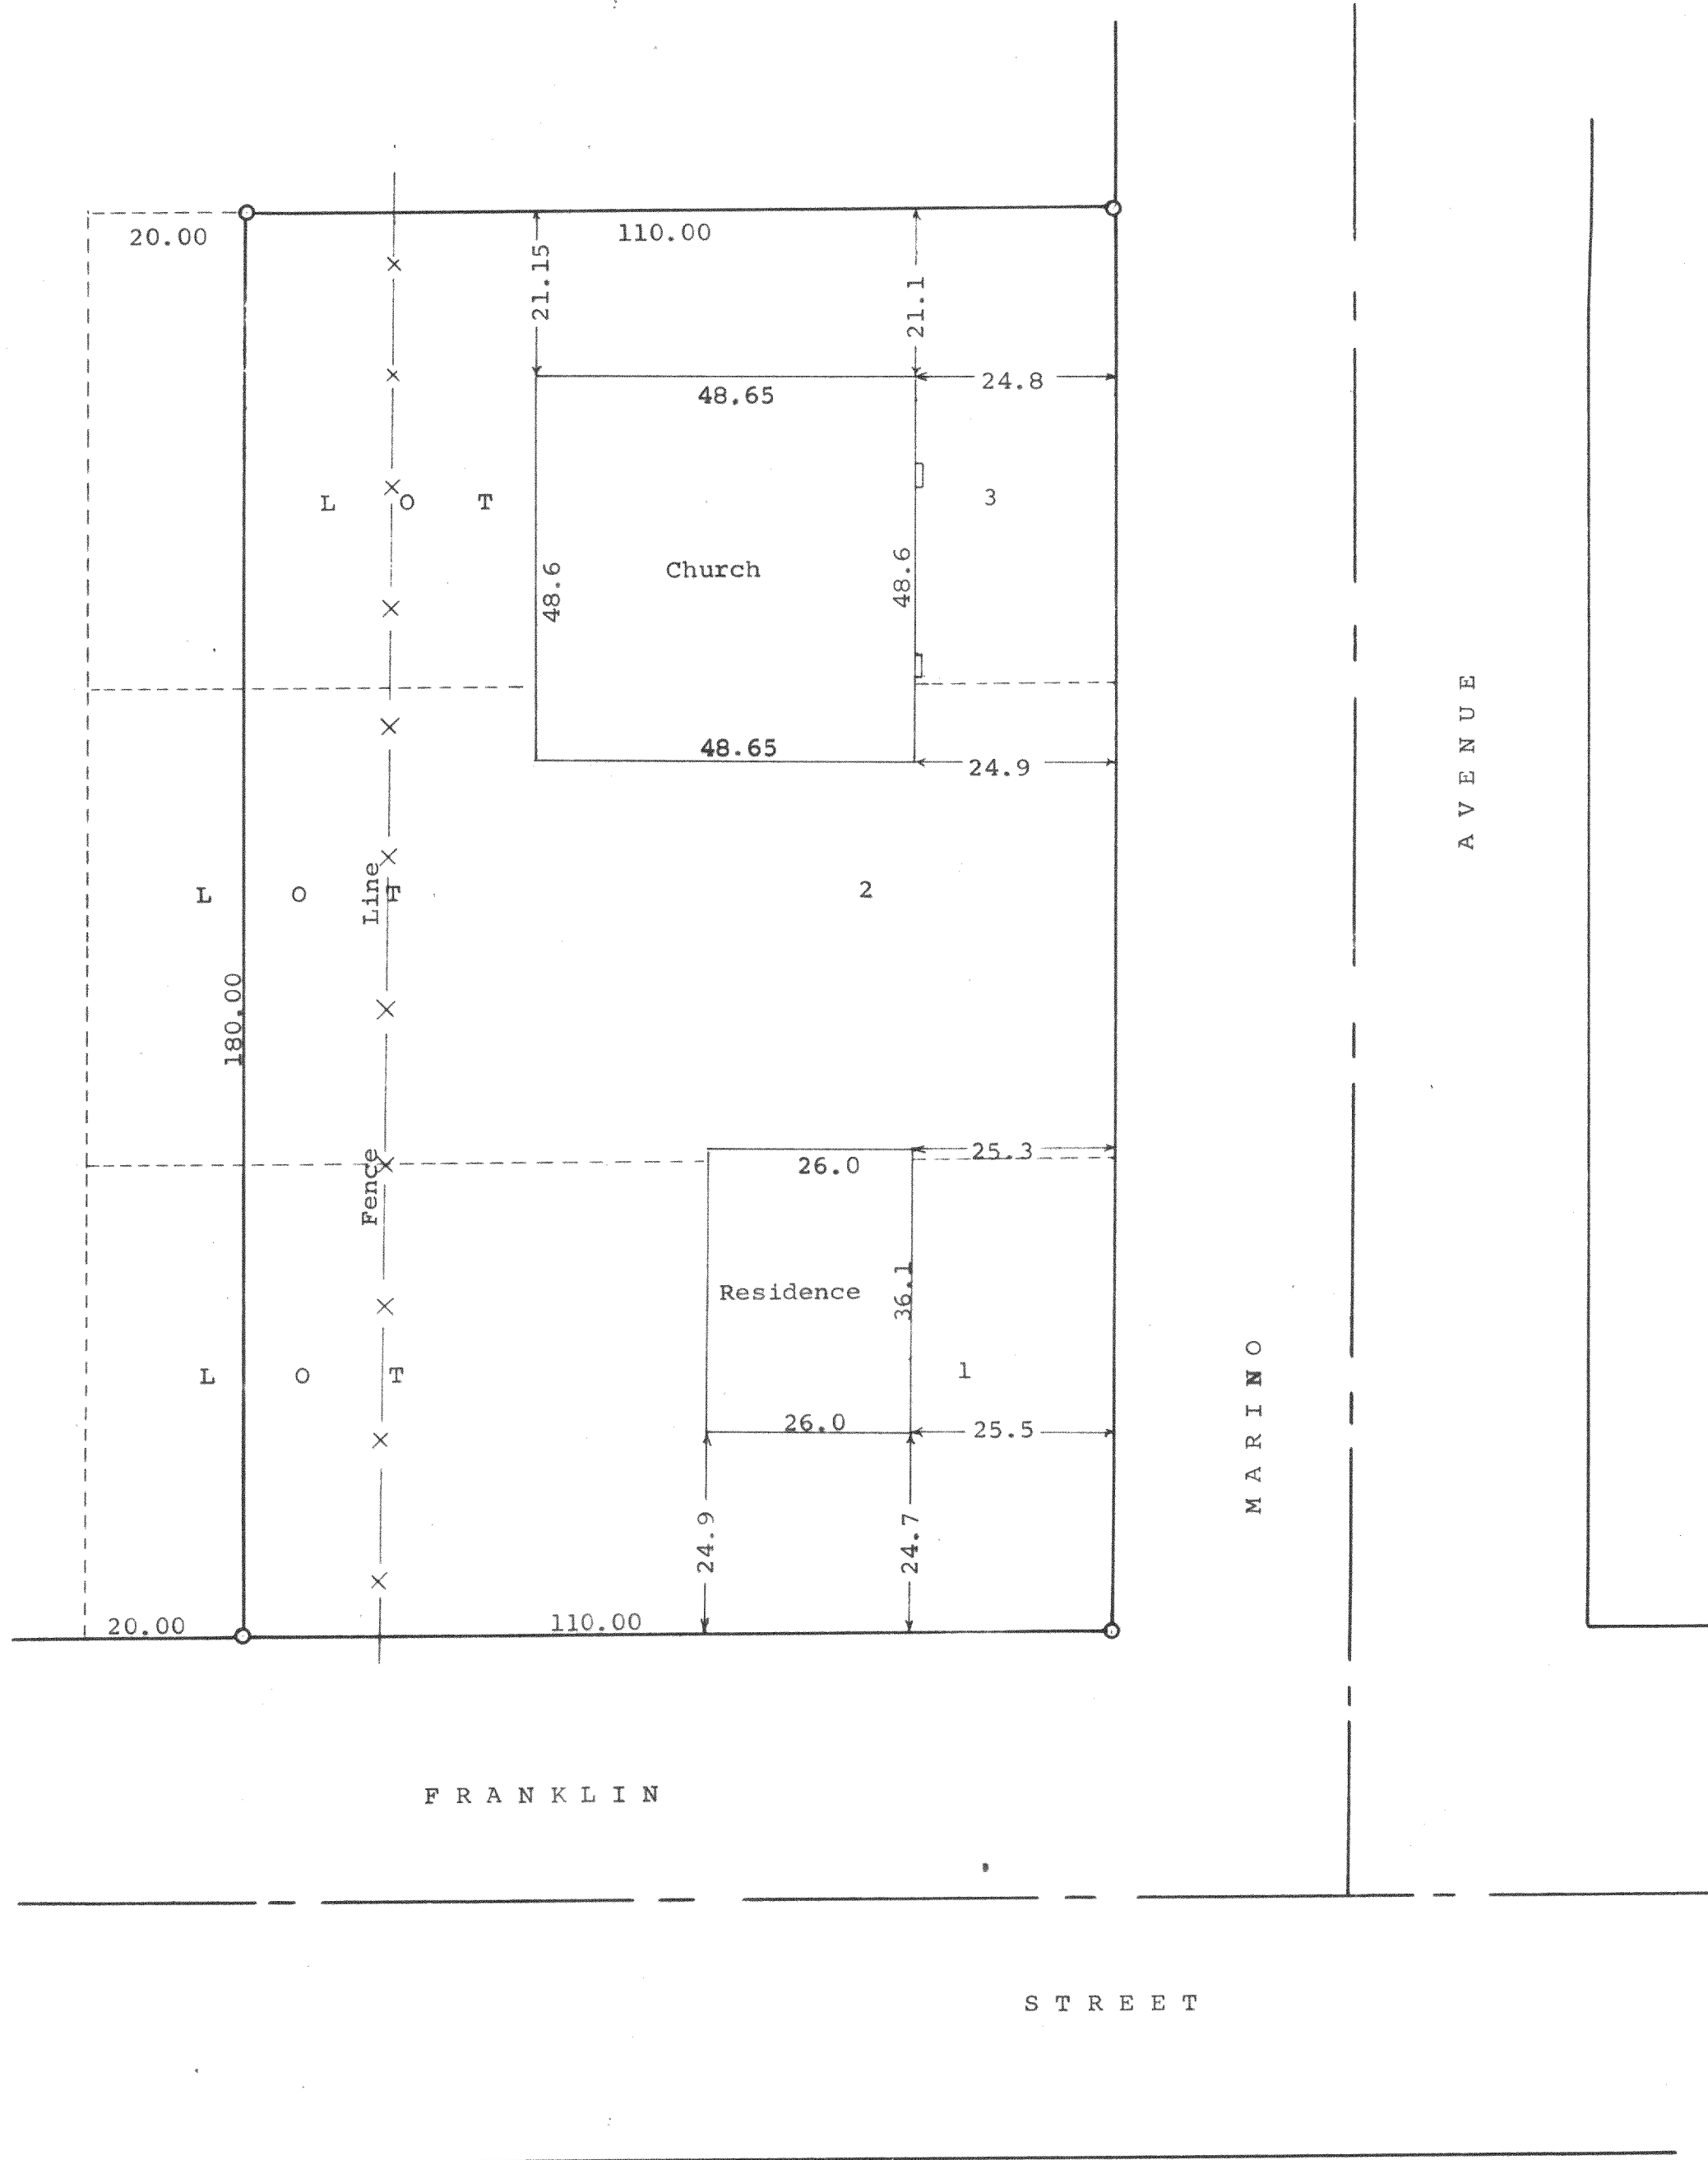

STATE OF WISCONSIN)
WALWORTH COUNTY) SS

I, George T. Dunham, surveyor do hereby certify that I have surveyed the property described as follows,

The East 110.00 feet of Lots 1, 2, and 3 of Mar-Del Estates located in City of Delavan, Walworth County, Wisconsin and that the above plat is an accurate survey and a true representation thereof and correctly shows the exterior boundary lines and location of buildings and improvements on said property and the correct measurements thereof.

November 5, 1963
Revised August 22, 1964

George T. Dunham
George T. Dunham, Surveyor