


DUNHAM SURVEYING, S.C.
SURVEYING & SUBDIVIDING
DELAN, WISCONSIN 53115

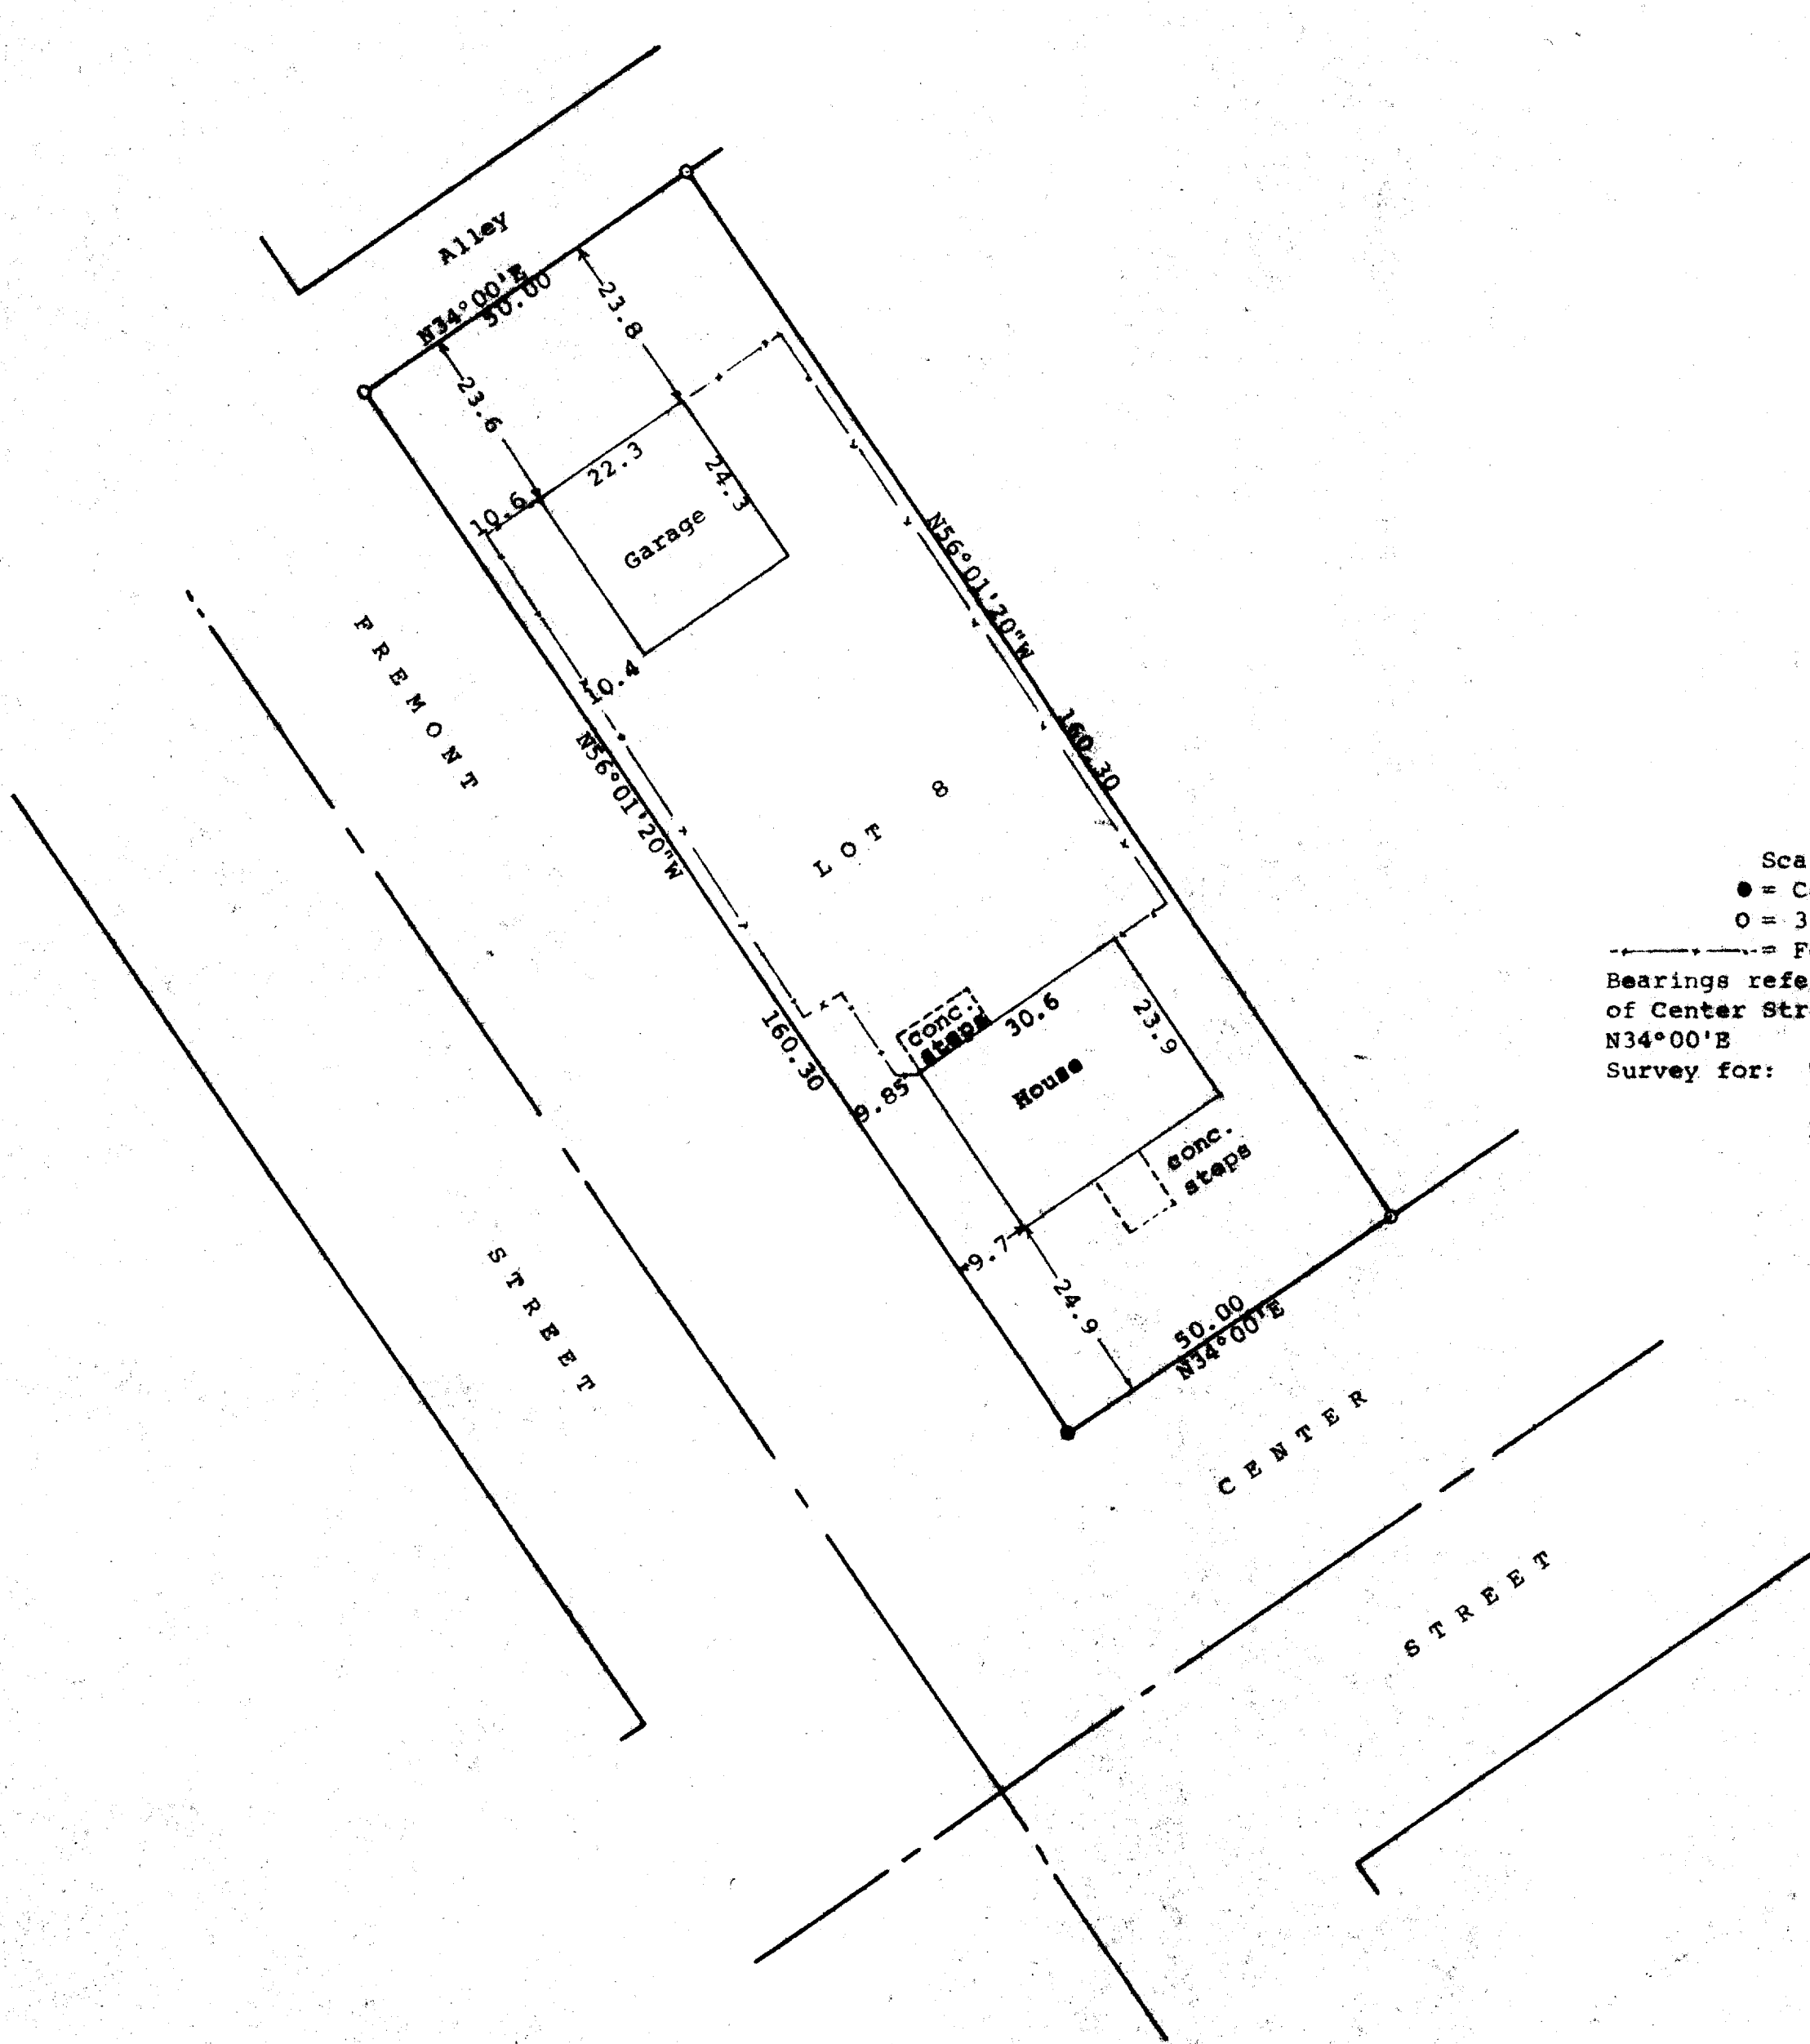

Scale - 1" = 20'
● = Concrete Monument Found
○ = 3/4" Iron Pipe Found
--- = Fence Line
Bearings referenced to the northerly line
of Center Street with the assumed bearing of
N34°00'E
Survey for: Terrance & Sally Walsh
1005 Center Street
Delavan, WI 53115

STATE OF WISCONSIN) SS
COUNTY OF WALWORTH)


I, George T. Dunham, Surveyor, certify that I have surveyed the
property described as follows:

Lot 8 in Block 2 of Delavan Subdivision located in the City of
Delavan, Walworth County, Wisconsin,

and that the plat shown above is a correct representation thereof and shows
the size and location of the property, its exterior boundaries, the location
of all visible structures and dimensions of all principal buildings thereon,
boundary fences, apparent easements, roadways and visible encroachments, if
any, and that I have surveyed the property hereon described, according to the
official records, to the best of my knowledge and belief.

August 17, 1998

George T. Dunham
George T. Dunham, Surveyor

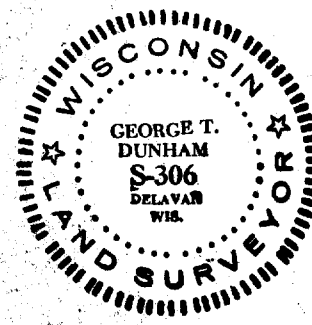

9200

SRP