

DUNHAM SURVEYING, S. C.

SURVEYING & SUBDIVISION
DELAVER, WISCONSIN 53115

N


WASHINGTON

Scale - 1" = 20'
● = Concrete Monument
⊙ = Iron Pipe Found
○ = Iron Pipe Set
(0.00) = Recorded Distance

STREET

STREET

MAIN

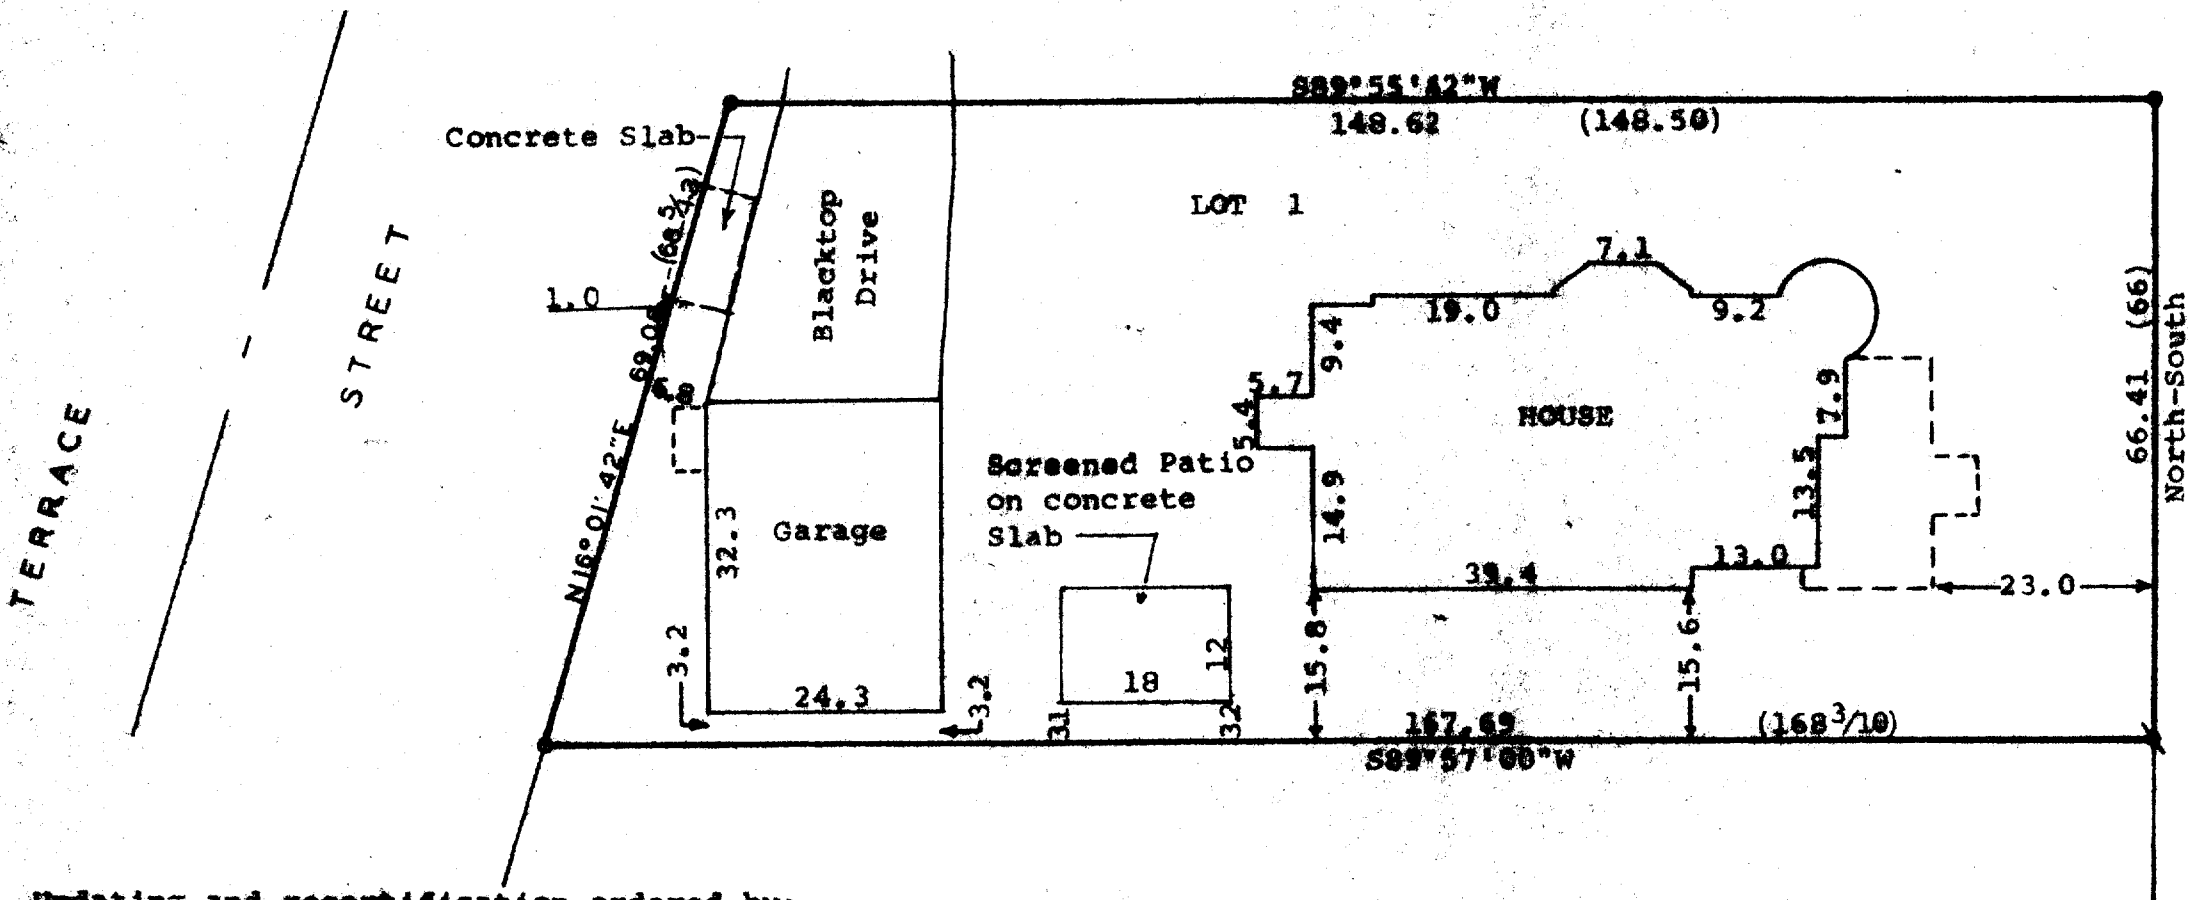

Updating and recertification ordered by:
Professional Realty
1155 East Geneva Street
Delavan, Wisconsin, 53115
Note: Bearings are based on the
West line of Main Street,
assumed bearing is North.

STATE OF WISCONSIN)
COUNTY OF WALWORTH)

I, James M. Dunham, Surveyor, certify that I have surveyed
the property described as follows,
Lot 1 of Block 16 of the Original Plat of the Village (now
City) of Delavan, Walworth County, Wisconsin,
and that the above map is a true representation thereof and shows the
size and location of the property, its exterior boundaries, the location
of all visible structures and dimensions of all principal buildings
thereon, boundary fences, apparent easements, roadways and visible
encroachments, if any.
This survey is made for the use of the present owners of the property,
and also those who purchase, mortgage, or guarantee the title thereto
within one (1) year from date hereof.

May 4, 1982
Updated and recertified to
this 21st day of August, 1997

James M. Dunham
James M. Dunham, Surveyor

George T. Dunham
George T. Dunham, Surveyor

RECEIVED
MAY 9 2000

DRD

