


DUNHAM SURVEYING, S.C.
SURVEYING & SUBDIVIDING
DELAVER, WISCONSIN 53115

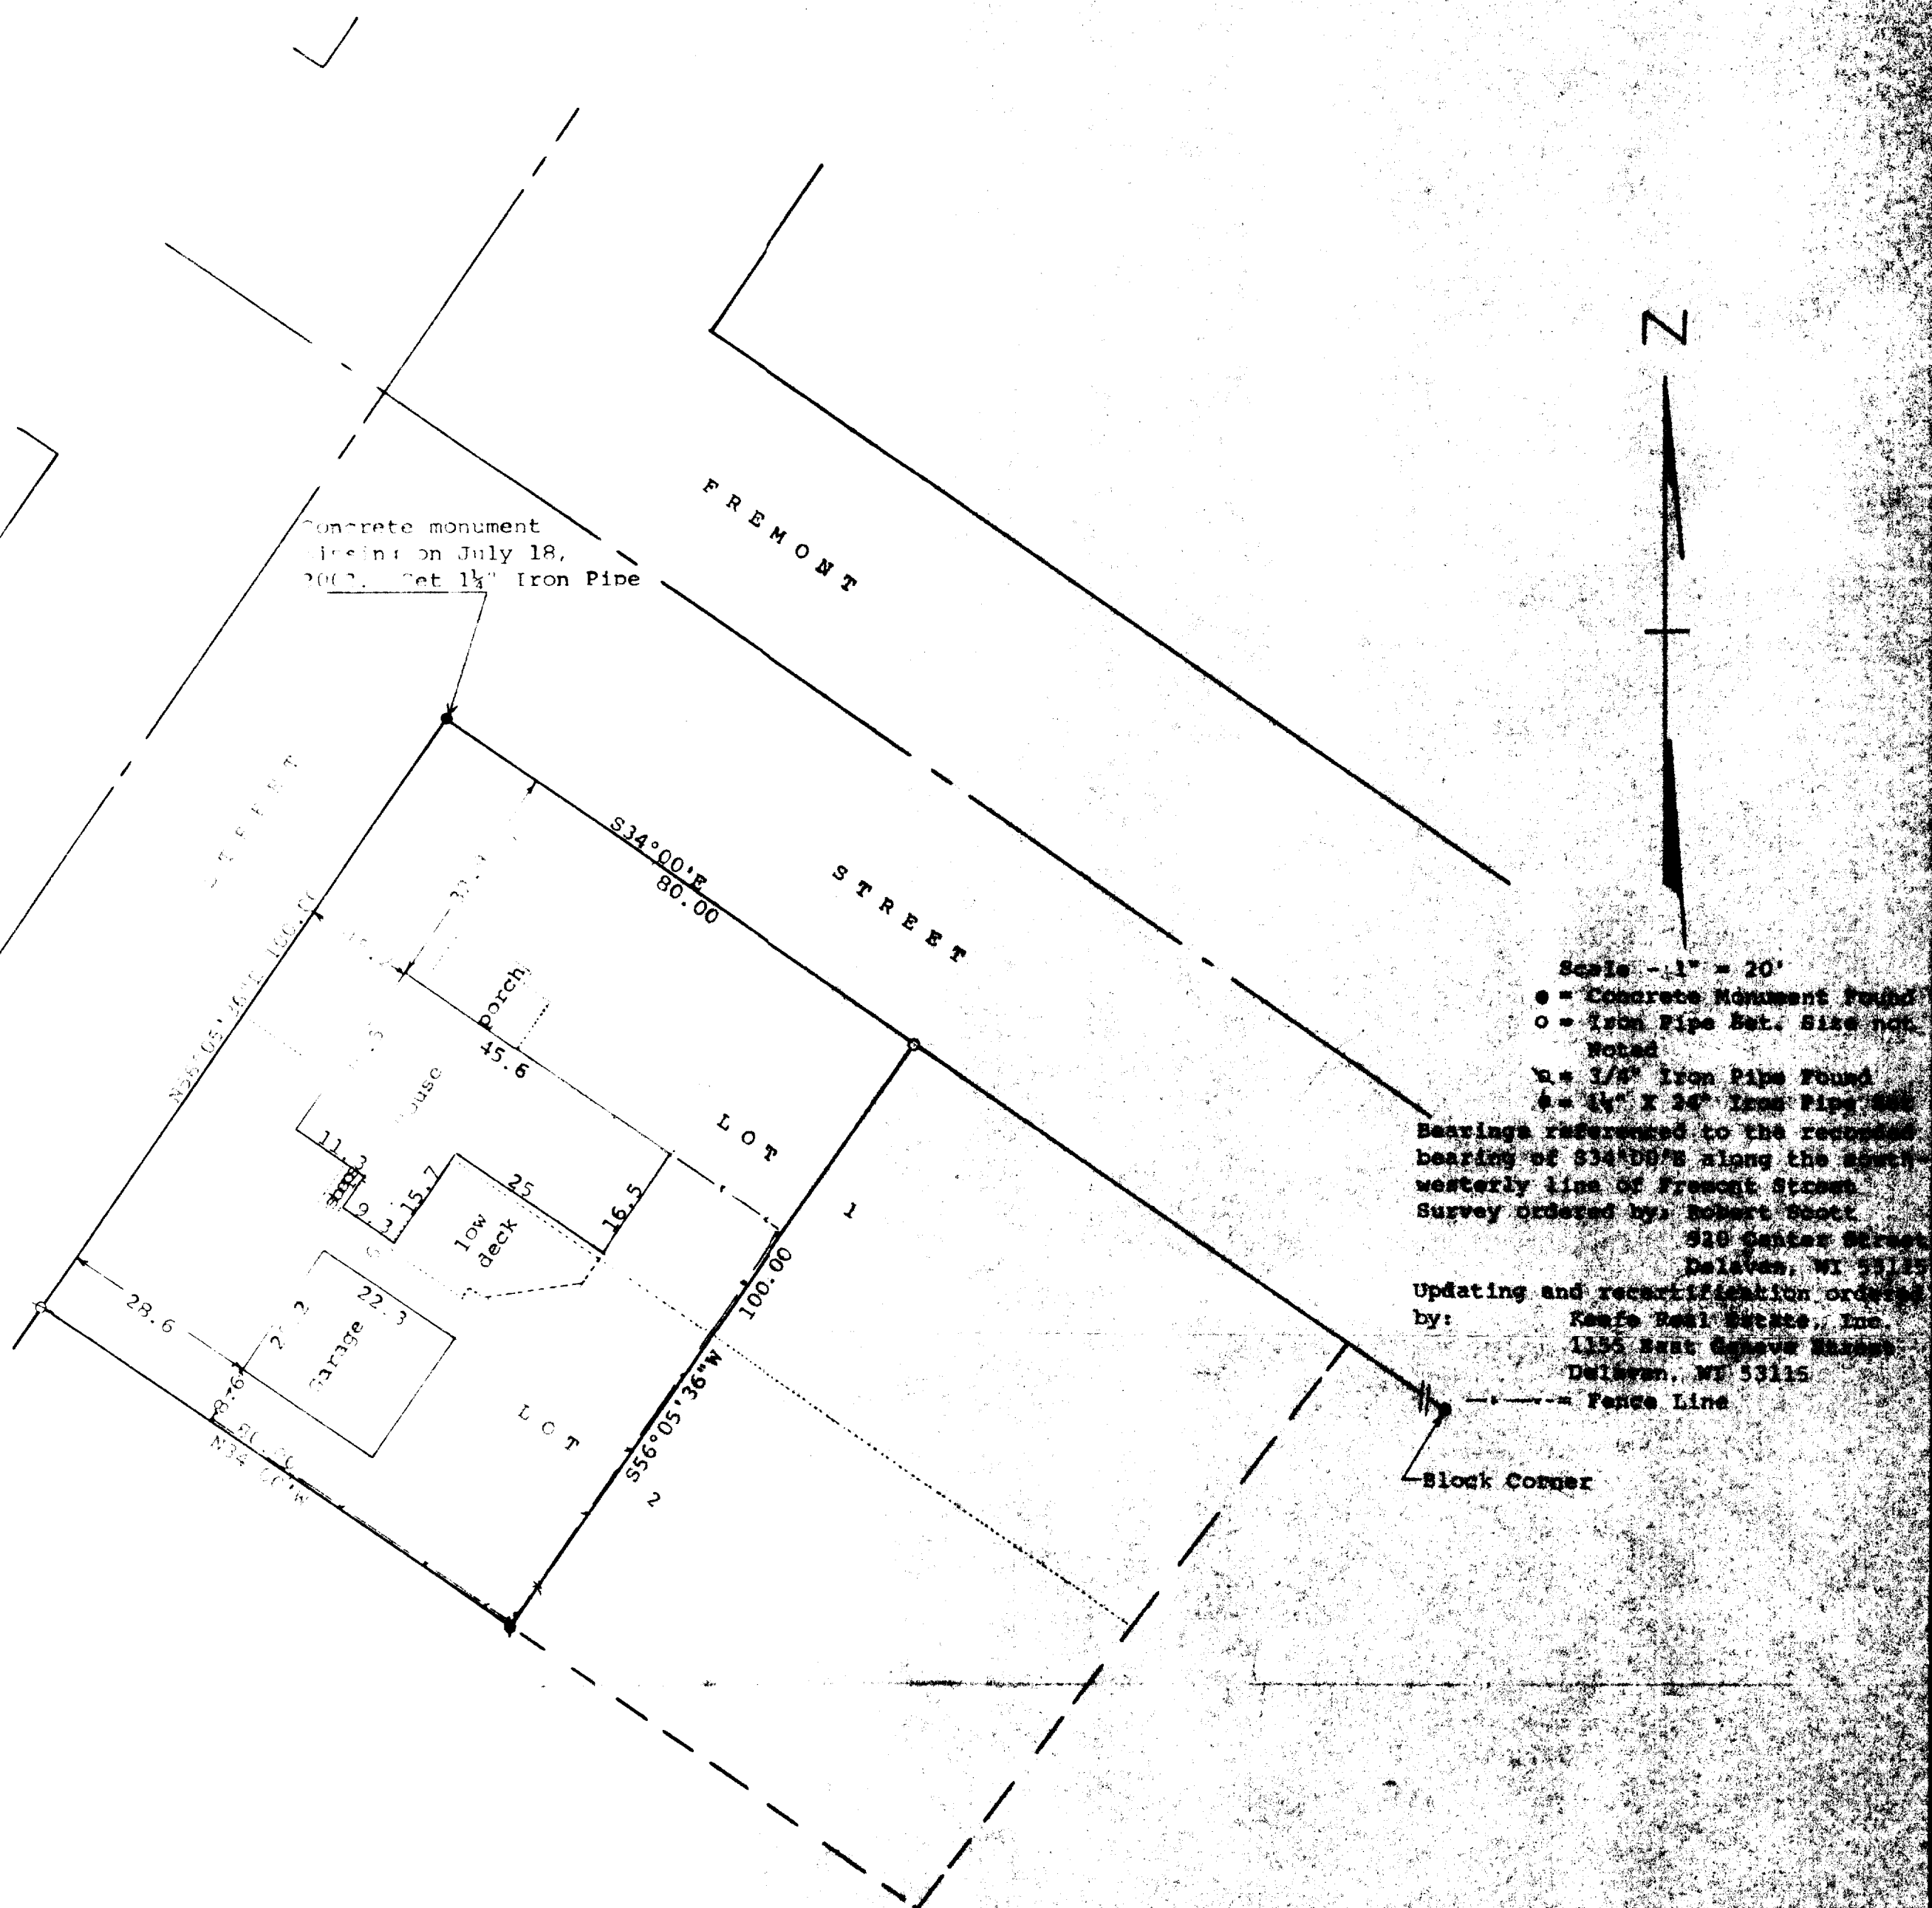

STATE OF WISCONSIN) SS
COUNTY OF WALWORTH)

I, George T. Dunham, Surveyor, certify that I have surveyed the
property described as follows:

A part of Lots 1 and 2 in Block 5 of Converse's Subdivision
located in the City of Delavan, Walworth County, Wisconsin,
described as follows: Beginning at the most northerly corner
of said Lot 1; thence S34°00'E along the northeasterly line of
said Lot 1, 80.00 feet; thence S56°05'36"W, parallel with the
northwesterly line of said Lots 1 and 2, 100.00 feet to the
southwesterly line of said Lot 2; thence N34°00'W along said
southwesterly line 80.00 feet to the most westerly corner of
said Lot 2; thence N56°05'36"E 100.00 feet to the place of
beginning.

and that the plat shown hereon is a correct representation thereof and shows
the size and location of the property, its exterior boundaries, the location
of all visible structures and dimensions of all principal buildings thereon,
boundary fences, apparent easements, roadways and visible encroachments, if
any, and that I have surveyed the property hereon described, according to the
official records, to the best of my knowledge and belief.

May 5, 1992

Updated and recertified to on
July 18, 2002

George T. Dunham, Surveyor

