


DUNHAM SURVEYING, S.C.
SURVEYING & SUBDIVIDING
DELAVER, WISCONSIN 53115

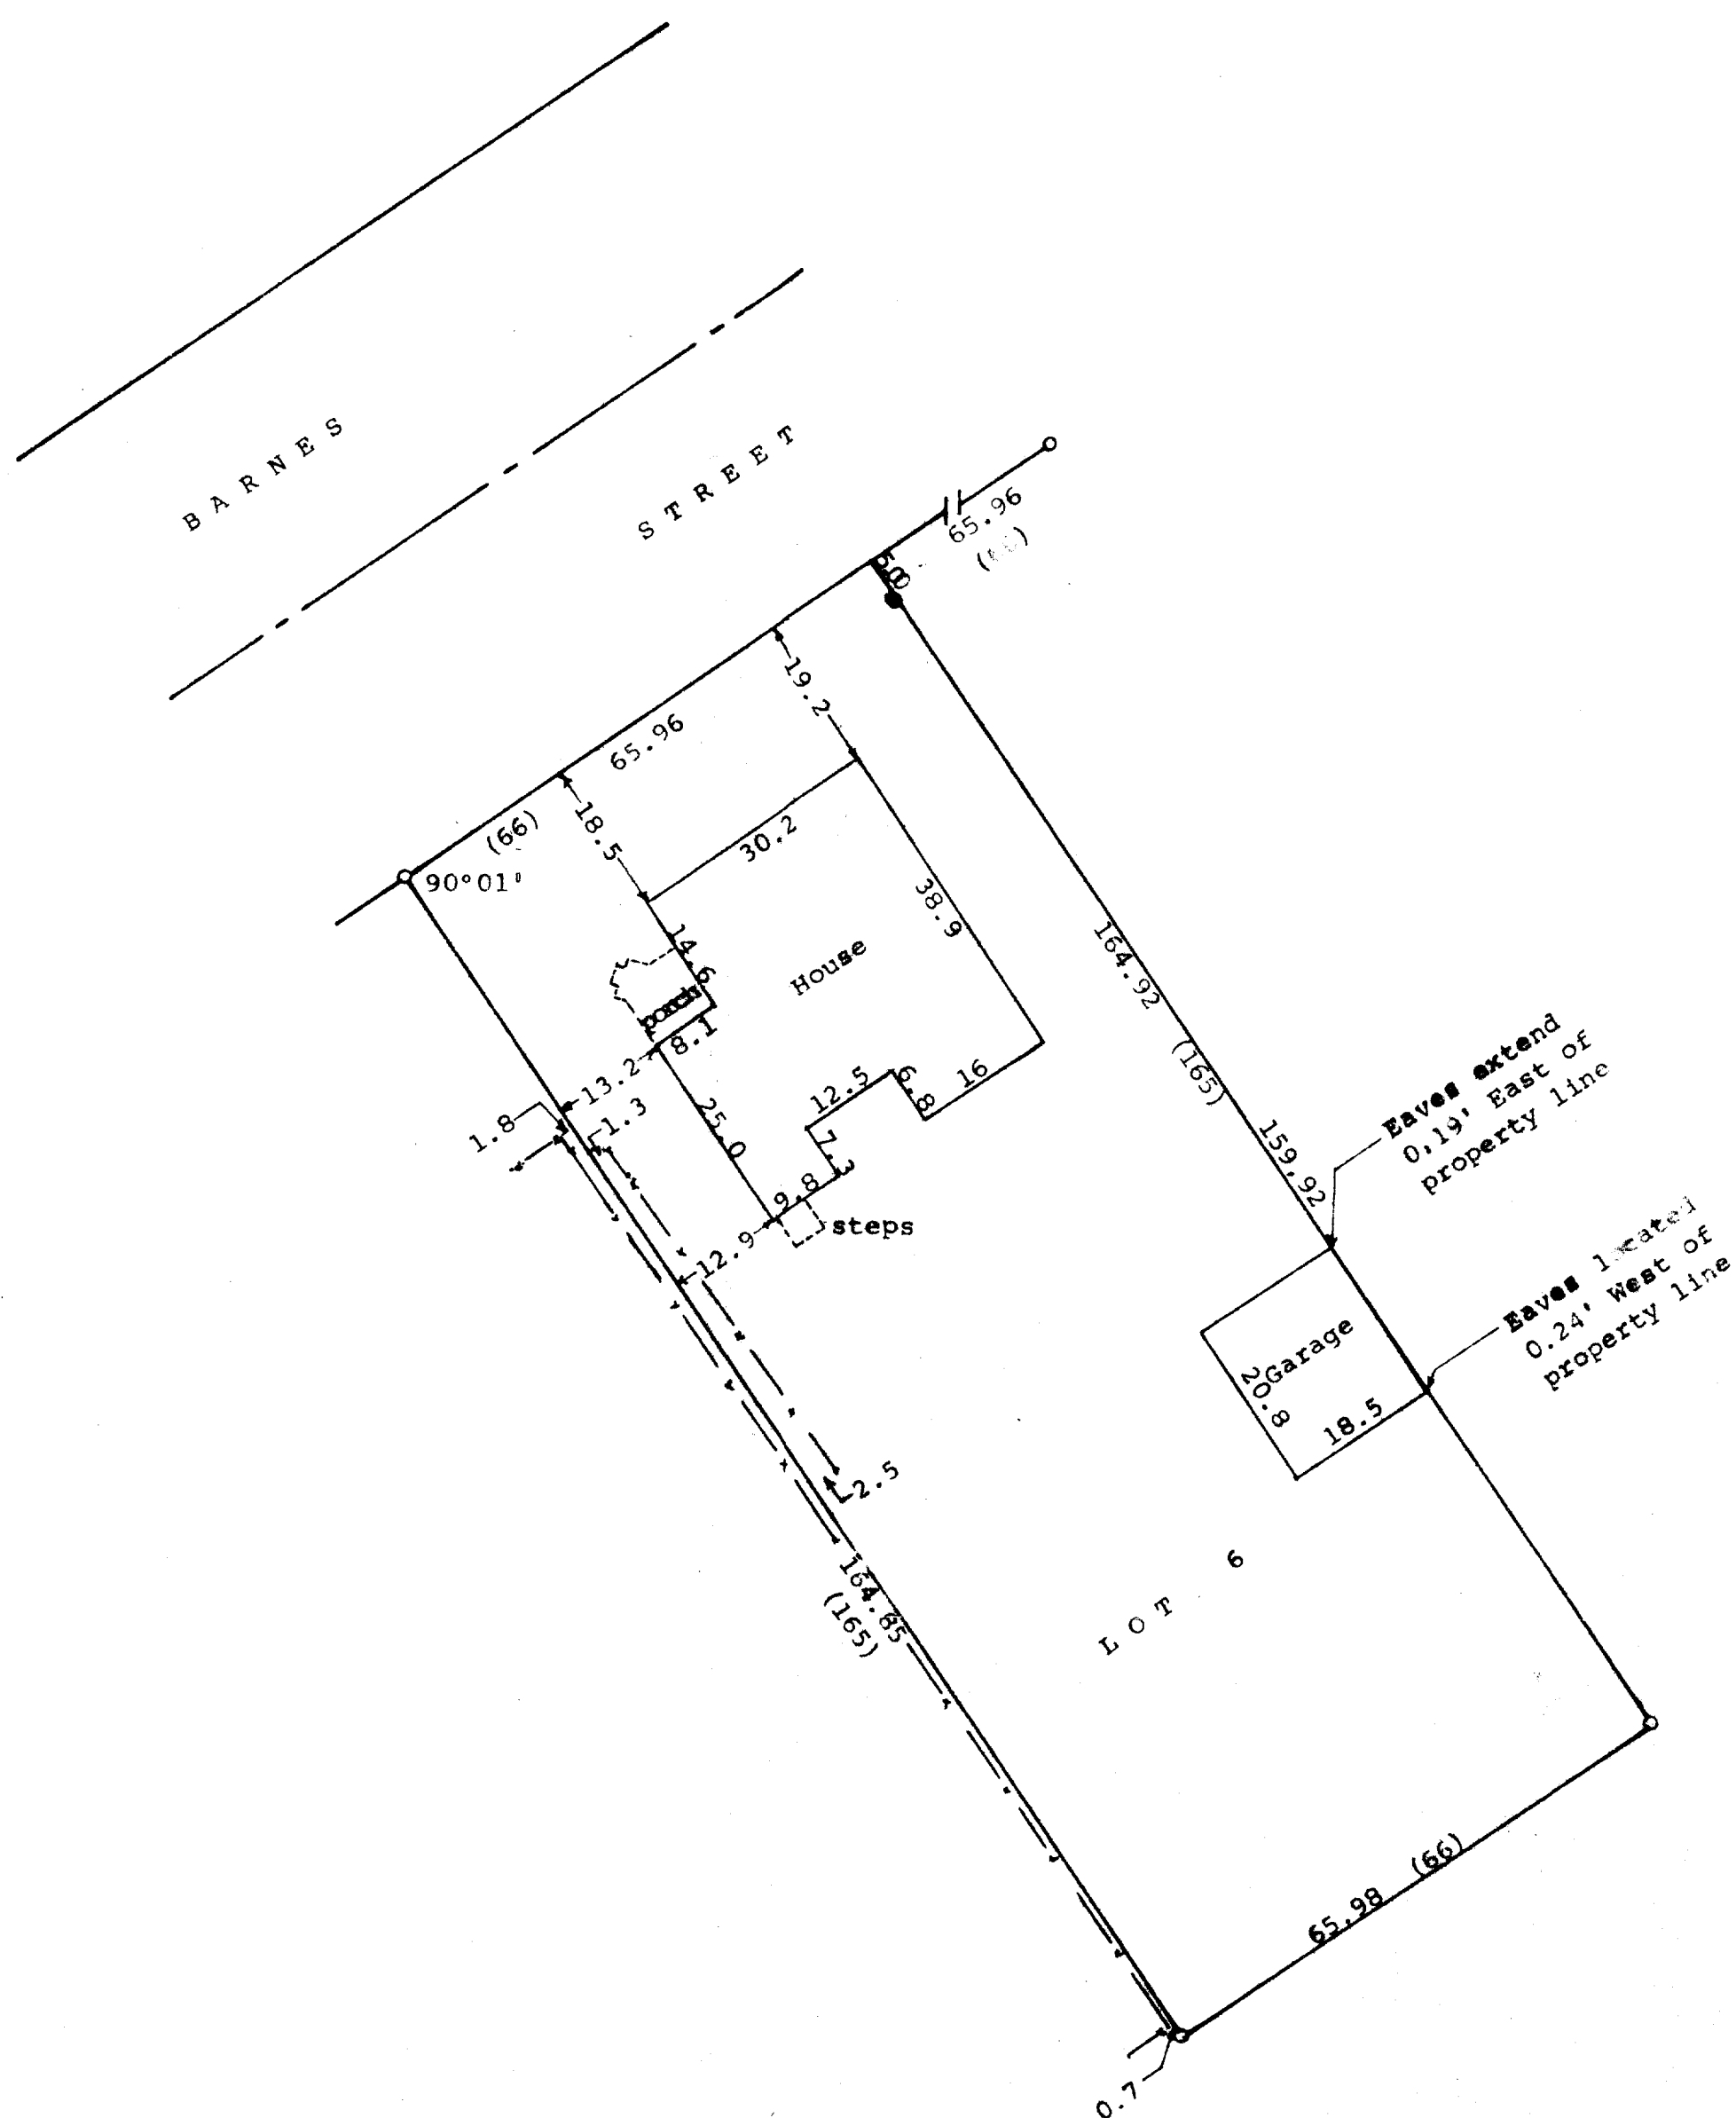

Scale - 1" = 20'
o = Iron Pipe Found
● = Iron Rod Set
--- = Fence Line
(0.0) = recorded distance
Survey ordered by:
Joyce Davis
317 South Main Street, Apt. 112
Delavan, WI 53115

STATE OF WISCONSIN) ss
COUNTY OF WALWORTH)

I, George T. Dunham, Surveyor, certify that I have surveyed the property described as follows:

Lot 6, Block 3 of Elmhurst Addition to the City of Delavan, Walworth County, Wisconsin

and that the map shown above is a correct representation thereof and shows the size and location of the property, its exterior boundaries, the location of all visible structures and dimensions of all principal buildings thereon, boundary fences, apparent easements, roadways and visible encroachments, if any, and that I have surveyed the property hereon described, according to the official records, to the best of my knowledge and belief.
June 4, 2001

George T. Dunham
George T. Dunham, Surveyor

