


GEORGE T. DUNHAM
SURVEYING & SUBDIVIDING
DELAVER, WISCONSIN

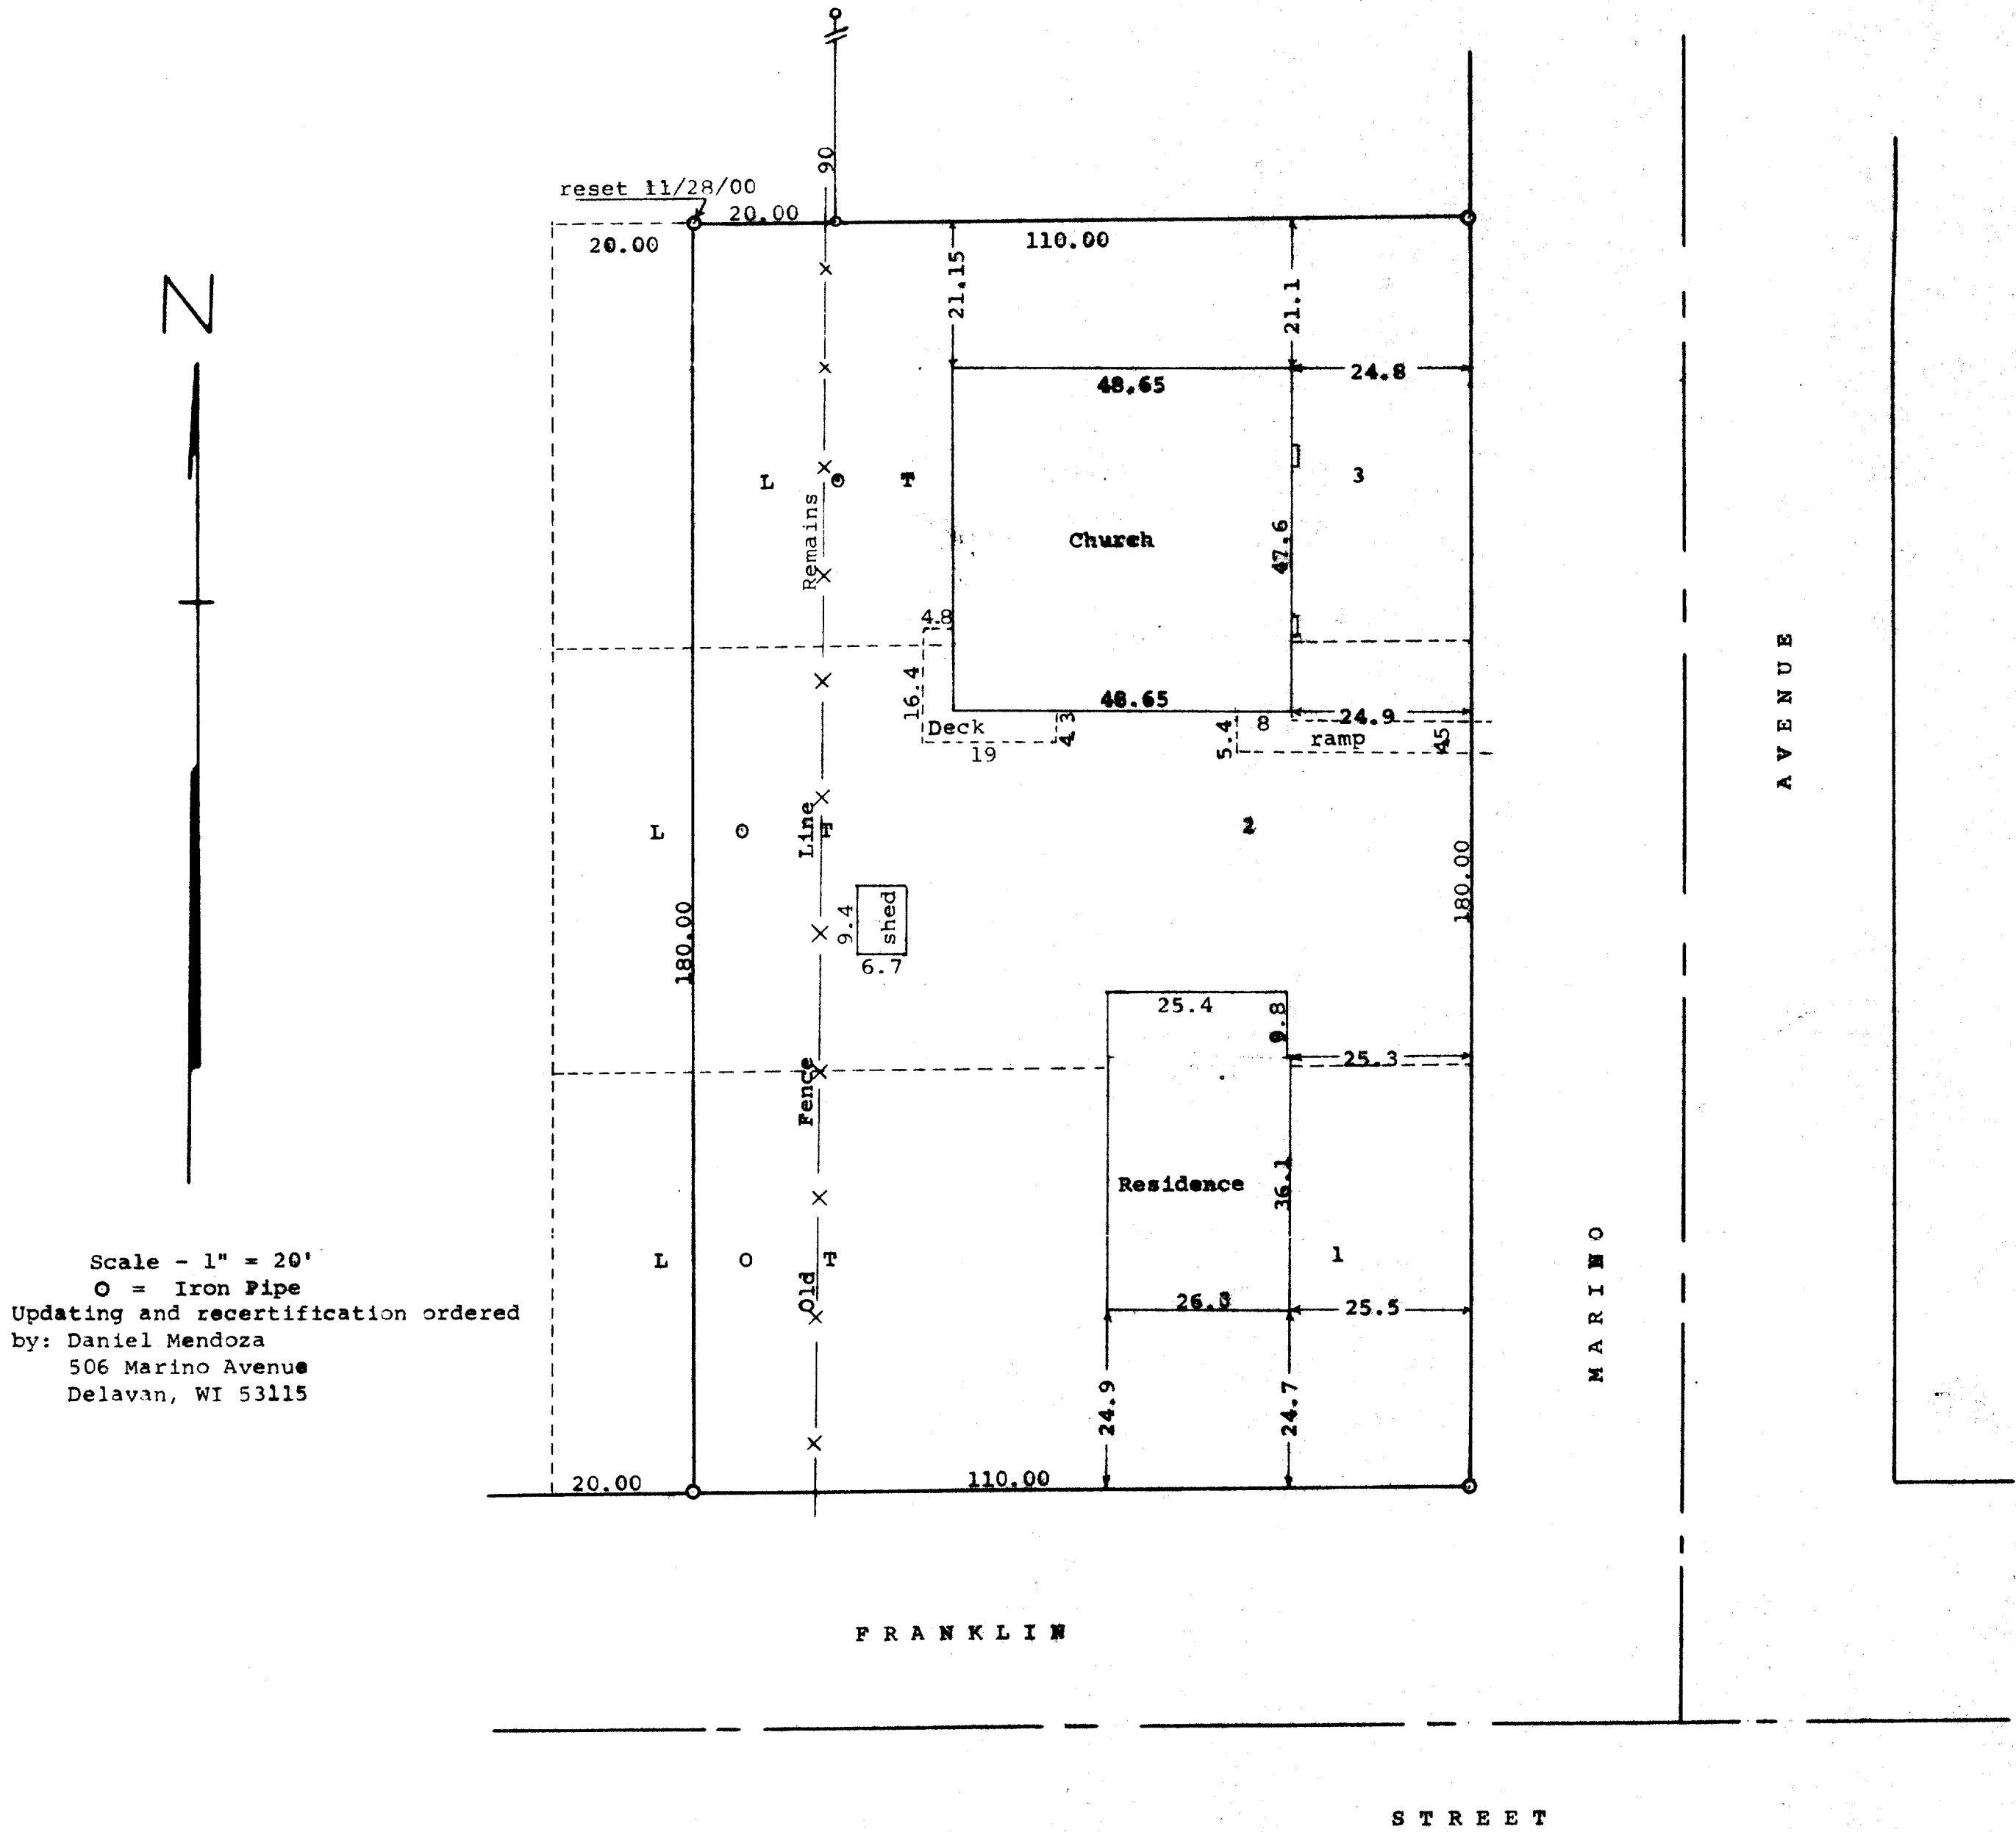

STATE OF WISCONSIN)
WALWORTH COUNTY) SS

I, George T. Dunham, surveyor do hereby certify that I have surveyed the property described as follows,

The East 110.00 feet of Lots 1, 2, and 3 of Mar-Del Estates located in City of Delavan, Walworth County, Wisconsin and that the above plat is an accurate survey and a true representation thereof and correctly shows the exterior boundary lines and location of buildings and improvements on said property and the correct measurements thereof.

November 5, 1963
Revised August 22, 1964
Updated & recertified to this 28th day of Nov. 2000

George T. Dunham
George T. Dunham, Surveyor

