


PLAT OF SURVEY

OWNER: MILLENNIUM DEVELOPMENT
PARTNERS II, LLC.
BUILDER: QUANTUM ENTERPRISES, LLC
N47 W27 585 LYNDALE RD
PEWAUKEE, WISCONSIN 53072


BUILDING 6 OF THE FIELDS OF DELAVAN, BEING A REDIVISION OF LOT 1
OF CERTIFIED SURVEY MAP NO. 2577, BEING PART OF THE SOUTHWEST
QUARTER (SW 1/4) OF SECTION 13, TOWN 2 NORTH, RANGE 15 EAST
CITY OF DELAVAN, WALWORTH COUNTY, WISCONSIN.

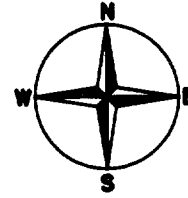

EXISTING GARAGE ELEVATION: 949.60

REFERENCE BEARING: ALL BEARINGS ARE REFERENCED TO GRID NORTH OF THE WISCONSIN STATE PLANE COORDINATE
SYSTEM SOUTH ZONE.

BIRCHWOOD STREET

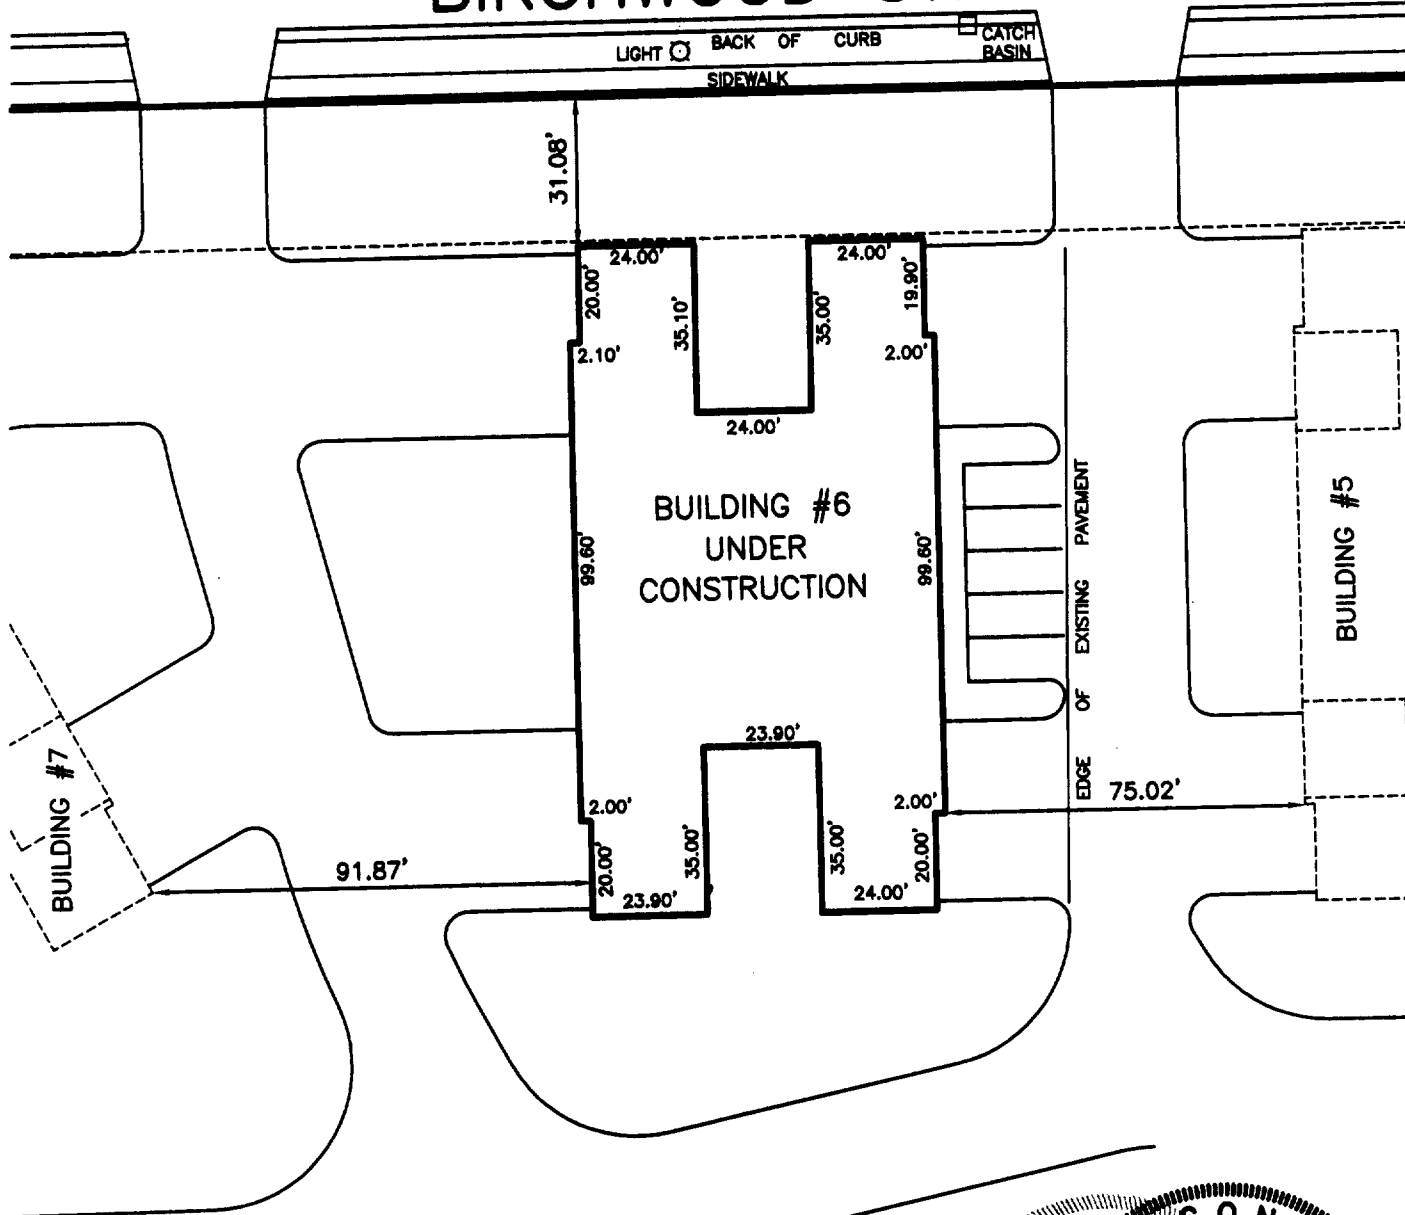

PLAN DATED: JANUARY 22, 2002
FILE NO.: D:\0100\01123
PLAN SCALE: 1" = 40'

MAY 23 2003

STATE OF WISCONSIN }
COUNTY OF JEFFERSON } SS.

WE, PIONEER ENGINEERING & SURVEYING, DO HEREBY CERTIFY THAT WE HAVE MADE THIS SURVEY AND THAT
THE INFORMATION AS SHOWN ON THE ABOVE PLAT OF SURVEY IS TRUE AND CORRECT REPRESENTATION THEREOF.

PIONEER ENGINEERING AND SURVEYING, LLC.

CONSULTANTS IN SUBDIVISIONS
AND COMMERCIAL DEVELOPMENTS

3902 C.T.H. "B"

JOHNSON CREEK, WI. 53038

(920) 699 - 3330 FAX: 699 - 3332

