




# LEGEND

○ FOUND IRON PIPE

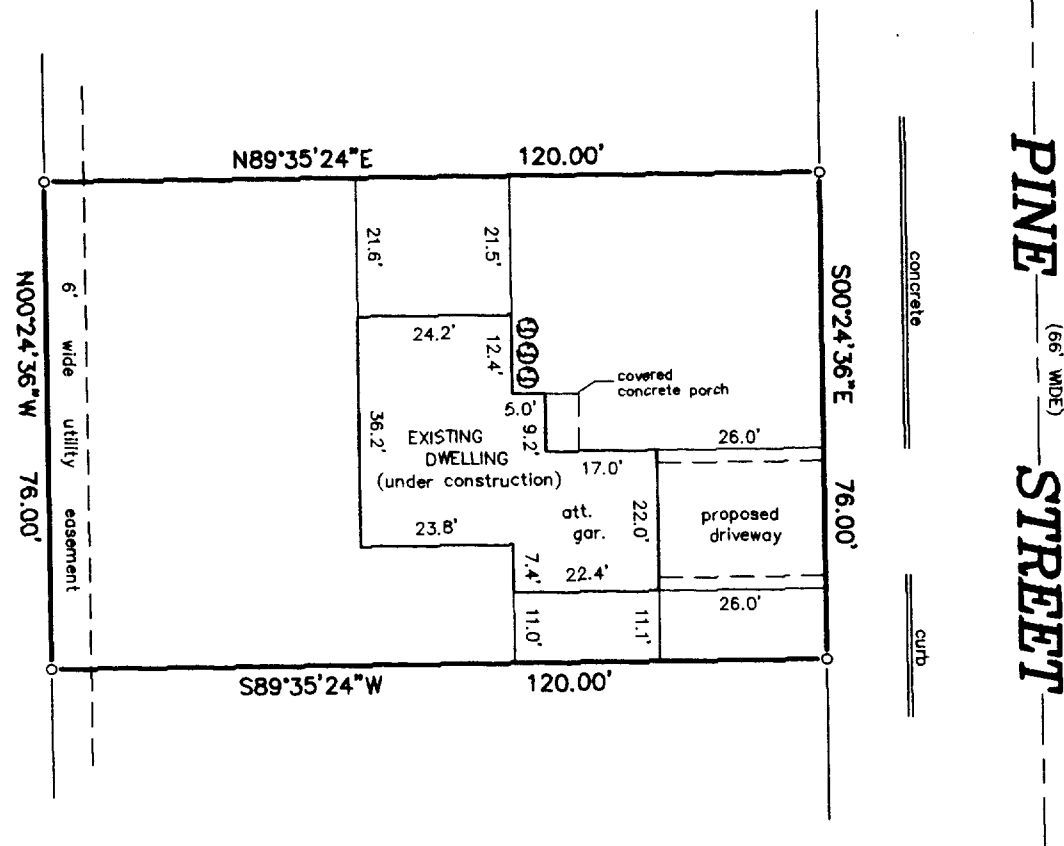



**B.W. SURVEYING, INC.**

412 N. PINE STREET  
BURLINGTON, WI 53105  
(262)-767-0225

## PLAT OF SURVEY -OF-

LOT 74, WHISPERING PINES SECOND ADDITION, BEING PART OF  
THE NORTHWEST 1/4 OF THE SOUTHEAST 1/4 OF SECTION 13,  
TOWN 2 NORTH, RANGE 15 EAST, IN THE CITY OF DELEVAN,  
COUNTY OF WALWORTH, STATE OF WISCONSIN.

SURVEY FOR: SOUTHEASTERN WISCONSIN HOUSING CORPORATION  
SURVEY ADDRESS: \_\_\_\_\_ PINE STREET

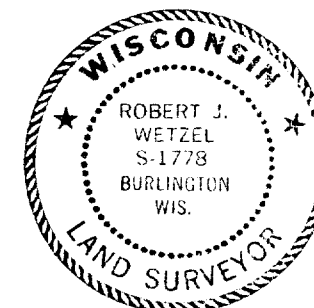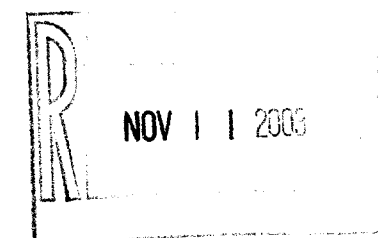

THIS IS NOT AN ORIGINAL PRINT  
UNLESS THIS SEAL IS RED.

*Robert J. Wetzel*  
ROBERT J. WETZEL S-1778

OCTOBER 3, 2003  
DATE

5132  
JOB NUMBER

SCALE:

1" = 30'



XWP2-21

002-2183