


FARRIS, HANSEN & COOPER, INC.

ENGINEERING, SURVEYING AND LAND PLANNING
715 W. WALWORTH ST. - P.O. BOX 487 - ELKHORN, WI 53121
OFFICE: 414/723-2098

WISCONSIN ST.

331.48' (RECORDED 330')

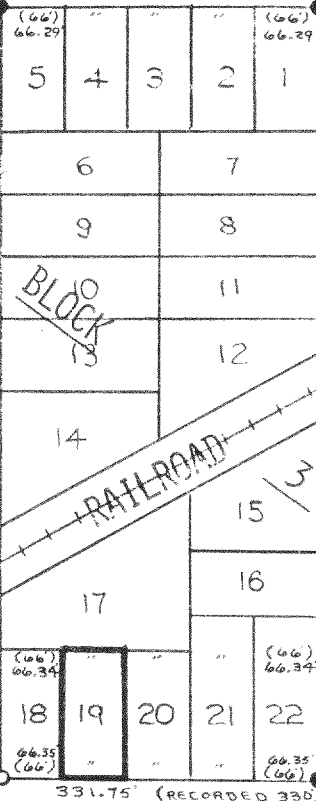



GENEVA ST.

LEGEND

- INDICATES CONCRETE MON. FOUND
- INDICATES 1" DI. IRON PIPE FOUND
- ⊗ INDICATES 1 1/2" DI. X 30" LONG IRON PIPE SET
- () RECORDED DISTANCES

WORK ORDERED BY: ROBERT A. FARRIS
ELKHORN, WISCONSIN

PLAT OF SURVEY OF LOT 19, BLOCK 3 OF
PASSAGE, ARAM & DOWNIE ADDITION, CITY OF
DELAVER, WALWORTH COUNTY, WISCONSIN

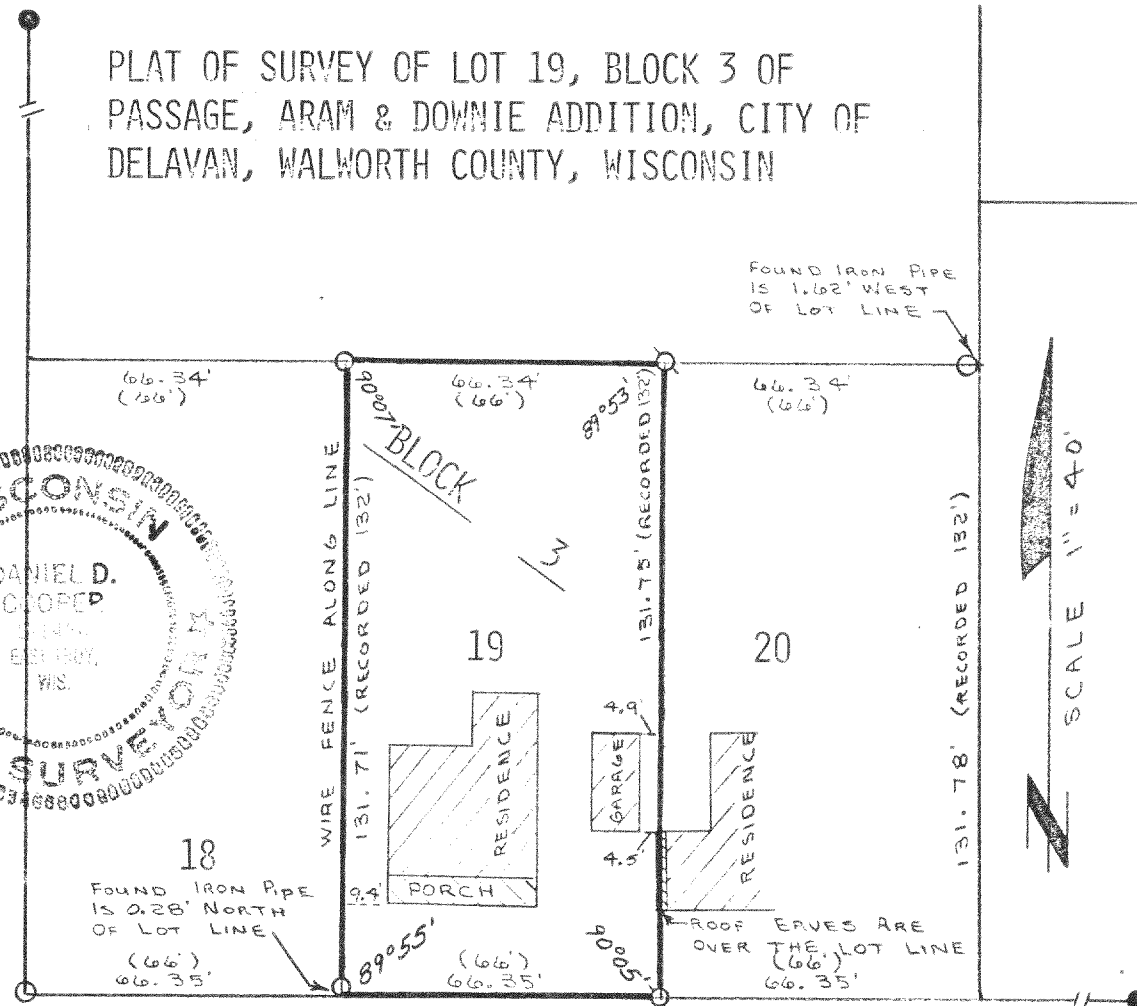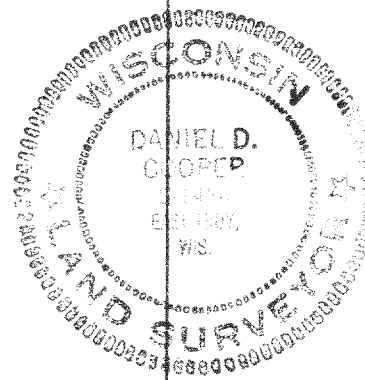

GENEVA STREET

I hereby certify that I have surveyed the property described hereon and that this plat of Survey is a true and accurate representation of the lot lines and buildings to the best of my knowledge and belief.

Dated: Nov 3, 1978

Daniel D. Cooper
Daniel D. Cooper, RLS- 1464

DRAWING NUMBER 1423