



PREPARED FOR:
BRIAN AMBORN
HIBL'S REAL ESTATE
1034B ANN STREET
DELAN, WI 53115

PLAT OF SURVEY

-OF-

J.K. SURVEYING INC.
N3705 WILLOWBEND LANE
LAKE GENEVA, WI 53147
(262) 248-3697

THE EAST 33 FEET OF LOT 14 AND LOT 15, BLOCK 4 OF ELMHURST
SUDIVISION, A SUDIVISION LYING AND BEING IN THE CITY OF DELAVAN,
WALWORTH COUNTY, WISCONSIN.

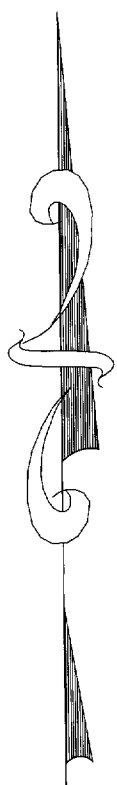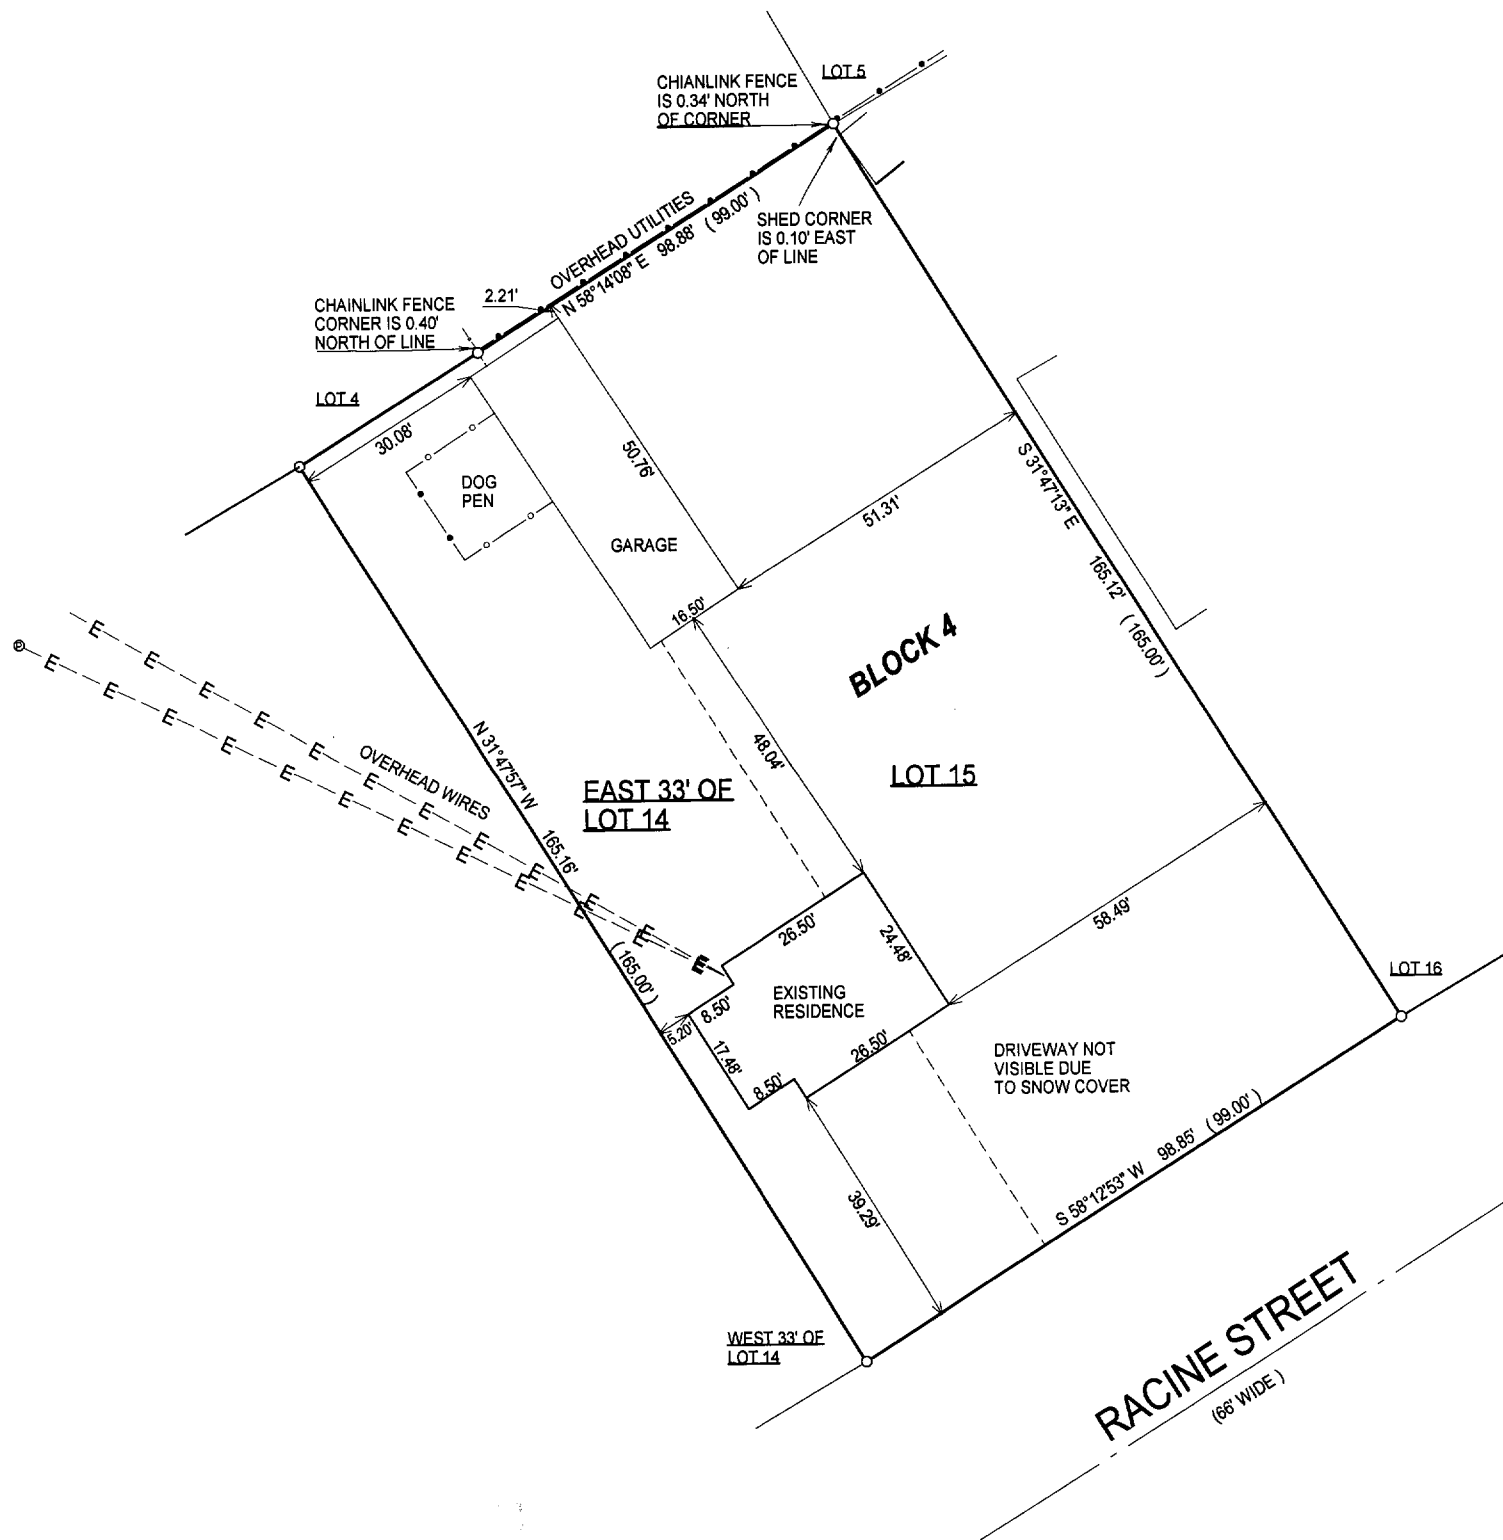

MAR 3

Kw

() = RECORDED AS

□ = FOUND IRON BAR

○ = FOUND IRON PIPE

● = SET IRON PIPE

■ = SET IRON BAR

SCALE: 1" = 30'


JOB #: 04-041

TAX ID #: XEA 00043

NOTE: BEARINGS ARE ASSUMED
NOTE: DUE TO HEAVY SNOW COVER
ALL IMPROVEMENTS MAY NOT
BE SHOWN.

COMPARE LEGAL DESCRIPTION ABOVE AND DRAWING WITH DEED. FOR BUILDING RESTRICTIONS AND
EASEMENTS NOT SHOWN, REFER TO DEED, ABSTRACT SOURCES AND LOCAL MUNICIPAL CODES. NOTIFY
THE SURVEYOR IMMEDIATELY OF ANY DISCREPANCY.

"I hereby certify that the above described property was surveyed under my
supervision and that the above map, to the best of my knowledge and
belief, is a true representation thereof and shows the size and location of all
visible structures, apparent easements and encroachments if any."
This survey is made for the present owners of the property, and those who
purchase, mortgage, or guarantee the title thereto, within one year from
the date hereof.

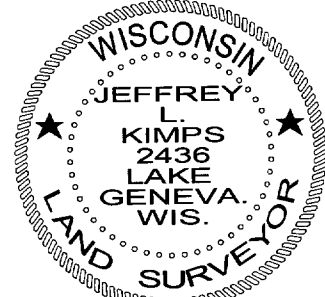

JEFFREY L. KIMPS - S-2436
Wisconsin Registered Land Surveyor
(original if signed in red)

DATED THE 10 TH, DAY OF FEBRUARY 2004.

002-2206