



PREPARED FOR : HIBL'S REAL ESTATE SALES INC.
C/O BRIAN AMBORN
1034B ANN ST.
DELAVAN, WI. 53115

PLAT OF SURVEY

- OF -

J.K. SURVEYING INC.
N3705 WILLOWBEND LANE
LAKE GENEVA, WI, 53147
262-248-3697

LOT 56, IN THE FIRST ADDITION TO TOD MILLER
SUBDIVISION, LOCATED IN PART OF THE NORTHEAST
1/4 OF THE NORTHEAST 1/4 OF SECTION 19 AND THE
NORTHWEST 1/4 OF THE NORTHWEST 1/4 OF SECTION
20 ALL IN TOWNSHIP 2 NORTH, RANGE 16 EAST, IN THE
CITY OF DELAVAN, WALWORTH COUNTY, WISCONSIN.

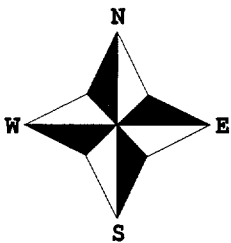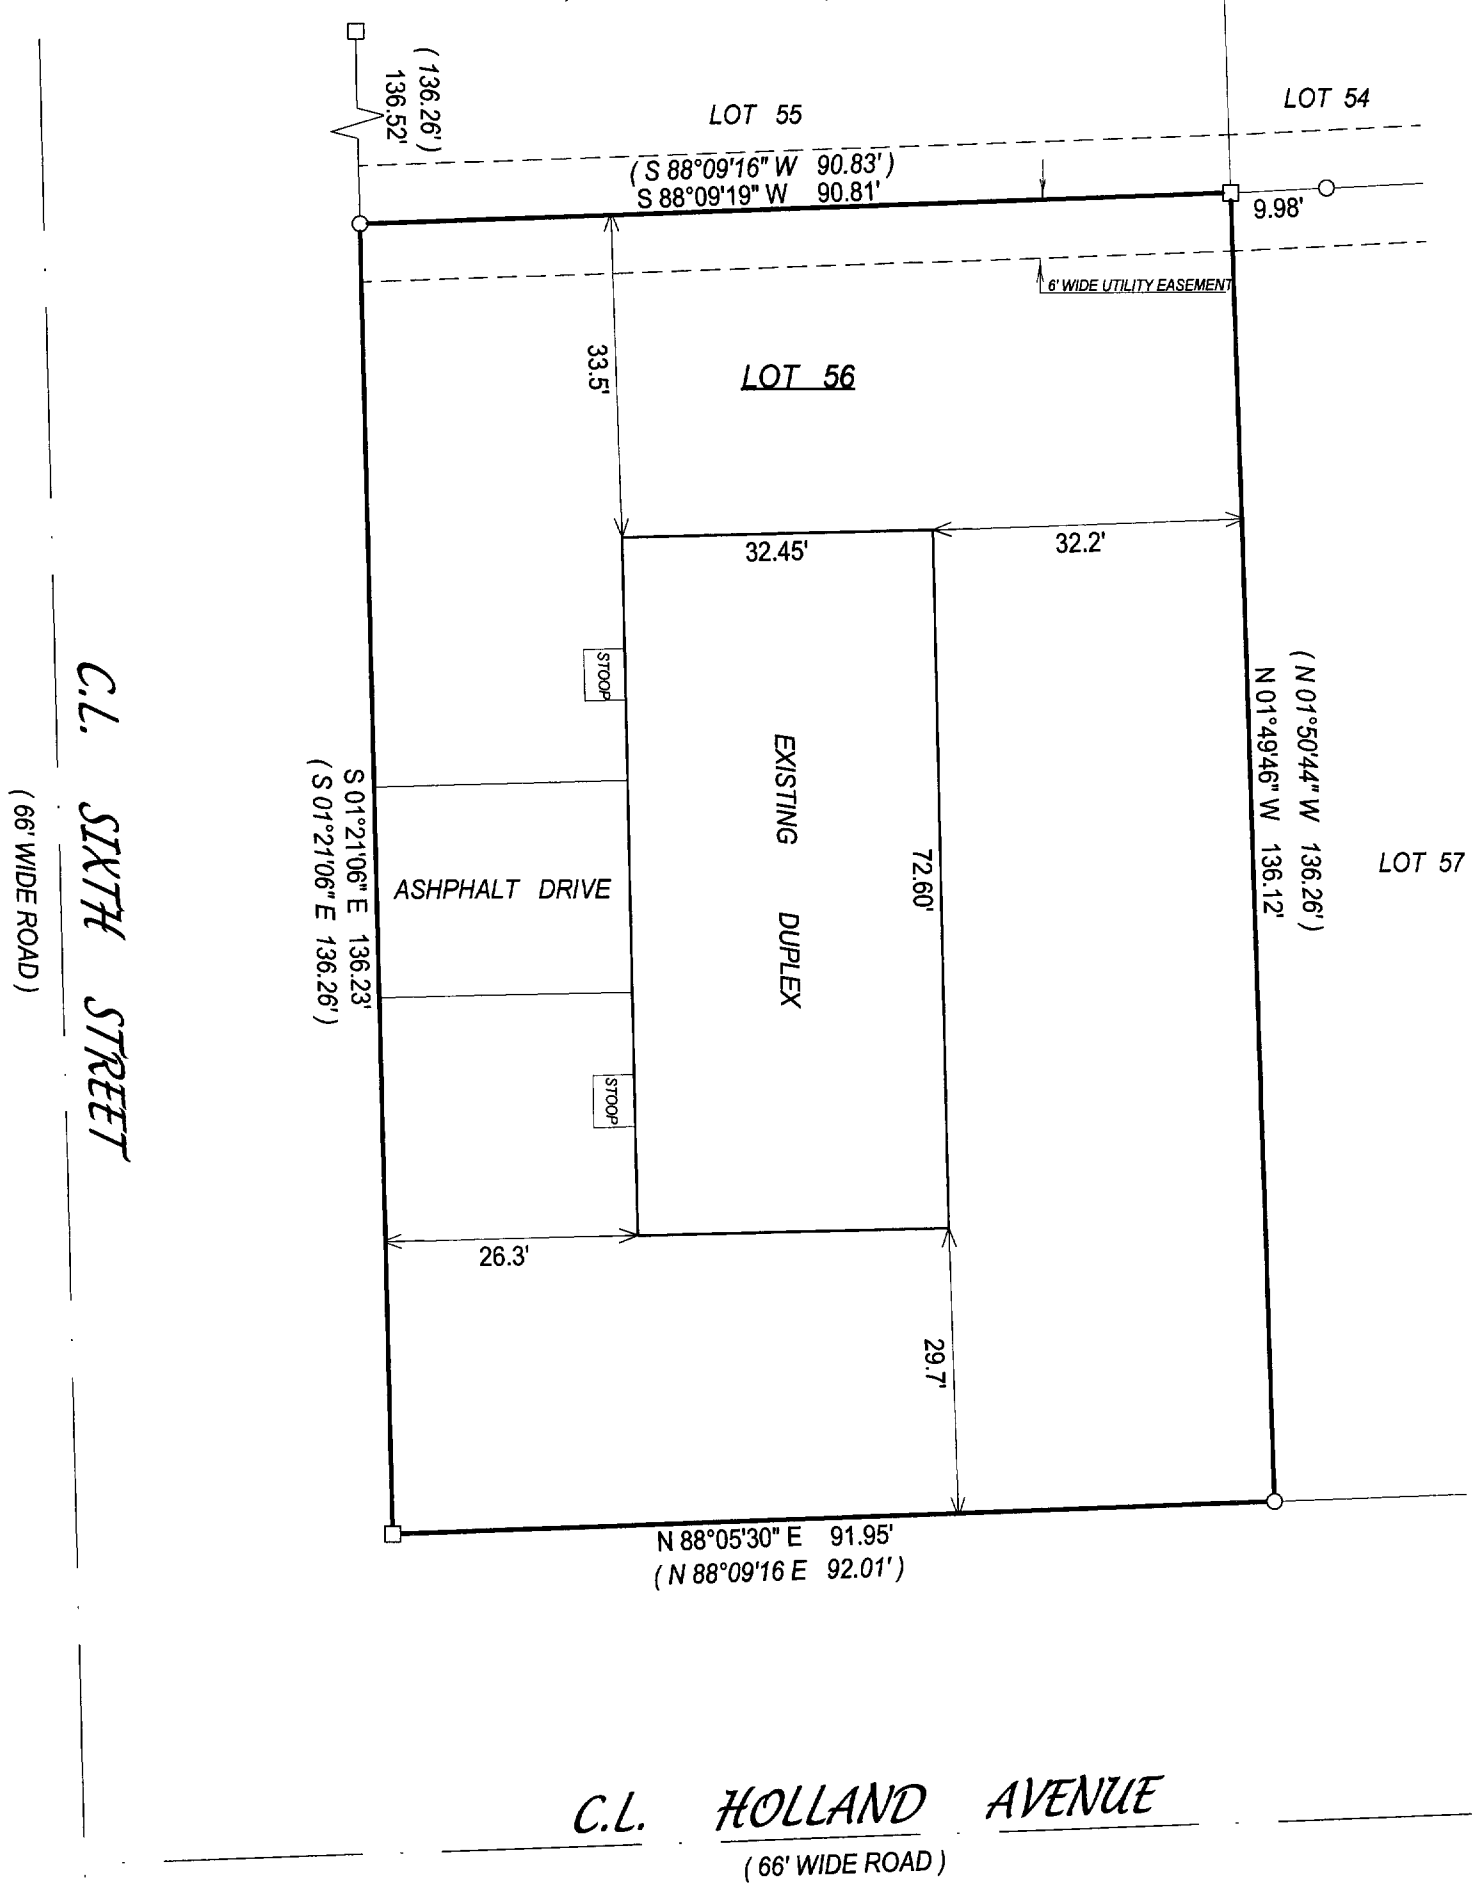

- () = recorded as
- = found iron bar
- = found iron pipe
- = set iron pipe
- = set iron bar

SCALE 1" = 20'


JOB # 03-718

TAX ID # XMIA00030

COMPARE LEGAL DESCRIPTION ABOVE AND DRAWING WITH DEED. FOR BUILDING RESTRICTIONS AND EASEMENTS NOT SHOWN, REFER TO DEED, ABSTRACT SOURCES AND LOCAL MUNICIPAL CODES. NOTIFY THE SURVEYOR IMMEDIATELY OF ANY DISCREPANCY.

"I hereby certify that I have surveyed the above described property and that the above map is a true representation thereof and shows the size and location of all visible structures, apparent easements and encroachments if any."

This survey is made for the present owners of the property, and those who purchase, mortgage, or guarantee the title thereto, within one year from the date hereof.

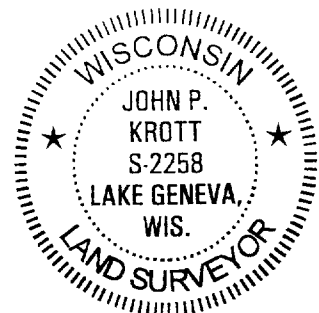

JOHN KROTT S - 2258
Wisconsin Registered Land Surveyor
(original if signed in red)

DATED THIS THE 18th DAY OF NOVEMBER 2003.

002-2207