


MASTERCRAFT BUILDERS
Spec #24098

LEGAL DESCRIPTION:

May 17, 2004

Survey No. 97332

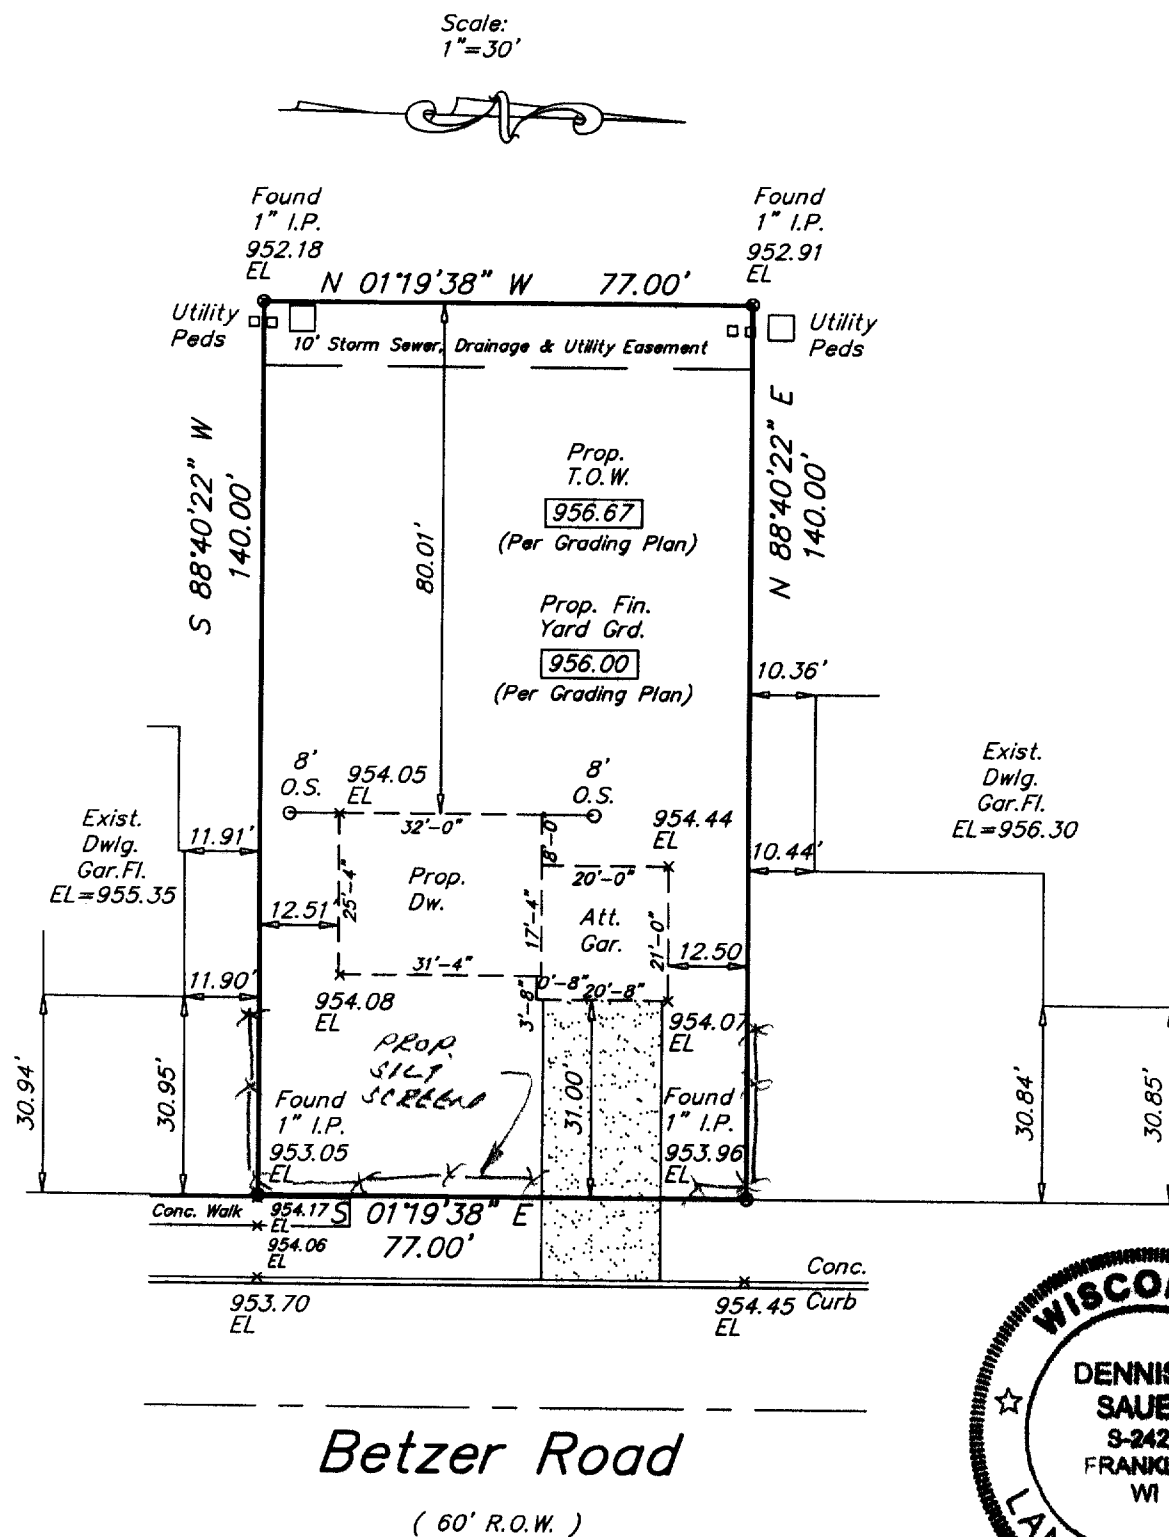


email address survey@execpc.com

**THIS SURVEY IS MADE FOR THE EXCLUSIVE USE OF THE PRESENT OWNERS OF THE PROPERTY,
AND ALSO THOSE WHO PURCHASE, MORTGAGE, OR GUARANTEE THE TITLE THERETO WITHIN
ONE (1) YEAR FROM THE DATE HEREOF.**

SIGNED

Dennis C. Sauer

Registered Land Surveyor S-2421

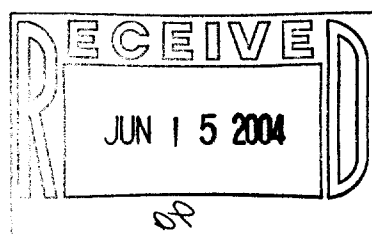

XFI 00051

002-2218