

Plat of Survey





of

A parcel of land described in a Warranty Deed recorded in Vol. 633 on Page 9617 as Document No. 301728 as shown below:

Lot 7 in Block 7 of Fairview Heights in the City of Delavan, as per recorded plat in Vol. 7 of Plats on page 94 in the office of the Register of Deeds for Walworth County, Wisconsin, together with a strip of land 29 feet in depth north and south, immediately adjoining the southern boundary of the above described lot, and extending its entire length.

Surveyed for: **Allyn & Terri Hackett**

611 Herman Street
Delavan, Wisconsin. 53115

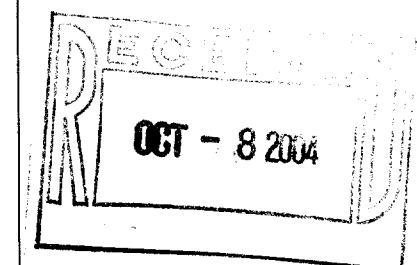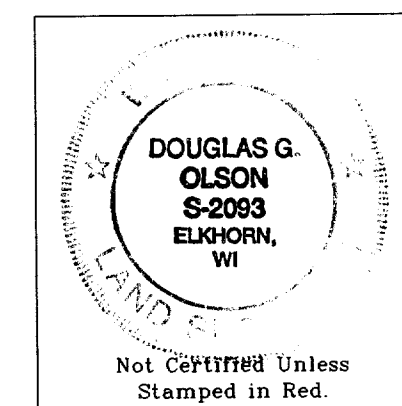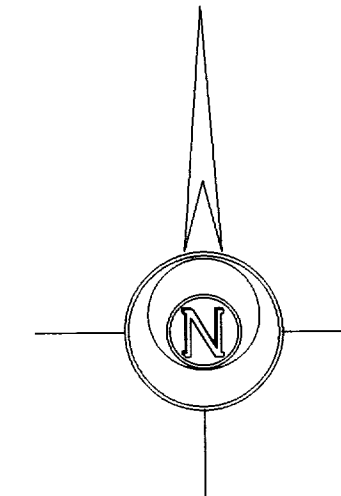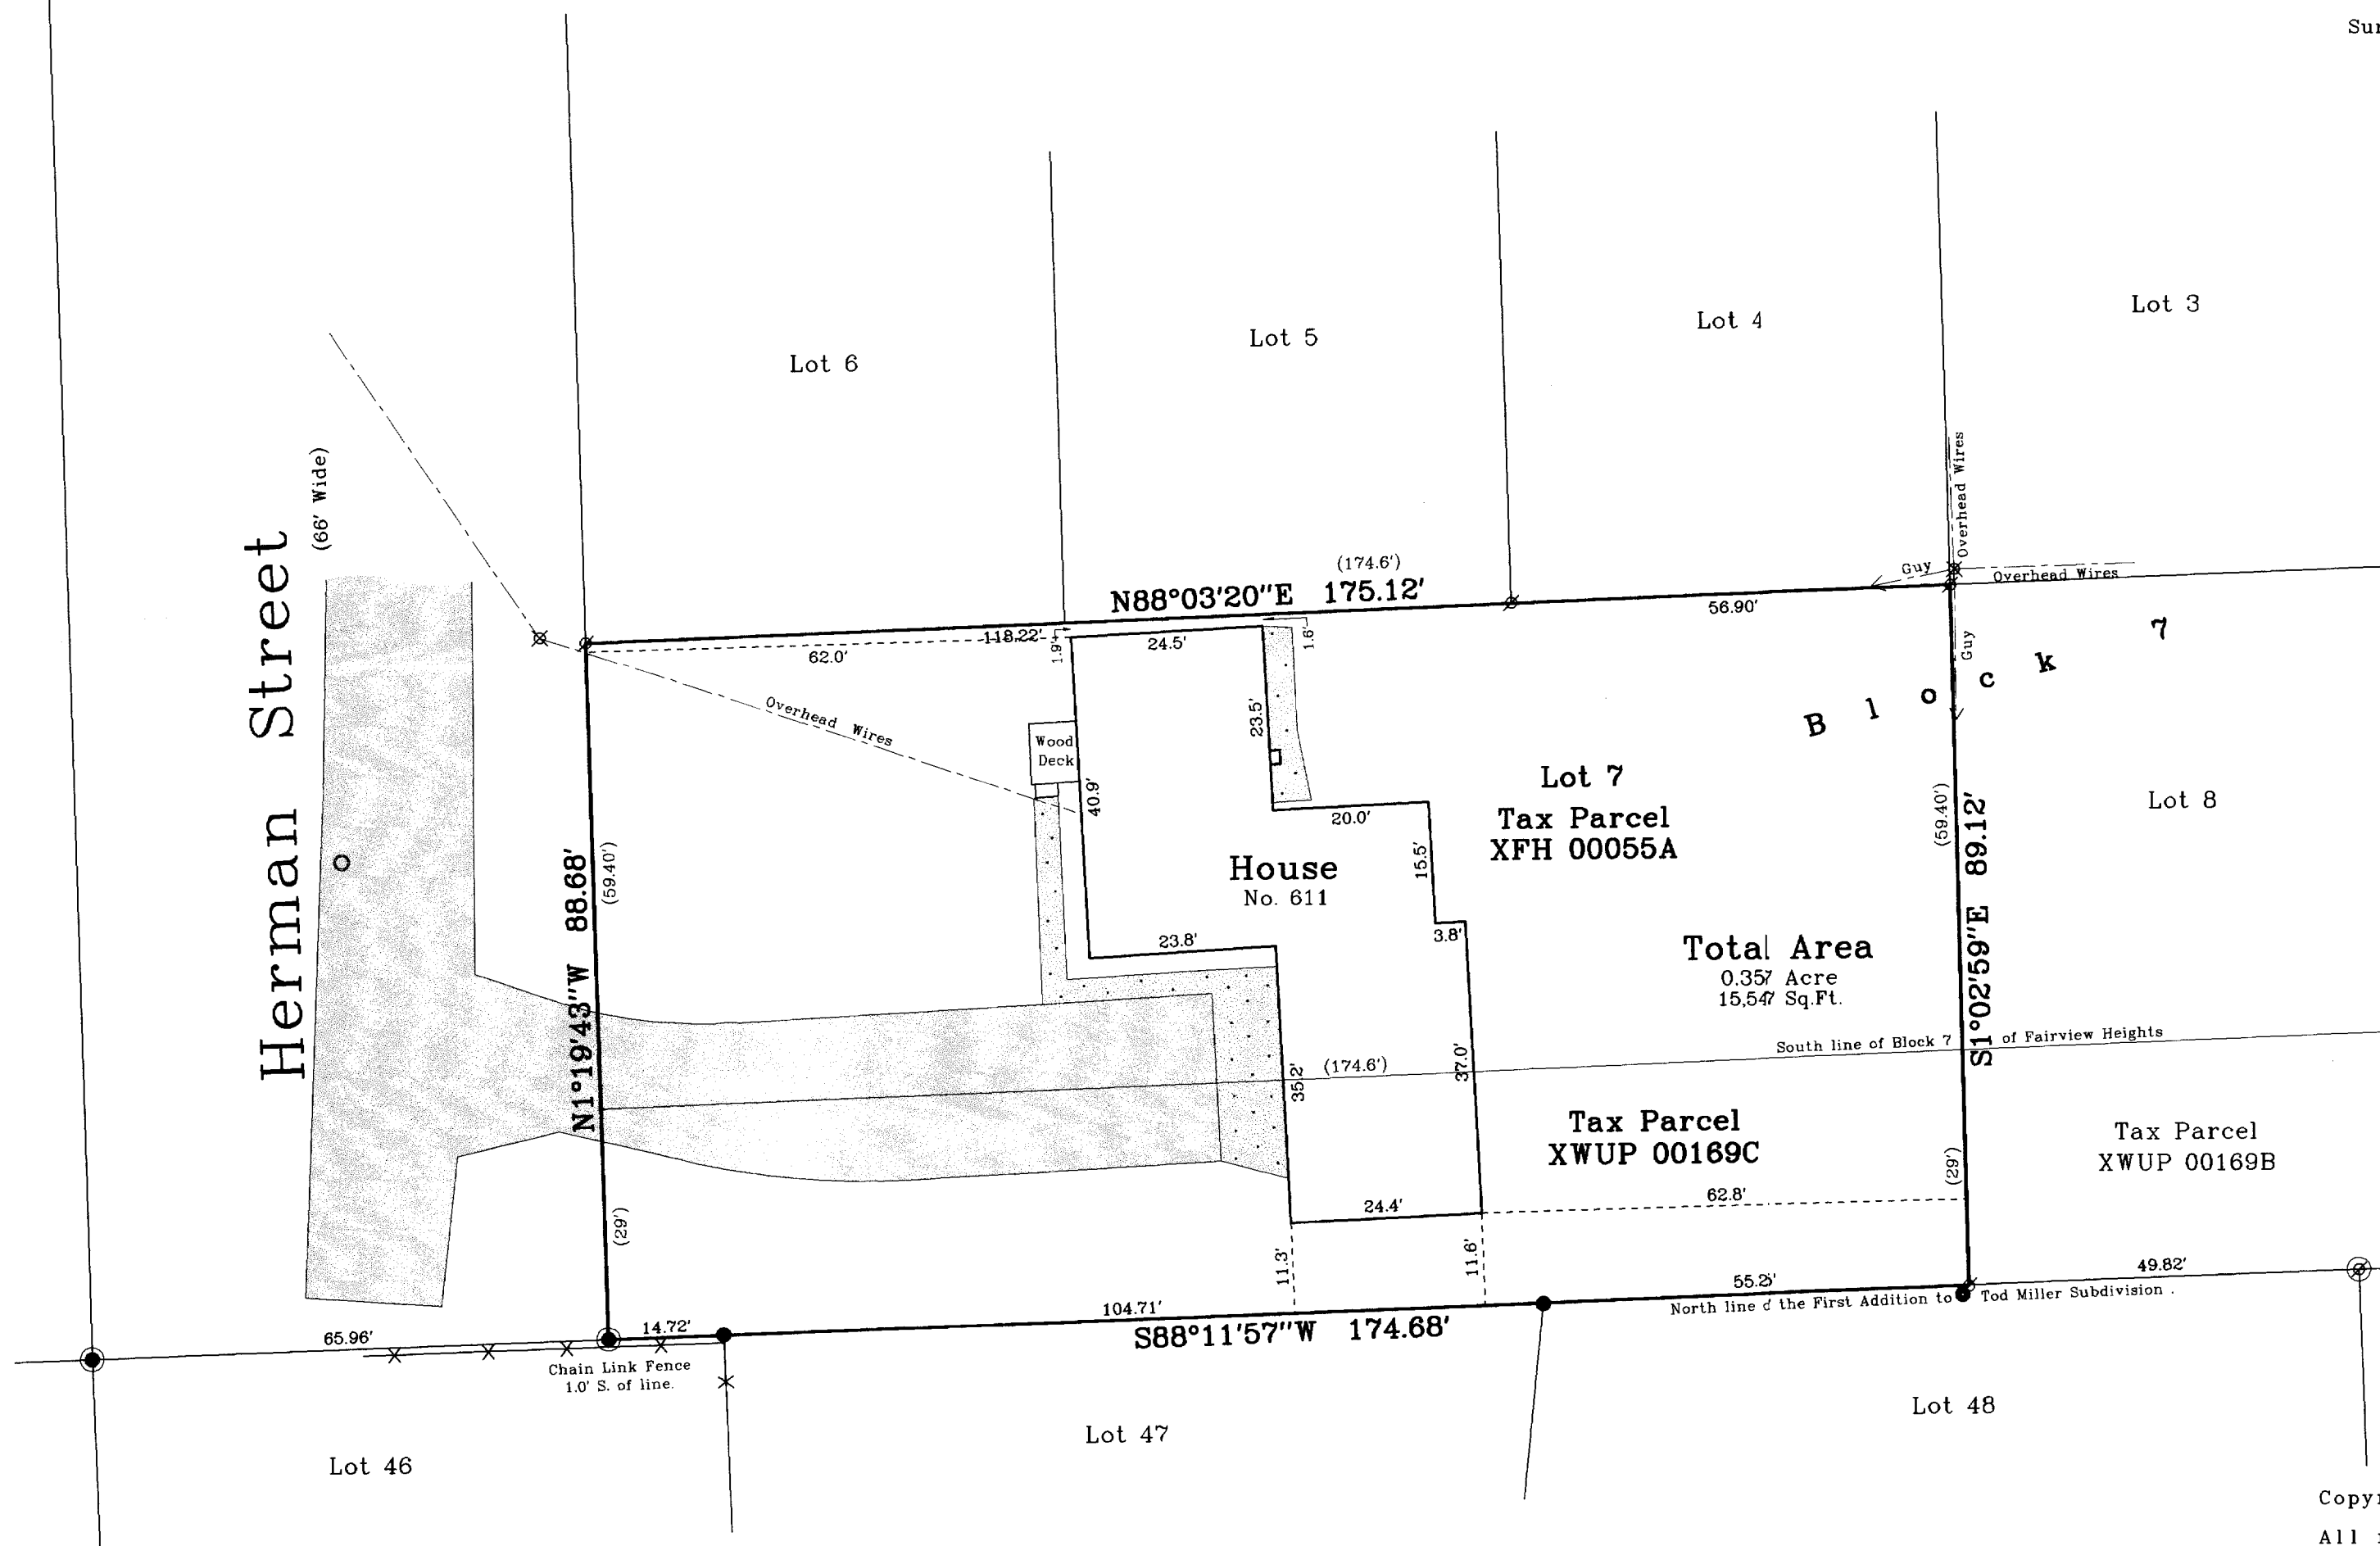

- Notes: 1) This survey plat is not certified unless signed and sealed in red ink.
- 2) This survey is subject to Wisconsin lien laws. This Plat of Survey is the notice of intent to file lien. Lien waiver required.


Copyright © 2004 by Jensen & Olson Land Surveying, LLC.

All rights reserved. No part of this survey plat may be reproduced or transmitted in any form by any means - graphic, electronic, or mechanical, including photocopying, tracing, or information storage and retrieval systems - without permission in writing from Douglas G. Olson, Jensen & Olson Land Surveying, LLC.

I, Douglas G. Olson, Wisconsin Registered Land Surveyor, do hereby certify that this survey was performed by me or under my direction in full compliance with the owner's/agent's instructions and Chapter A-E 7 of the Wisconsin Administrative Code "Minimum Standards for Property Surveys"; and that this map is an accurate representation thereof to the best of my knowledge and belief.

Douglas G. Olson
Wisconsin Registered Land Surveyor - 2093

Survey Date: April 16, 2004.
Revisions:

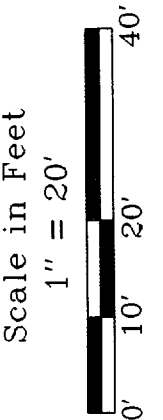

Jensen & Olson Land Surveying, LLC

45 South Wisconsin Street
Elkhorn, Wisconsin. 53121
P.O. Box 322
Telephone (262) 723-3434
Facsimile (262) 723-8044

Legend
● Found Iron Pipe, 2" dia., 8' dia.
● Found Iron Rod, 1-3/16" dia.
● Found Iron Rod, 3/4" dia.
X Recorded Information
X Survey Pole
O Manhole
Asphalt Surface
Concrete Surface

Sheet 1 of 1 Sheets
Job Reference Number

2004.034

2004.034

XFH 00055A

002-2252