



PREPARED FOR: SHOREWEST REALTORS  
 C/O ALLISON OLESTON  
 830 E. GENEVA ST.  
 DELAVAN WI. 53115

# PLAT OF SURVEY

J.K. SURVEYING INC.  
 N3705 WILLOWBEND LANE  
 LAKE GENEVA, WI, 53147  
 262-248-3697

- OF -

A PARCEL OF LAND LOCATED IN THE NORTHEAST 1/4 OF SECTION 19, TOWN 2 NORTH, RANGE 16 EAST, CITY OF DELAVAN, WALWORTH COUNTY, WISCONSIN, DESCRIBED AS FOLLOWS, TO-WIT: BEGINNING AT A POINT IN THE CENTERLINE OF COUNTY TRUNK HIGHWAY "O" OS SOUTH 2nd STREET IN SAID CITY OF DELAVAN, LOCATED AT THE INTERSECTION OF SAID CENTER LINE WITH THE EASTERLY EXTENSION OF THE NORTH LINE OF HOMESTEAD ROAD; THENCE WEST ALONG THE NORTH LINE OF SAID EXTENSION OF HOMESTEAD ROAD AND THE NORTH LINE OF SAID ROAD 217.80 FEET; THENCE NORTH PARALLEL WITH THE CENTERLINE OF SAID COUNTY TRUNK HIGHWAY "O" 115.00 FEET; THENCE EAST PARALLEL WITH THE NORTH LINE OF SAID HOMESTEAD ROAD 217.80 FEET TO THE CENTERLINE OF COUNTY TRUNK HIGHWAY "O"; THENCE SOUTH ALONG SAID CENTERLINE 115.00 FEET TO THE PLACE OF BEGINNING.

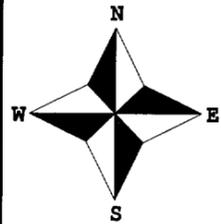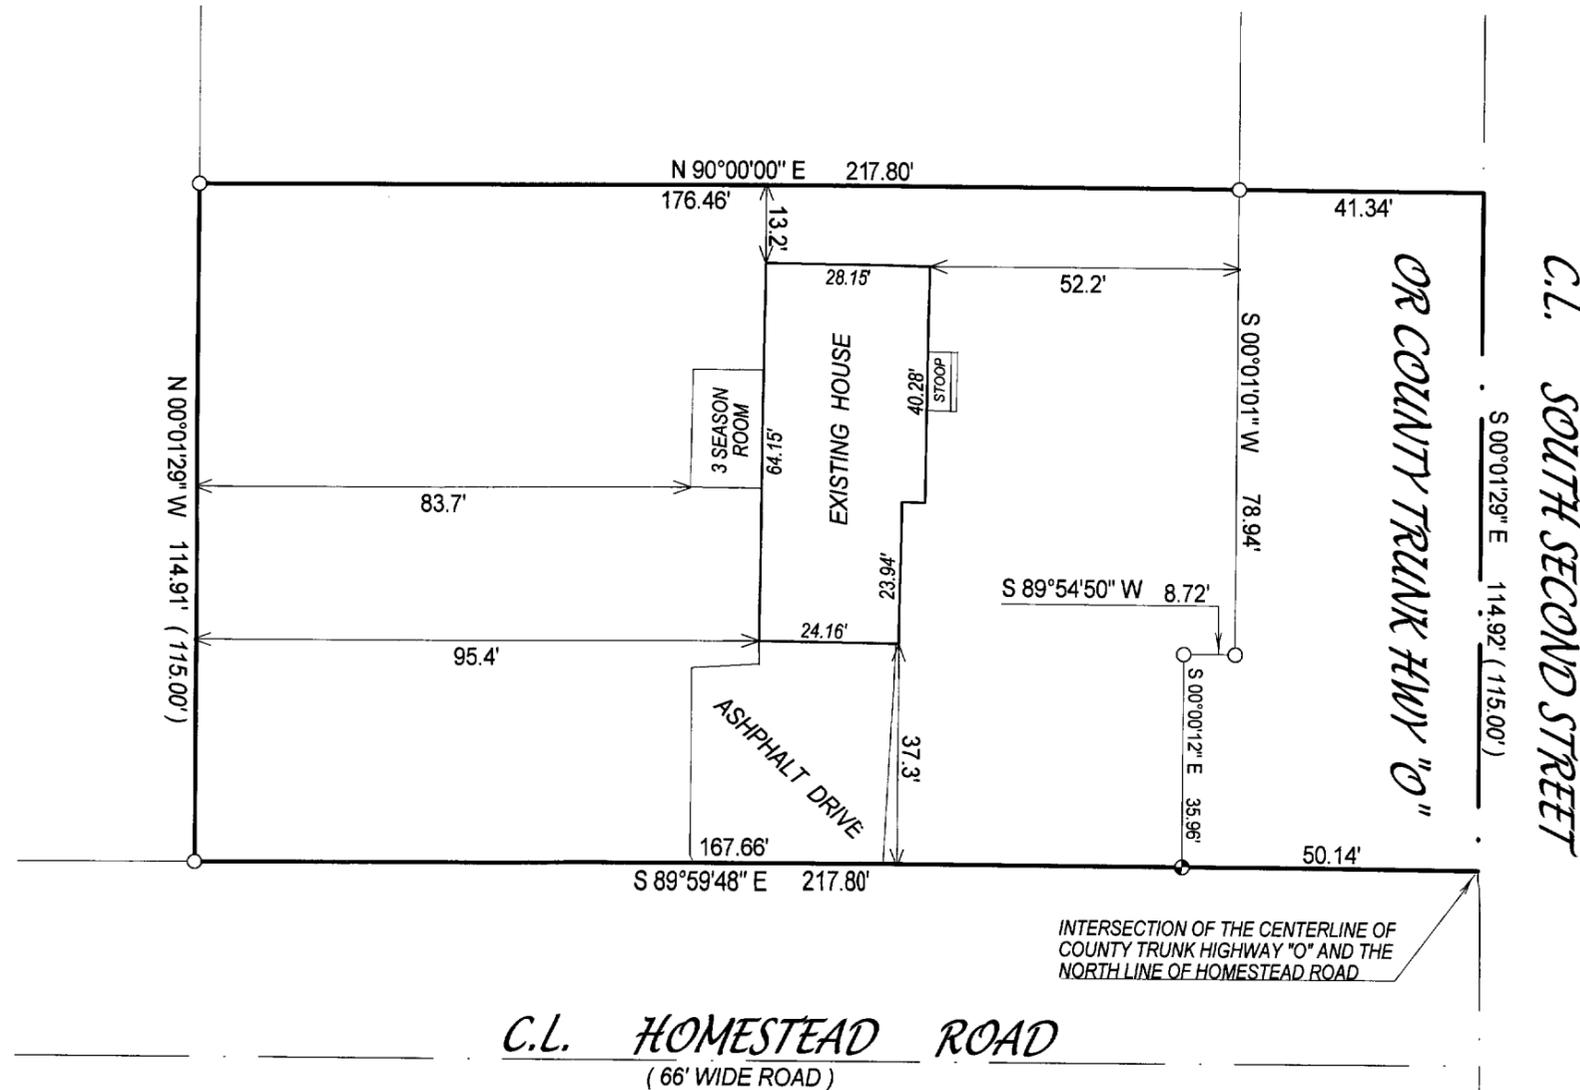

- ( ) = recorded as
- = found iron bar
- = found iron pipe
- = set iron pipe
- = set iron bar

SCALE 1" = 30'

JOB # 05-006


TAX ID # XWUP00129C

COMPARE LEGAL DESCRIPTION ABOVE AND DRAWING WITH DEED. FOR BUILDING RESTRICTIONS AND EASEMENTS NOT SHOWN, REFER TO DEED, ABSTRACT SOURCES AND LOCAL MUNICIPAL CODES. NOTIFY THE SURVEYOR IMMEDIATELY OF ANY DISCREPANCY.

"I hereby certify that I have surveyed the above described property and that the above map, to the best of my knowledge and belief, is a true representation thereof and shows the size and location of all visible structures, apparent easements and encroachments if any."

This survey is made for the present owners of the property, and those who purchase, mortgage, or guarantee the title thereto, within one year from the date hereof.

FEB 19 2005

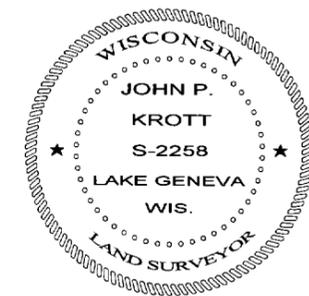

*John P. Krott*  
 JOHN KROTT S - 2258  
 Wisconsin Registered Land Surveyor  
 (original if signed in red)

DATED THIS THE 13th DAY OF JANUARY 2005.

002-2001