


GENEYA STREET

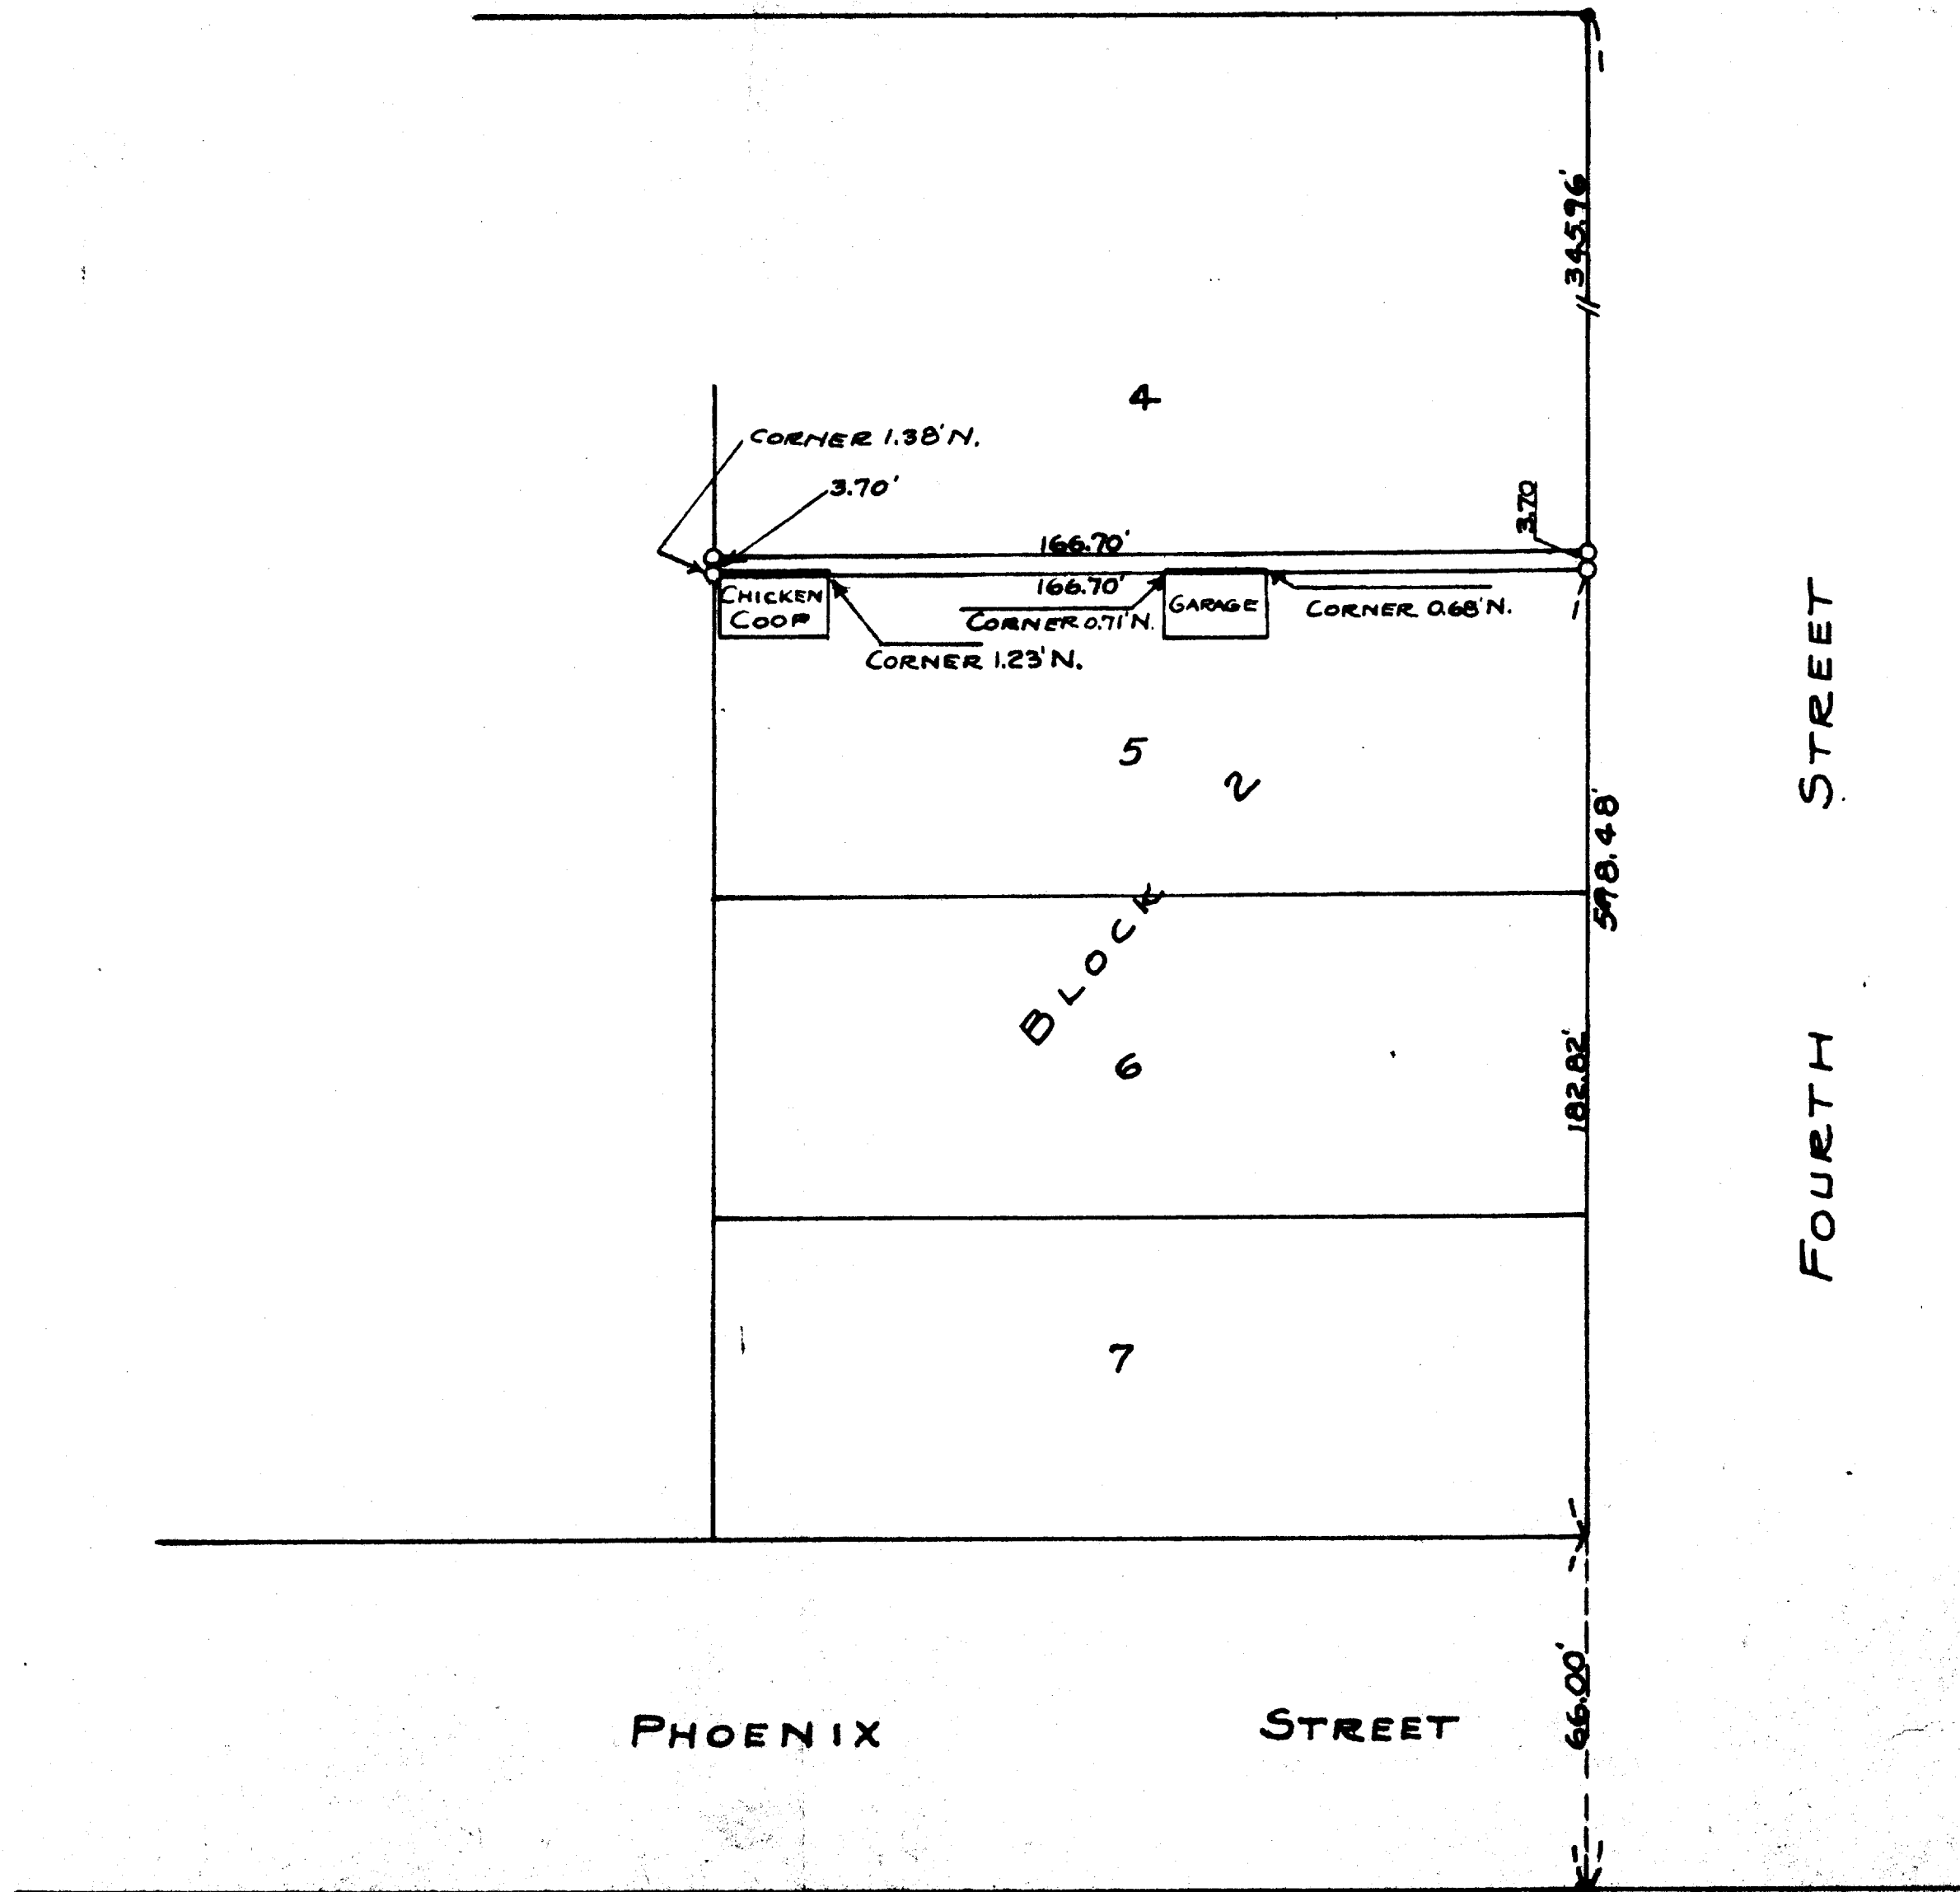

PLAT OF SURVEY OF LAND LOCATED IN BLOCK 2 OF SARAH A. PHOENIX ADDITION CITY OF DELAVAN, WALWORTH COUNTY, WISCONSIN. DEC. 1951

Lloyd Jensen
COUNTY SURVEYOR

SUBSCRIBED AND SWORN TO BEFORE ME THIS 24TH DAY OF December, 1952

SCALE 1" = 50'
O = IRON PIPE
● = CONC. MONU.

XS-9A + 9B

Charles E. Jensen
NOTARY PUBLIC - WALWORTH CO., WISCONSIN
MY COMMISSION EXPIRES Aug. 22, 1954

2-22J