
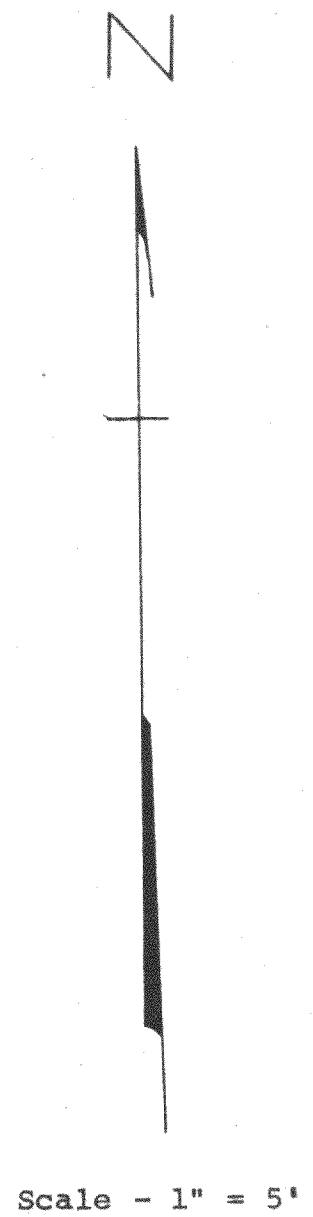


GEORGE T. DUNHAM
SURVEYING & SUBDIVIDING
DELAVER, WISCONSIN

Elevation in Centerline of Street
100.00

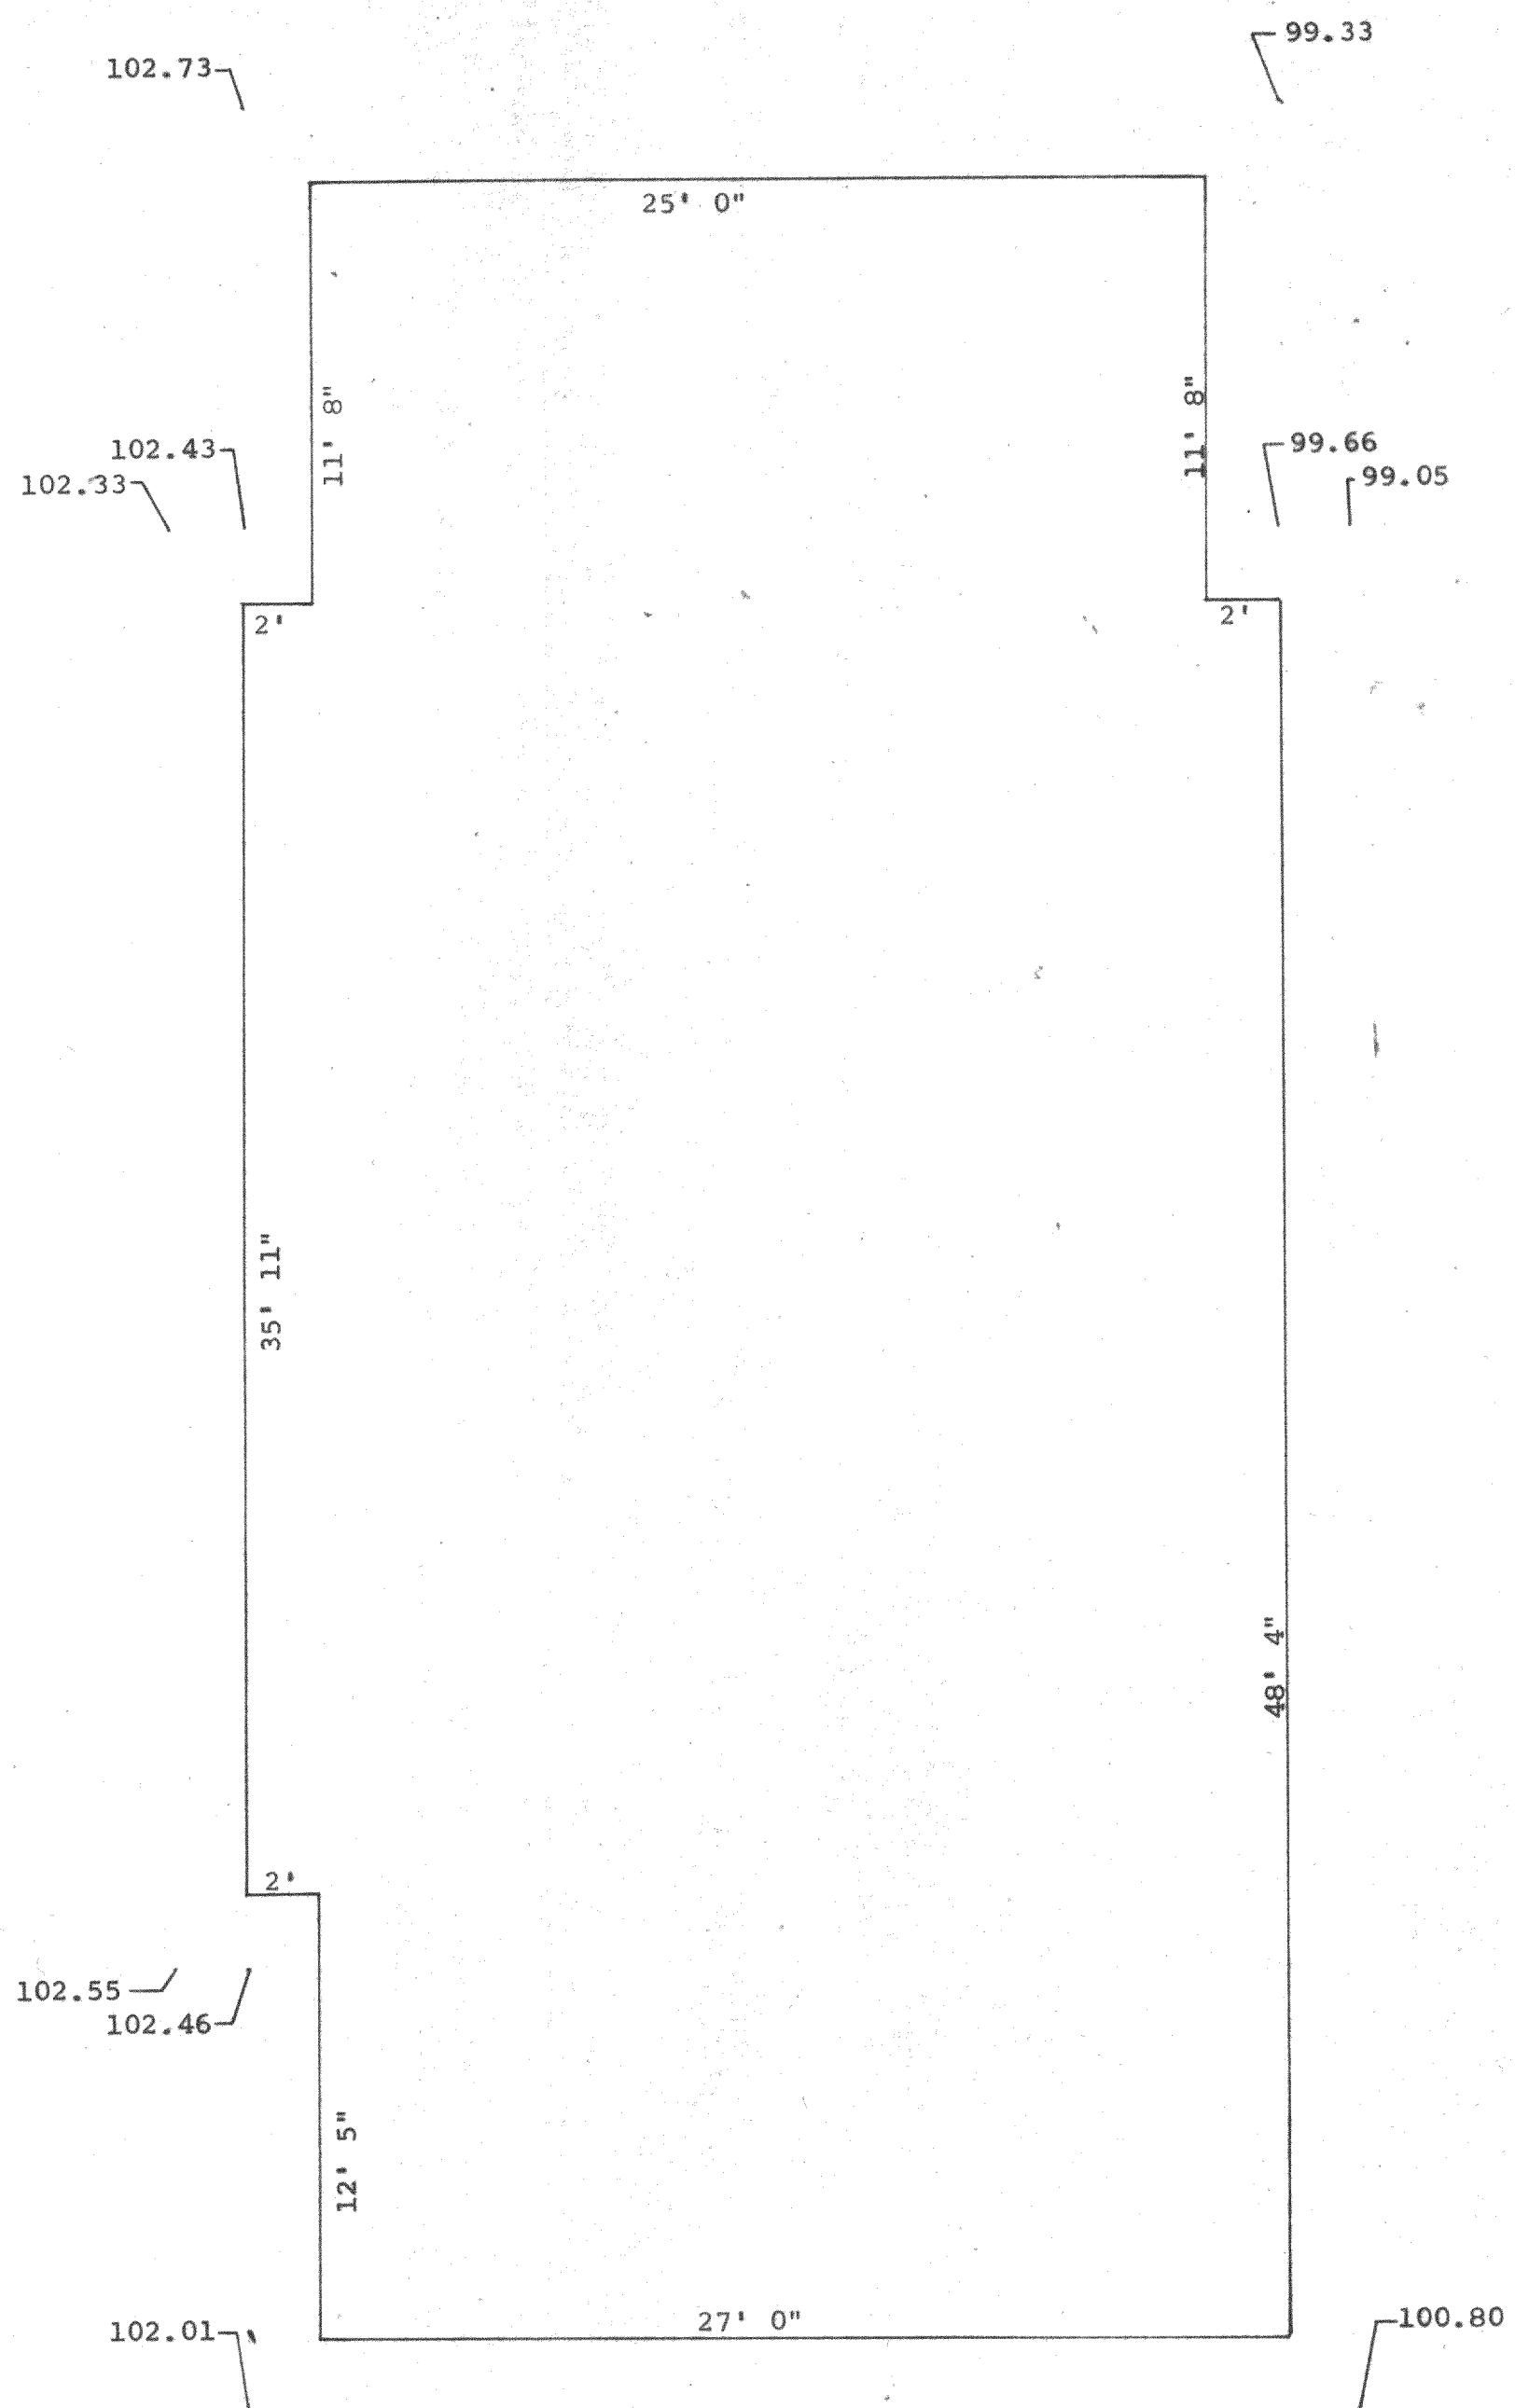

Elevations on top of 2' offset stakes for the proposed residence on Lot 1,
Block 1 of Springs Park Subdivision, City of Delavan, Walworth County, Wisconsin
August 10, 1963

George T. Dunham
George T. Dunham, Surveyor