

ABELL SURVEYING & MAPPING

1140 SEQUOIA STREET • DELAVAN, WISCONSIN 53115
262-728-6737

NOTE: BEARINGS ARE REFERENCED TO THE
RECORDED SUBDIVISION PLAT.



SCALE 1"=20'

LEGEND

- - IRON ROD FOUND
- - IRON BAR FOUND
- - 1" DIA. IRON PIPE SET
- () - RECORDED AS

NOTE: THIS PLAT REPRESENTS A BOUNDARY
SURVEY ONLY AT THE DIRECTION OF:
TARCY MARKLING.


I, DAVID F. ABELL, DO HEREBY CERTIFY THAT I HAVE SURVEYED THE PROPERTY HEREON
DESCRIBED ACCORDING TO THE OFFICAL RECORDS AND THAT THE PLAT HEREON IS A
CORRECT REPRESENTATION OF THE PROPERTY LINES TO THE BEST OF MY KNOWLEDGE AND
BELIEF.

David F. Abell

DAVID F. ABELL
WISCONSIN REGISTERED LAND SURVEYOR, S-1596

May 23, 2006

DATE: May 23, 2006 JOB NUMBER - 06047
NOTE: THIS IS NOT A CERTIFIED COPY UNLESS SEALED.

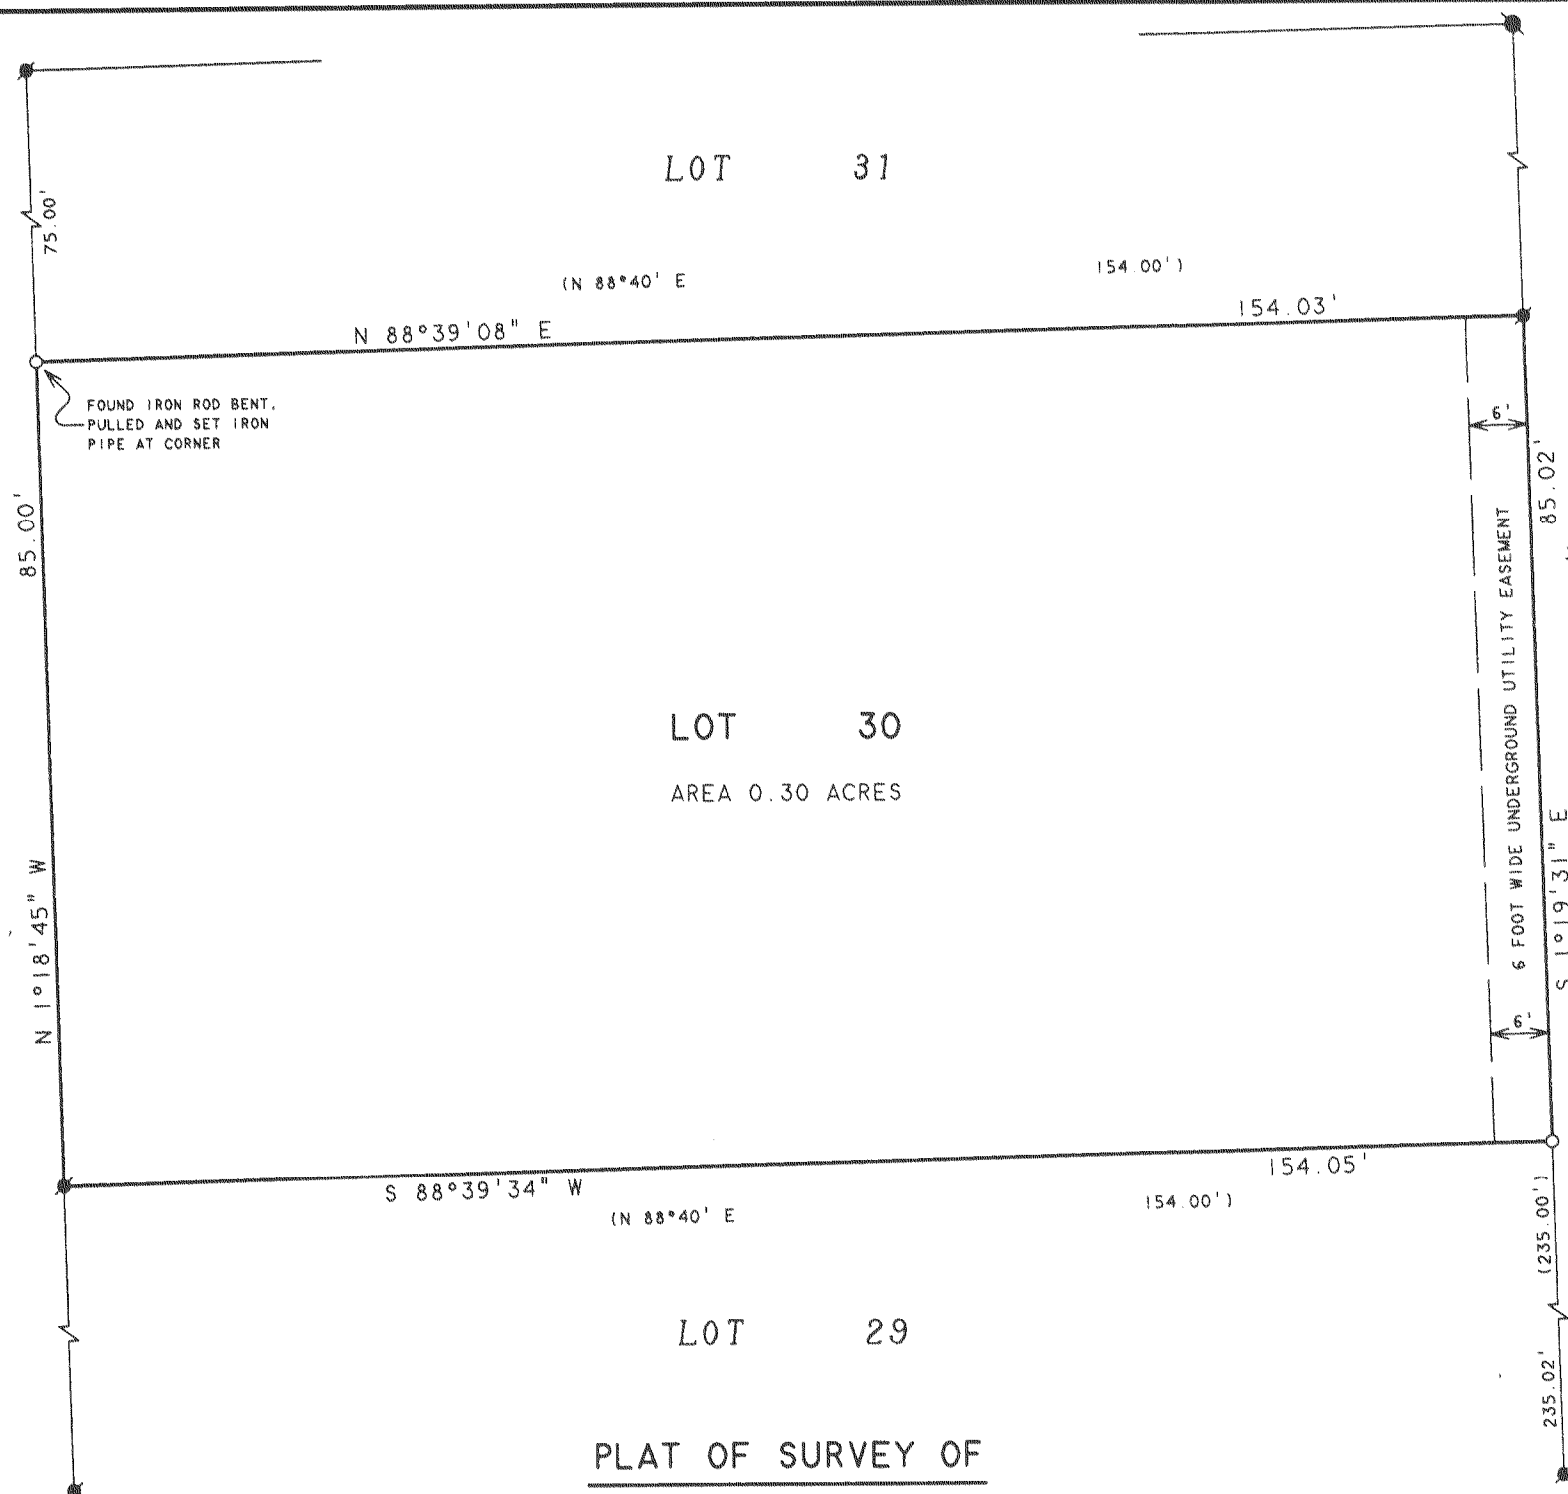

ORDERED BY: TRACY MARKLING
211 BUTTERNUT DRIVE
DELAVAN, WI 53115

JUN 8 2006

SMF

XCR1-30

002-2346