


FARRIS, HANSEN & COOPER, INC.


ENGINEERING, SURVEYING AND LAND PLANNING
715 W. WALWORTH ST. - P.O. BOX 487 - ELKHORN, WI 53121
OFFICE: 414/723-2098

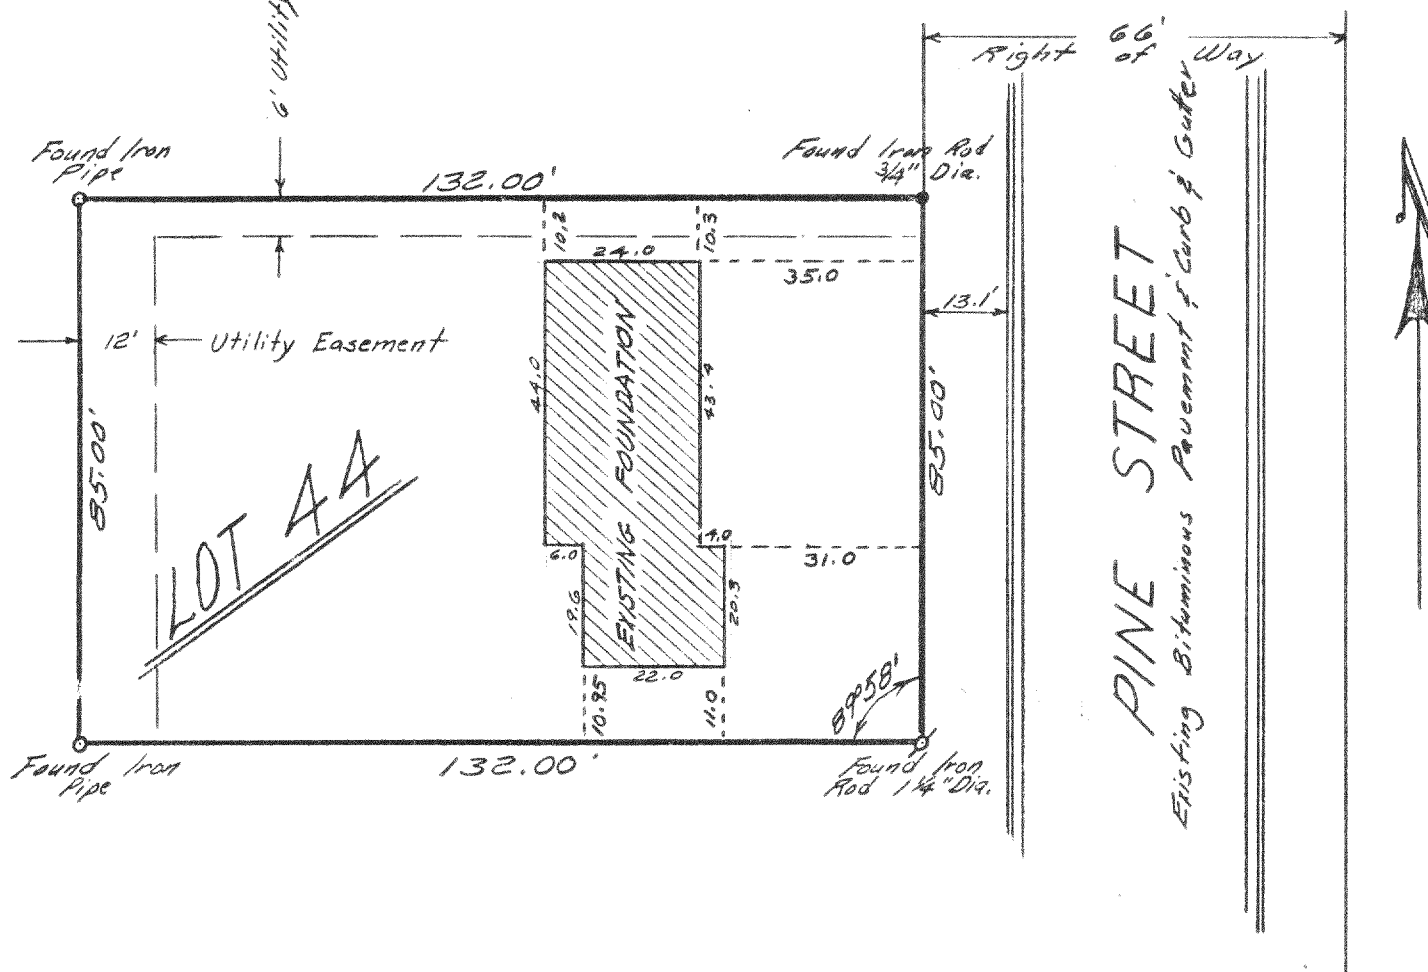

PLAT OF SURVEY OF LOT 44 OF TURTLE CREEK SUBDIVISION IN THE CITY OF DELAVAN, WALWORTH COUNTY, WISCONSIN

WORK ORDERED BY: MIKE KARCHER - OWNER
662 E. GENEVA ST.
DELAVAN, WIS. 53115

I HEREBY CERTIFY that this plat of survey is a true and accurate representation of the lot lines and of the basement of an unfinished residence located thereon to the best of my professional knowledge and belief.

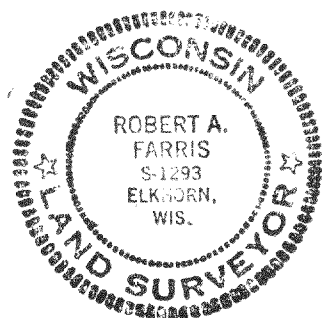

Robert A. Farris
ROBERT A. FARRIS RLS

DATED THIS 25th DAY OF OCTOBER 1978

MAP SCALE 1"=30'

DRAWING NUMBER 1426

2-237