
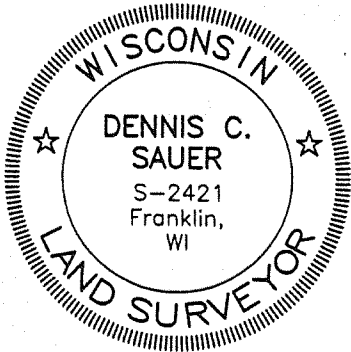
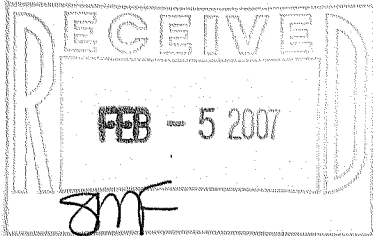
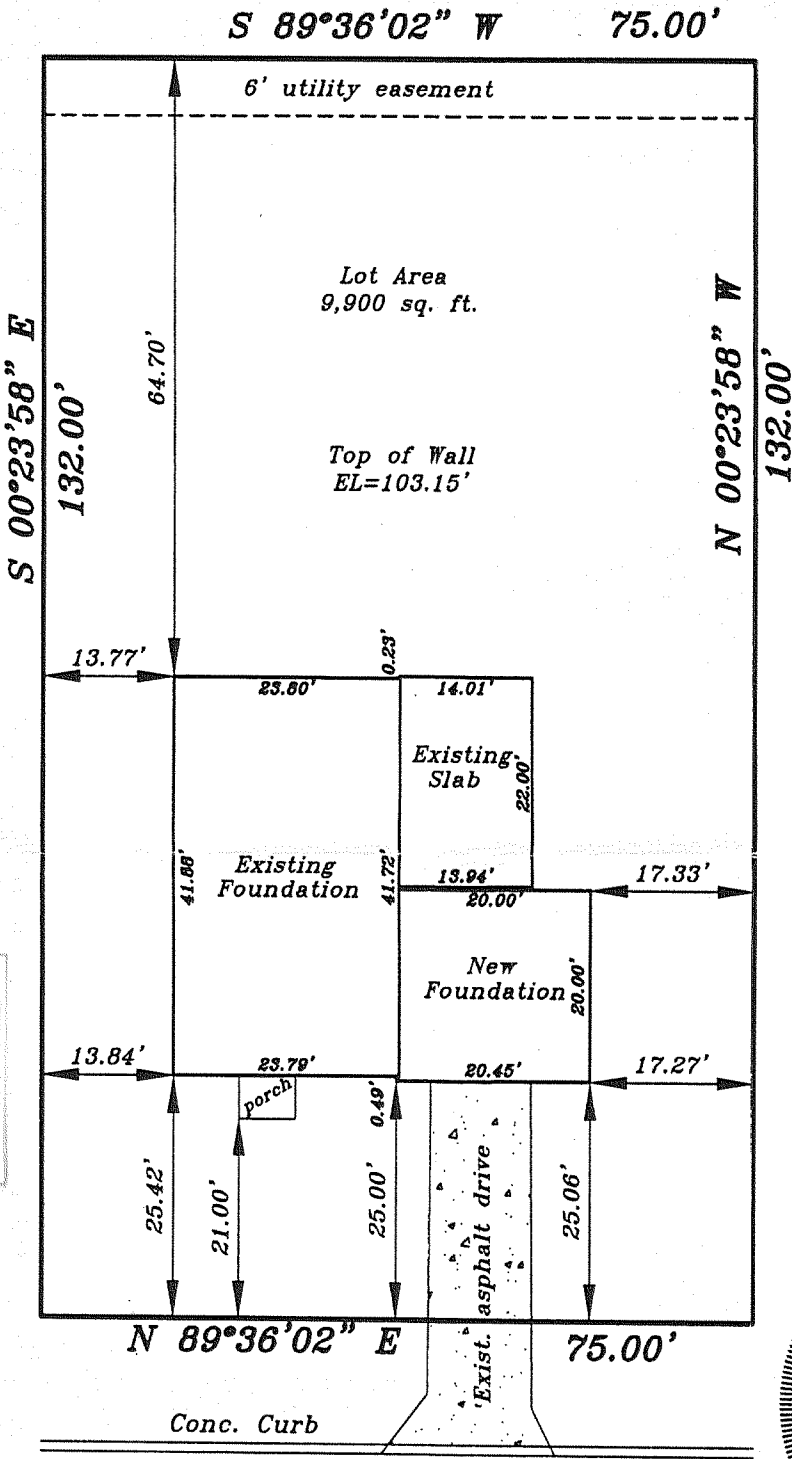


PLAT OF SURVEY

LOCATION: 1119 Birchwood Street, Delavan, Wisconsin

LEGAL DESCRIPTION:
Lot 91 in TURTLE CREEK FIRST ADDITION, a subdivision located in the Southwest 1/4 of the Southeast 1/4 of Section 13, Township 2 North, Range 15 East, City of Delavan, Walworth County, Wisconsin.

January 4, 2007 Survey No. 100199

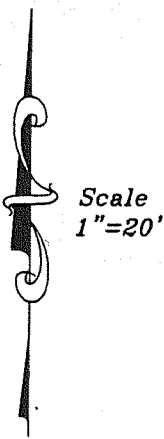


Birchwood Street

(66' R.O.W.) EL Rim=100.00'

METROPOLITAN SURVEY SERVICE, INC.
REGISTERED LAND SURVEYORS AND CIVIL ENGINEERS
5200 W. LOOMIS ROAD GREENDALE, WI 53129
PH. (414) 529-5380 FAX (414) 529-9787
email address survey@bizwi.rr.com

I HEREBY CERTIFY THAT I HAVE SURVEYED THE ABOVE DESCRIBED PROPERTY AND THAT THE ABOVE MAP IS A TRUE REPRESENTATION THEREOF AND SHOWS THE SIZE AND LOCATION OF THE PROPERTY. ITS EXTERIOR BOUNDARIES, THE LOCATION OF ALL VISIBLE STRUCTURES AND DIMENSIONS OF ALL PRINCIPAL BUILDINGS THEREON, BOUNDARY FENCES, APPARENT EASEMENTS AND ROADWAYS AND VISIBLE ENCROACHMENT, IF ANY.

THIS SURVEY IS MADE FOR THE EXCLUSIVE USE OF THE PRESENT OWNERS OF THE PROPERTY, AND ALSO THOSE WHO PURCHASE, MORTGAGE, OR GUARANTEE THE TITLE THERETO WITHIN ONE (1) YEAR FROM THE DATE HEREOF.

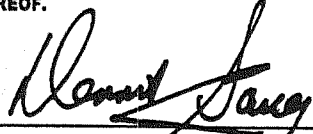SIGNED 
Dennis C. Sauer
Registered Land Surveyor S-2421

XTCA-91

002-2374