
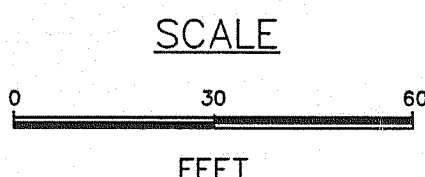


LEGAL DESCRIPTION:

LOT 20 OF "THE FIELD OF DELAVAN WEST" BEING A REDIVISION OF PART OF "THE FIELDS OF DELAVAN" BEING A PART OF THE NORTHWEST $\frac{1}{4}$ AND THE SOUTHWEST $\frac{1}{4}$ OF THE SOUTHWEST $\frac{1}{4}$ OF SECTION 13, TOWN 2 NORTH, RANGE 15 EAST, IN THE CITY OF DELAVAN, COUNTY OF WALWORTH, STATE OF WISCONSIN.

LOT AREA: 16,073 SQ.FT.

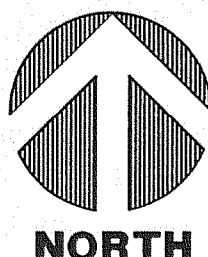

STATE OF WISCONSIN
COUNTY OF RACINE


The above-described property has been surveyed under my direction and the above map is a correct representation thereof.

DATED AT: NORTH CAPE, THIS 14th DAY OF MARCH, 2007.

Pete L. Bailey
AMERICAN SURVEYING COMPANY, INC.
PETE L. BAILEY, RLS NO. 1398
RECERTIFIED this 7TH day of JUNE, 2007.



949.82
SS MH
RIM: 949.82
INV: 939.76

-DWELLING UNDER CONSTRUCTION
-BASEMENT, INSULATION, STEEL
-TOP OF WALL: 952.59
-TOP OF FOOTING: 943.36

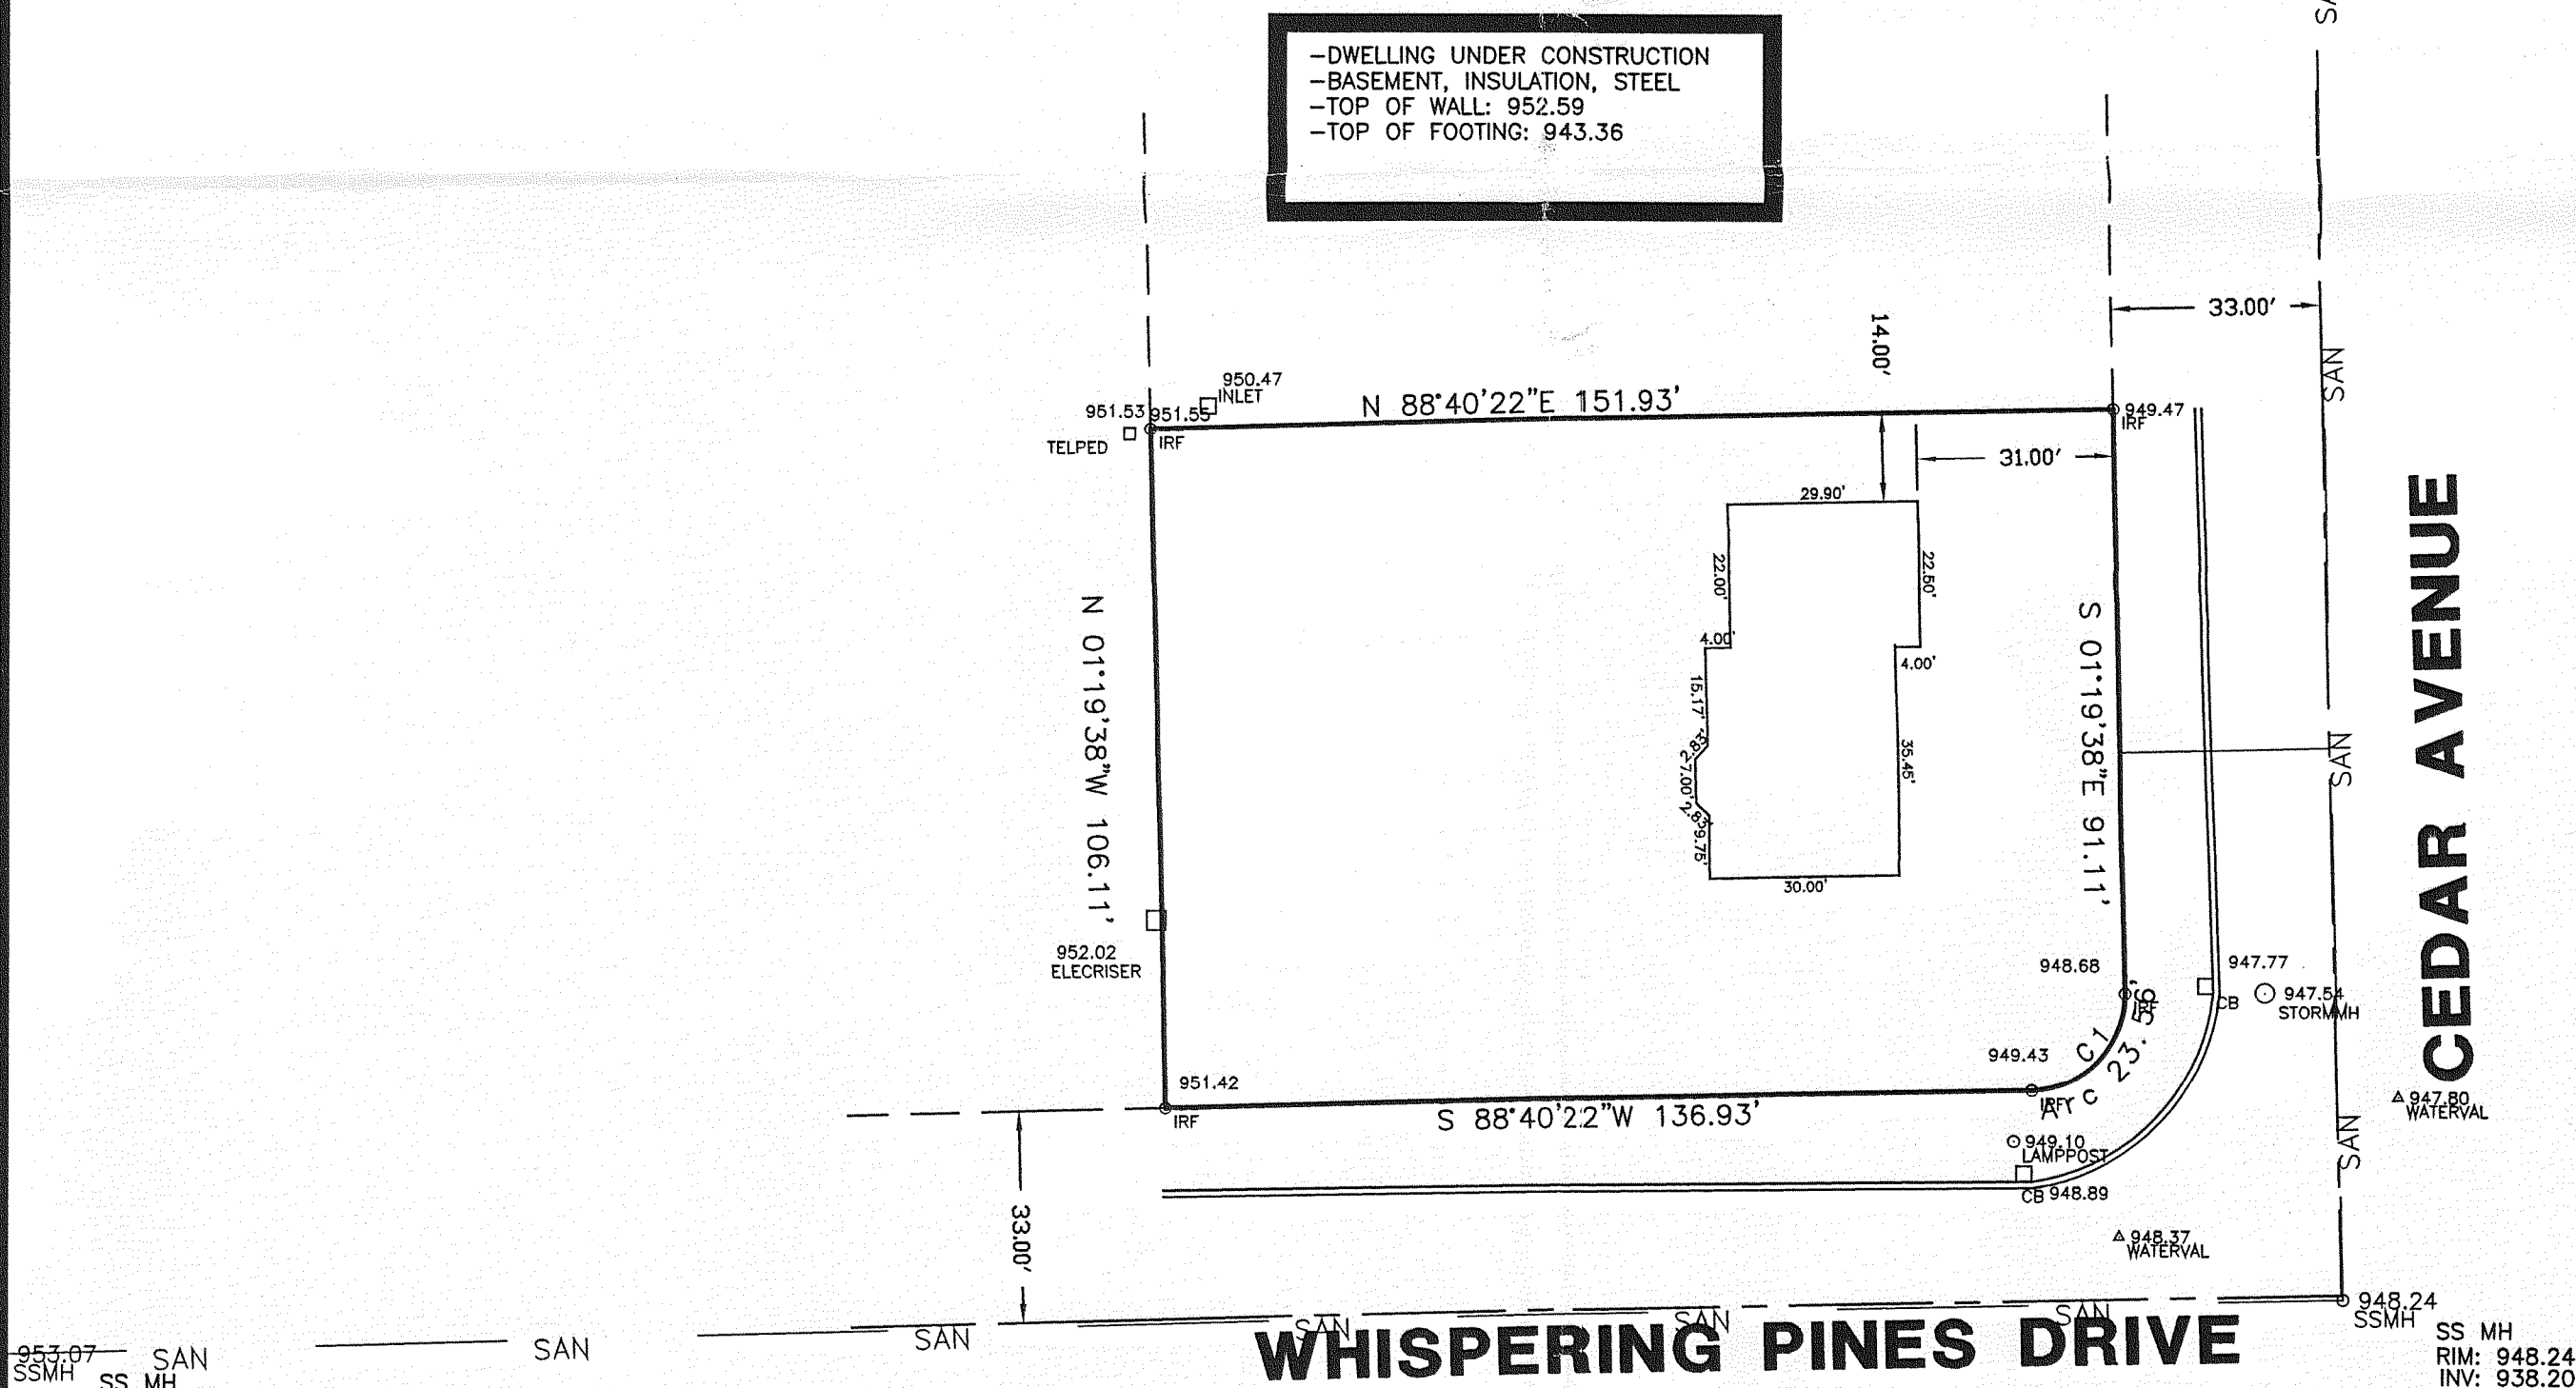

Curve	Radius	Tangent	Length	Delta	Chord	Chord Bear.
C1	15.00'	15.00'	23.56'	89°59'56"	21.21'	S 43°40'22" W

OWNERS: JASON & SUZIE LEINFELDER

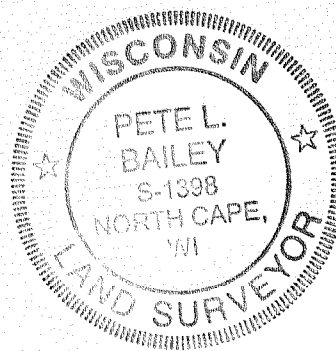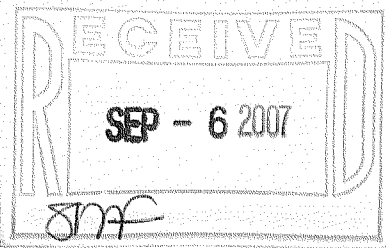

**AMERICAN
SURVEYING
COMPANY, INC.**

12207 C.T.H. "K" FRANKSVILLE, WISCONSIN 53126
TEL. (262) 835-4774 FAX: (262) 835-2379
beaufordbailey@hotmail.com

DRAWN BY:	PLB	REVISIONS:	DATE
CHECKED BY:	PLB	03/23/07: REVISED GARAGE SLAB CORRECTED CITY NAME	
PLOT SCALE:	1 = 30		
DATE:	03/04/2007		
JOB NO.:	07.011		
DWG. FILE:	JN207058R	CLIENT NO.	00010

CITY OF DELAVAN

PROJECT:

PLAT OF SURVEY/STAKE OUT SURVEY

PREPARED FOR: BADGER HOME BUILDERS, INC.

Sheet
1
of
1