


WALNUT STREET

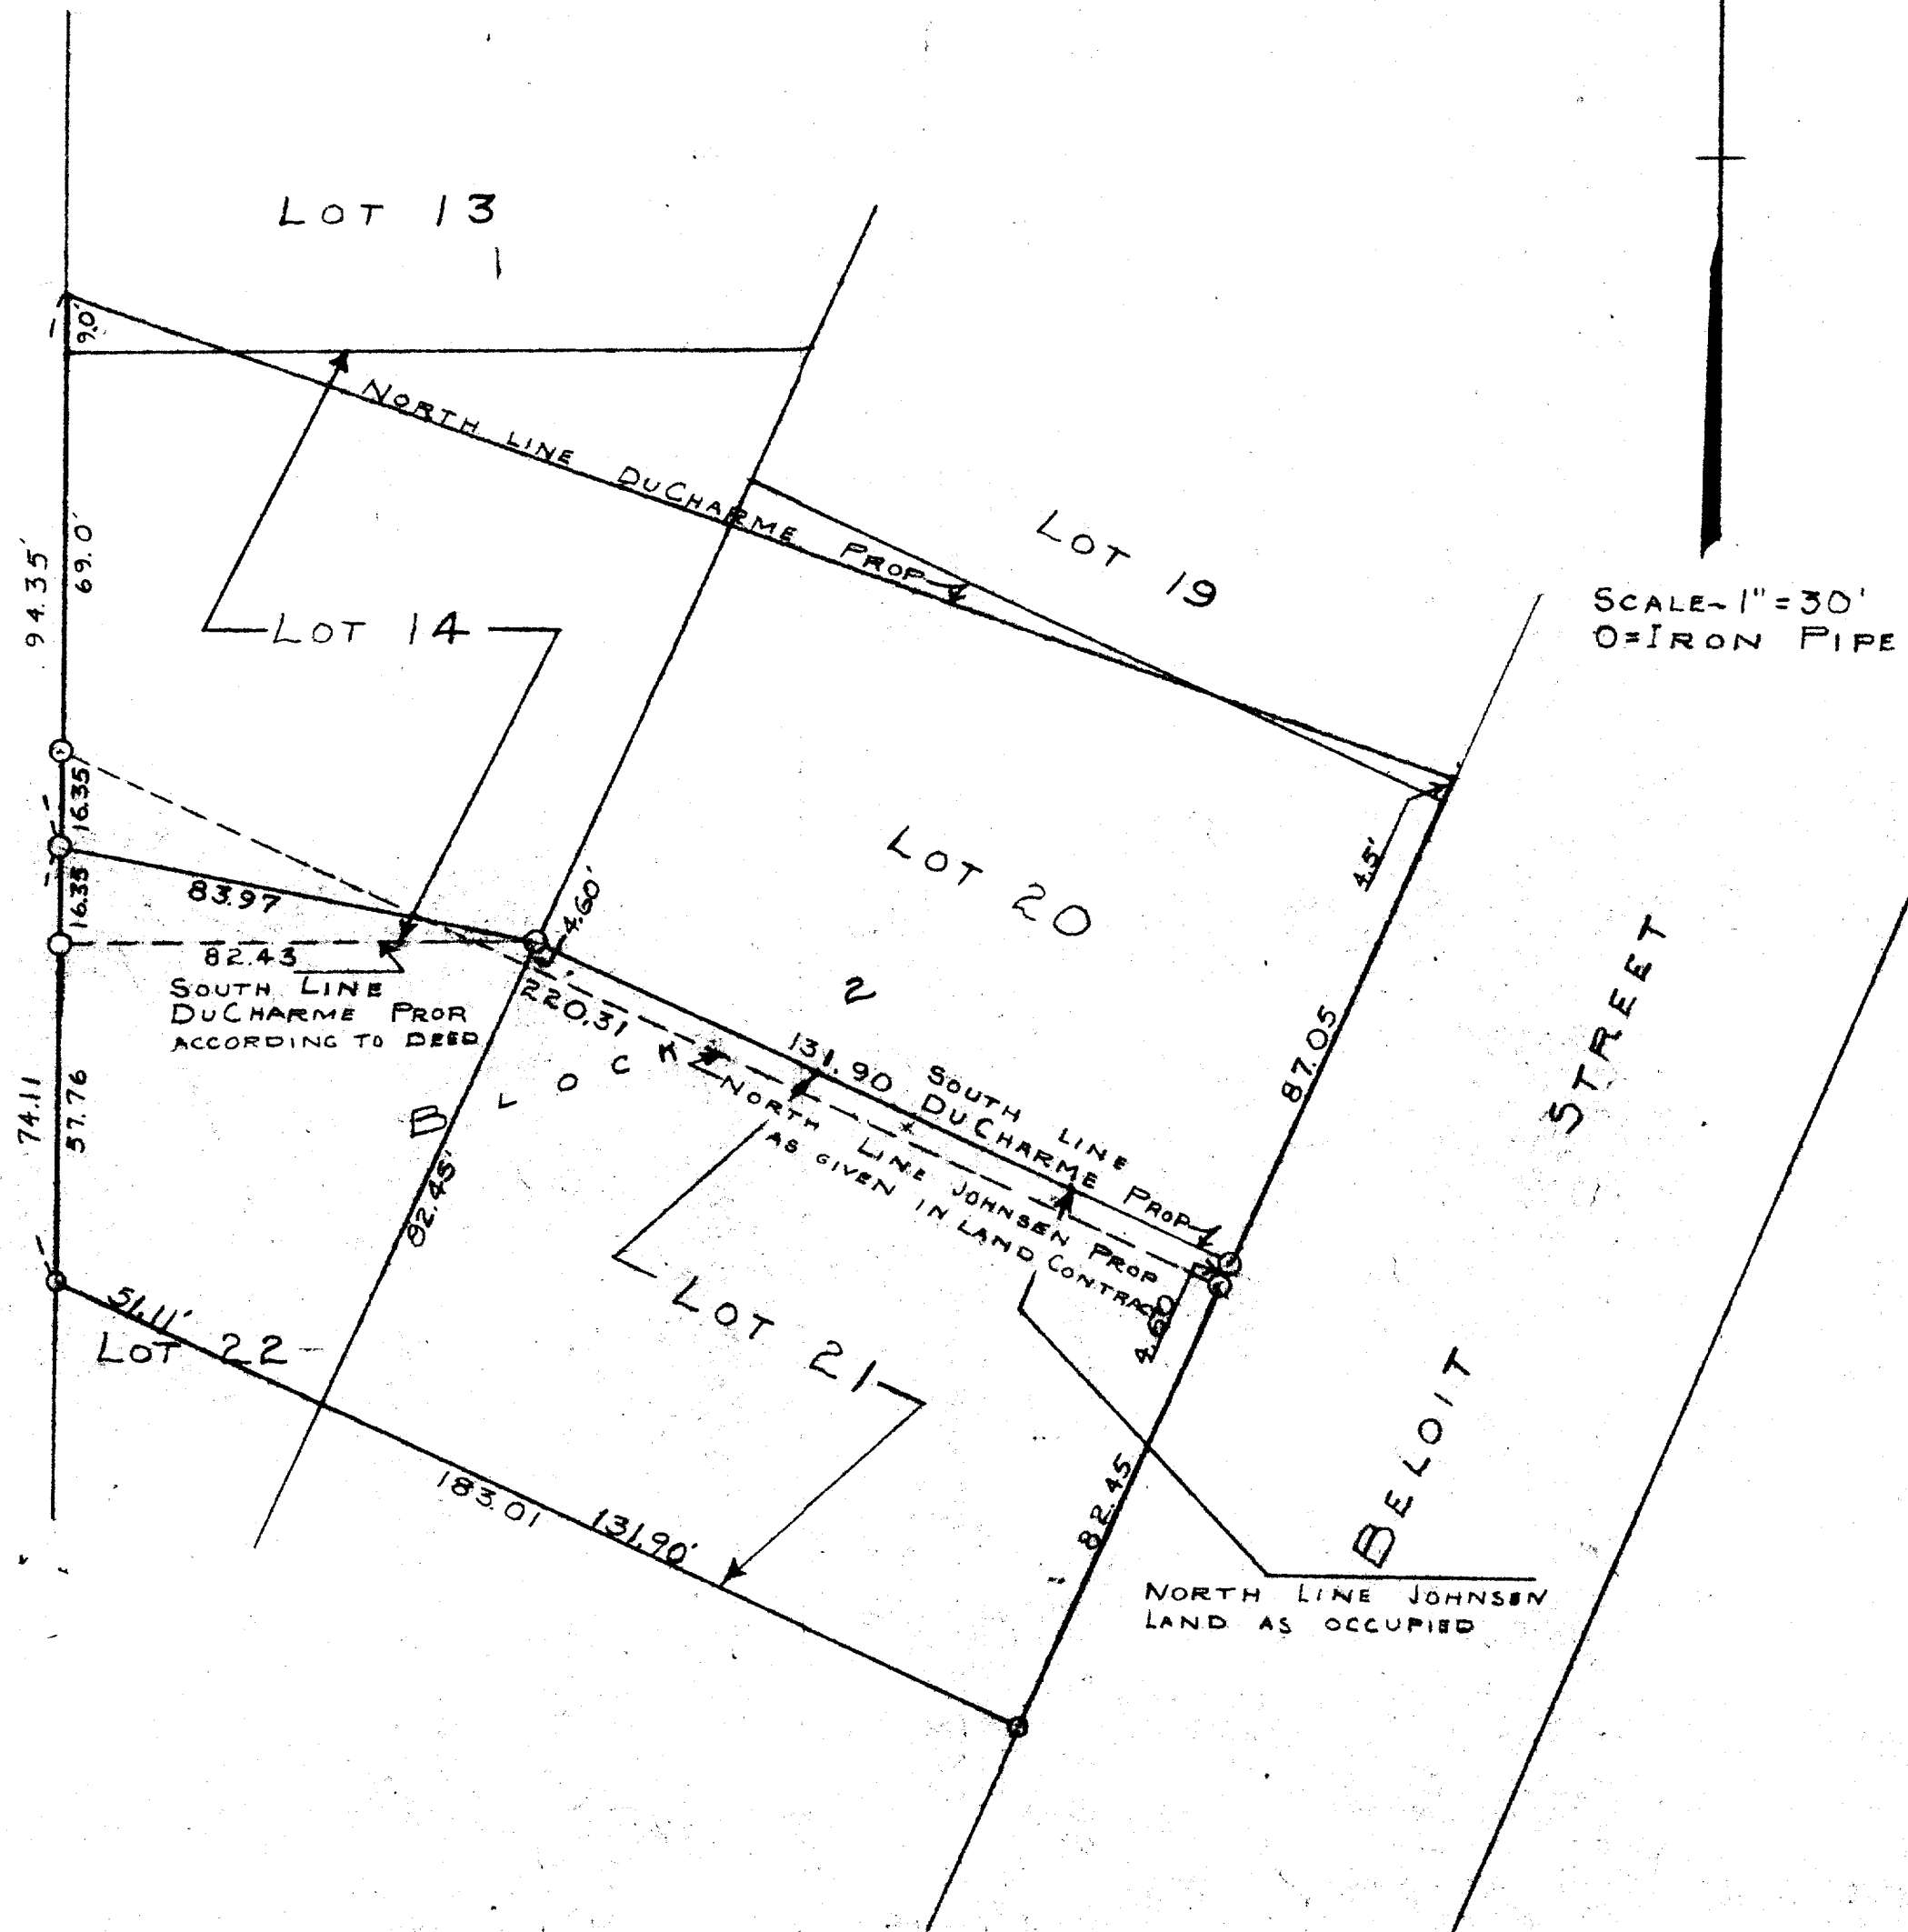

PLAT OF SURVEY OF LAND LOCATED IN BLOCK 2, F. K.
PHOENIX WEST ADDITION TO CITY OF DELAVAN, WAUWATOSA
COUNTY, WISCONSIN
DECEMBER 1951

Lloyd L. Jensen 2-23 J
COUNTY SURVEYOR

PRR-7 + 8,741