

STATE OF WISCONSIN
COUNTY OF RACINE

I HEREBY CERTIFY THAT I HAVE SURVEYED THE ABOVE DESCRIBED PROPERTY AND THE ABOVE MAP IS A TRUE REPRESENTATION THEREOF AND SHOWS THE SIZE AND LOCATION OF THE PROPERTY, ITS EXTERIOR BOUNDARIES, THE LOCATION OF ALL VISIBLE STRUCTURES AND EASEMENTS OF ALL PRINCIPAL BELONGING THERETO, BOUNDARY LINES, APPROPRIATE EASEMENTS, ROADWAYS AND VISIBLE ENCROACHMENTS, IF ANY.



THIS SURVEY IS MADE FOR THE PRESENT OWNERS OF THE PROPERTY, AND ALSO THOSE WHO PURCHASE, MORTGAGE, OR GUARANTEE THE TITLE THEREOF WITHIN ONE (1) YEAR FROM THE DATE THEREOF.

DATED AT: NORTH CAPE, THIS 16TH DAY OF JANUARY, 2008.

AMERICAN SURVEYING COMPANY, INC.


PETE L. BAILEY, RLS NO. 1398

RECERIFIED this _____ day of _____, 2008.

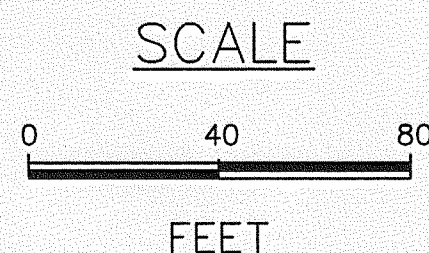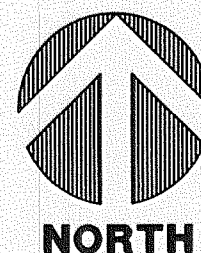

LEGAL DESCRIPTION:

BUILDINGS NUMBERS 6 AND 8 OF "FIELDS OF DELIVAN CONDOMINIUM" BEING A PART OF THE SOUTHWEST $\frac{1}{4}$ OF THE SOUTHWEST $\frac{1}{4}$ OF SECTION 13, TOWN 2 NORTH, RANGE 15 EAST, IN THE CITY OF DELIVAN, COUNTY OF WALWORTH, STATE OF WISCONSIN. ACCORDING TO THE RECORDED PLAT THEREOF.

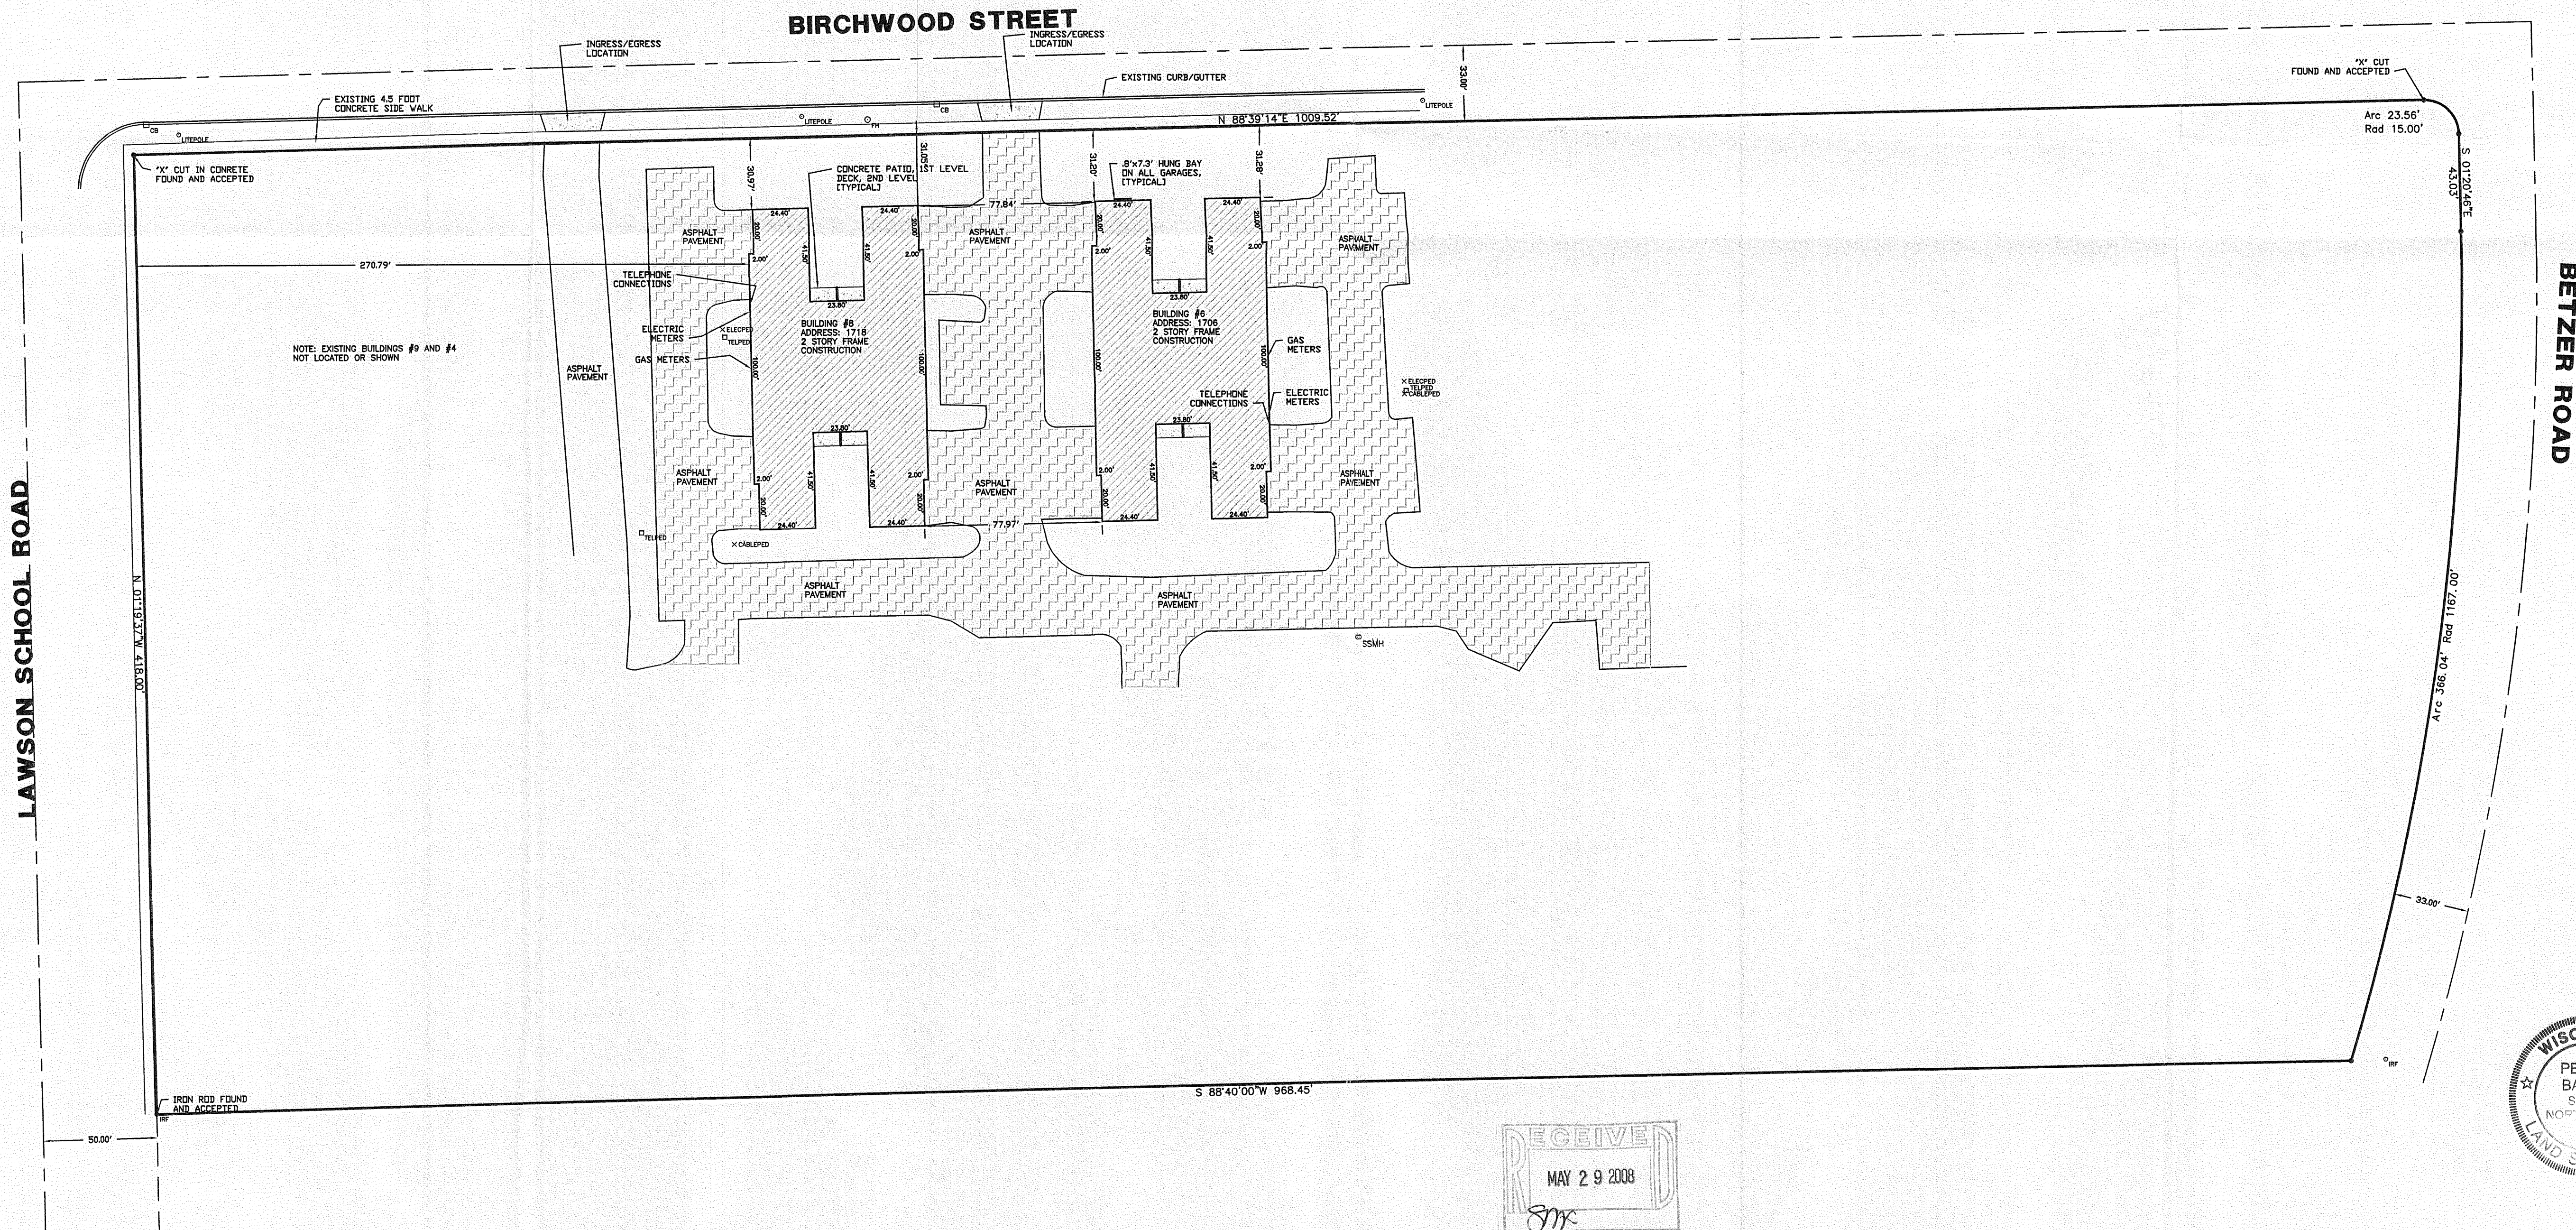


		AMERICAN SURVEYING COMPANY, INC.	
12207 C.T.H. "K" FRANKSVILLE, WISCONSIN 53126		TEL. (262) 835-4774 FAX: (262) 835-2379	
beau@fordbottle.com			
DRAWN BY:	PLB	REVISIONS:	DATE
CHECKED BY:	PLB		
PLOT SCALE:	1 = 40		
DATE:	01/16/2008		
JOB NO.:	2008004		
DWG. FILE:	JN208009	CLIENT NO:	03733

CITY OF DELIVAN



PROJECT:
PLAT OF SURVEY / BOUNDARY SURVEY
PREPARED FOR: IMPERIAL INVESTMENTS, INC

Sheet
1
of
1

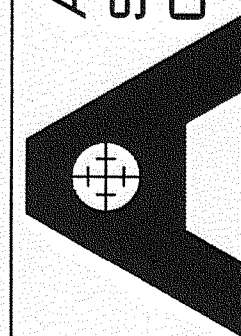

**AMERICAN
SURVEYING
COMPANY, INC.**

12207 C.T.H. "K" FRANKSVILLE, WISCONSIN 53126
TEL. (262) 835-4774 FAX: (262) 835-2379
beaufordbailey@hotmail.com

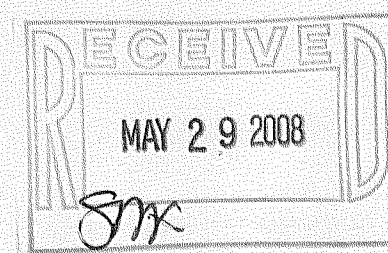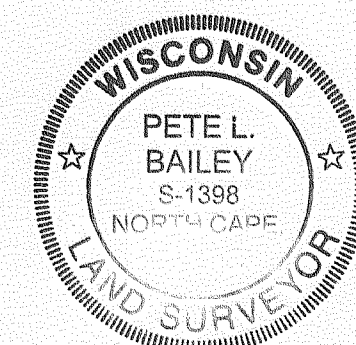

XFIE-6 XFIE-8

002-2487