


GEORGE T. DUNHAM  
 SURVEYING & SUBDIVIDING  
 DELAVAN, WISCONSIN

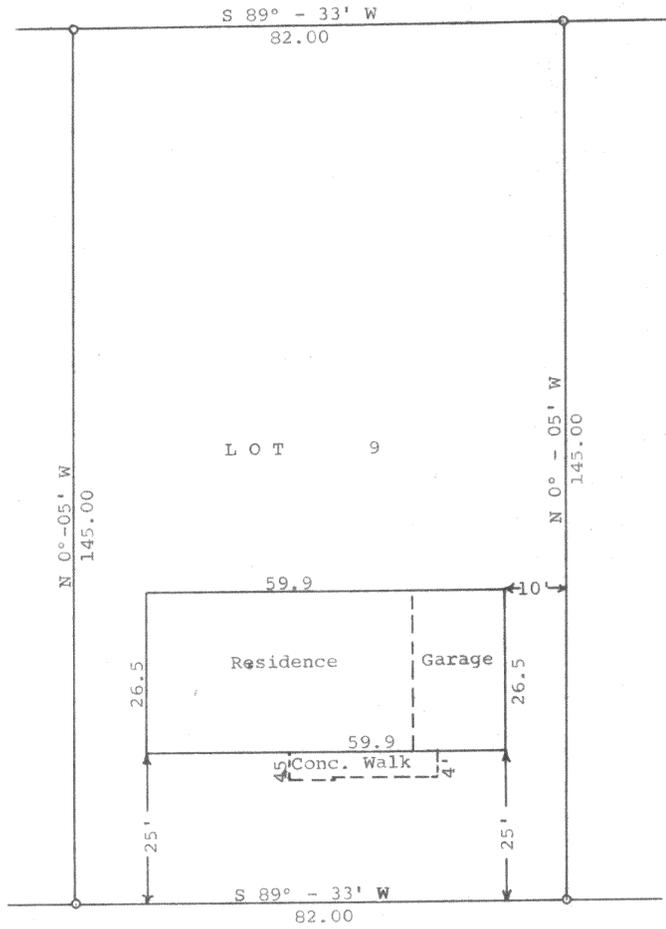

Scale - 1" = 20'  
 ○ = Iron Pipe

GENEVA

STREET

STATE OF WISCONSIN) SS  
 WALWORTH COUNTY )

I, George T. Dunham, Surveyor, do certify that I have surveyed the property described as follows,

Lot 9, Block 5, Springs Park Subdivision located in the City of Delavan, Walworth County, Wisconsin and that the above plat is an accurate survey and a true representation thereof and correctly shows the exterior boundary lines and location of the residence built thereon and the correct measurements thereof.  
 February 3, 1966

*George T. Dunham*  
 George T. Dunham, Surveyor S-306