


1046-800

SURVEY FOR: SOUTHEASTERN WISCONSIN
HOUSING CORPORATION

PROPERTY ADDRESS: _____ AUTUMN DRIVE
TOP OF FOUNDATION: 102.5

I HEREBY CERTIFY THAT THE EXISTING FOUNDATION SHOWN ON THIS PLAT OF SURVEY IS LOCATED AS SHOWN THUS (), DATED THIS 29TH DAY OF OCTOBER, 2008.

Thomas L. Satter
THOMAS L. SATTER S-2850

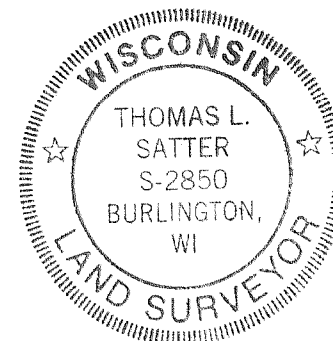

THIS IS NOT AN ORIGINAL PRINT
UNLESS THIS SEAL IS RED.


Thomas L. Satter
THOMAS L. SATTER S-2850

SEPTEMBER 17, 2008
DATE

7911
JOB NUMBER


"I hereby certify that I have surveyed the above described property and that the above map is a correct representation thereof and shows the size and location of the property, its exterior boundaries, the location of all visible structures and dimensions of all principal buildings thereon, boundary fences, apparent easements, roadways and encroachments, if any."

"This survey is made for the use of the present owners of the property, and those who purchase, mortgage, or guarantee the title thereto within one year from date hereof."

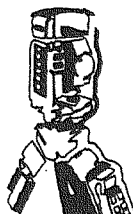

B.W. SURVEYING, INC.

412 N. PINE STREET
BURLINGTON, WI 53105
(262)-767-0225

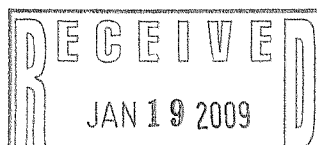

By DMK

SCALE

$$1'' = 30'$$

LEGEND

0 FOUND IRON ROD
21.0 EXISTING ELEVATION

XCRW1-44

002-246