


1140 SEQUOIA STREET • DELAVAN, WISCONSIN 53115
262-728-6737

9 9

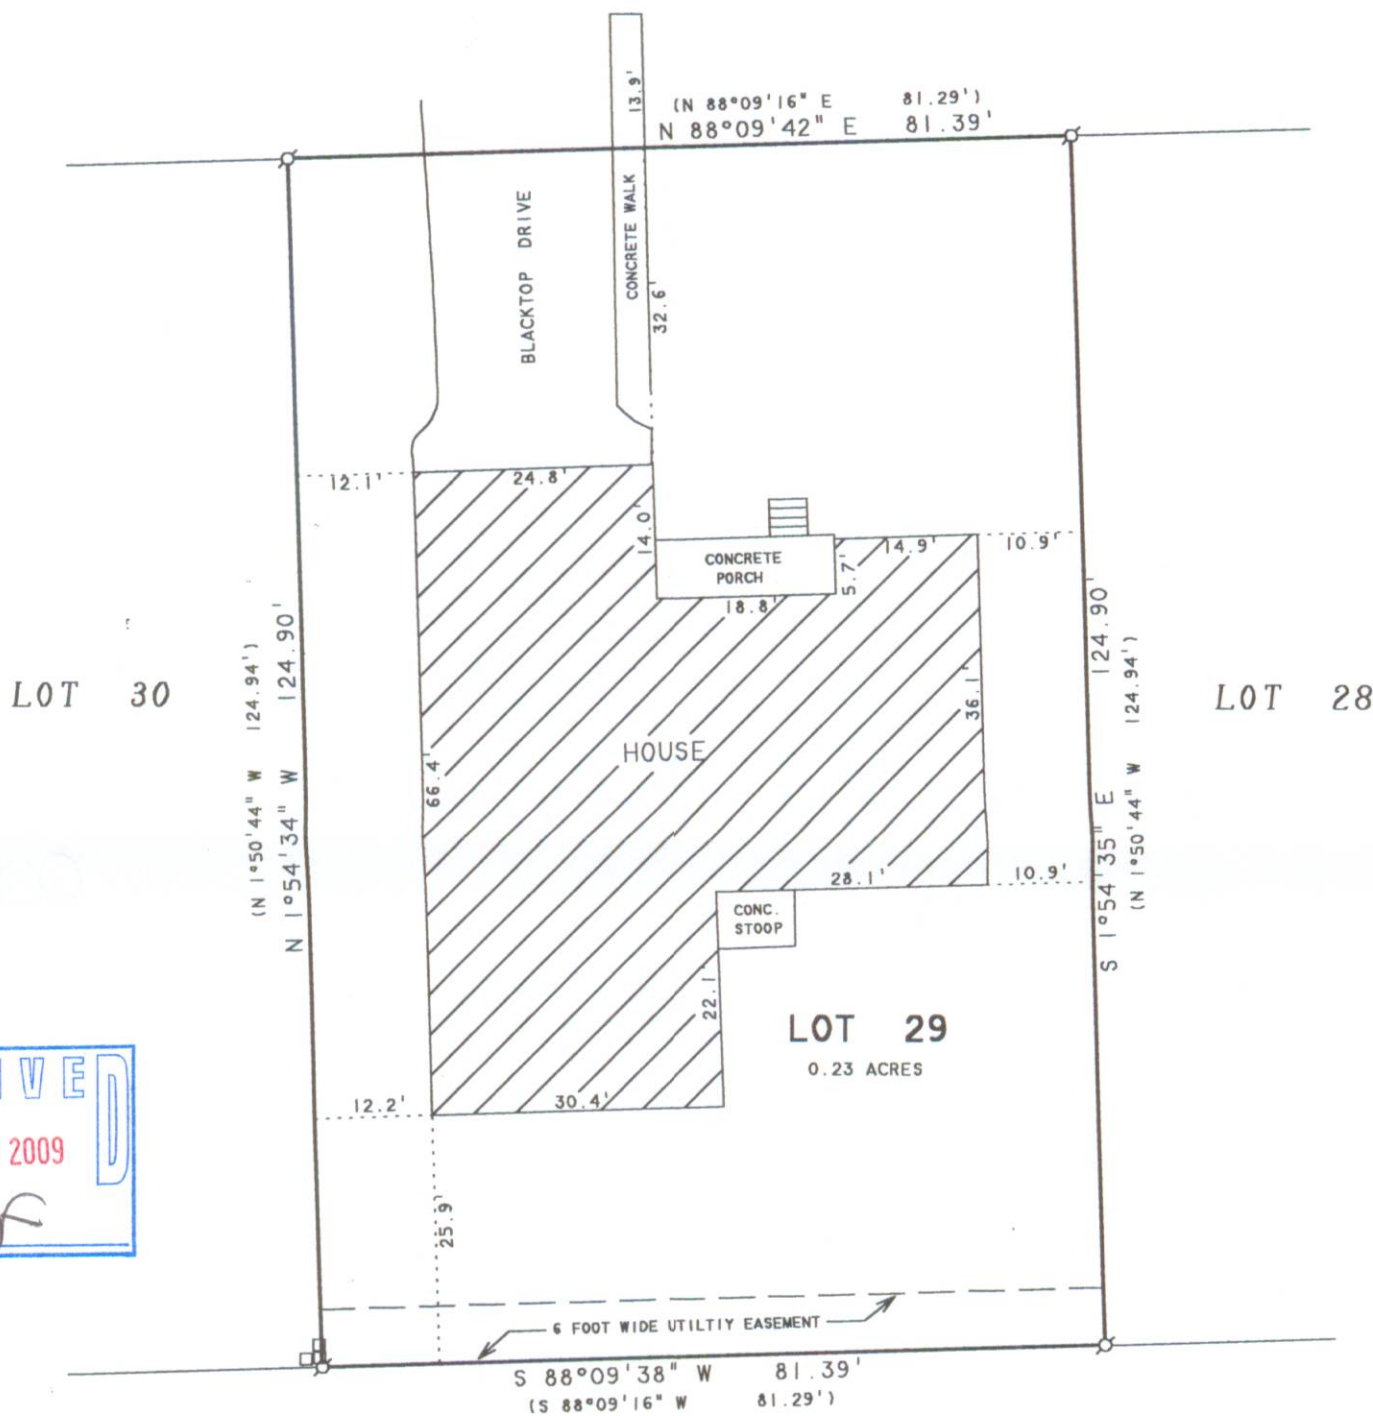

LOT 29 OF FIRST ADDITION TO TOD MILLER SUBDIVISION,
LOCATED IN THE NORTHWEST 1/4 OF SECTION 20 AND IN
THE NORTHEAST 1/4 OF SECTION 19, T2N,R16E, CITY OF
DELAN, WALWORTH COUNTY, WISCONSIN

 $\mathcal{N}$ 

Ø - IRON PIPE FOUND
□□ - UTILITY PEDS.
() - RECORDED AS

Daniel F. Ball

November 18, 2009

DATE _____ JOB NUMBER - 09044
NOTE: THIS IS NOT A CERTIFIED COPY UNLESS SEALED.

XM1A-3

002-2484