




SCALE 1"=20'
O=IRON PIPE

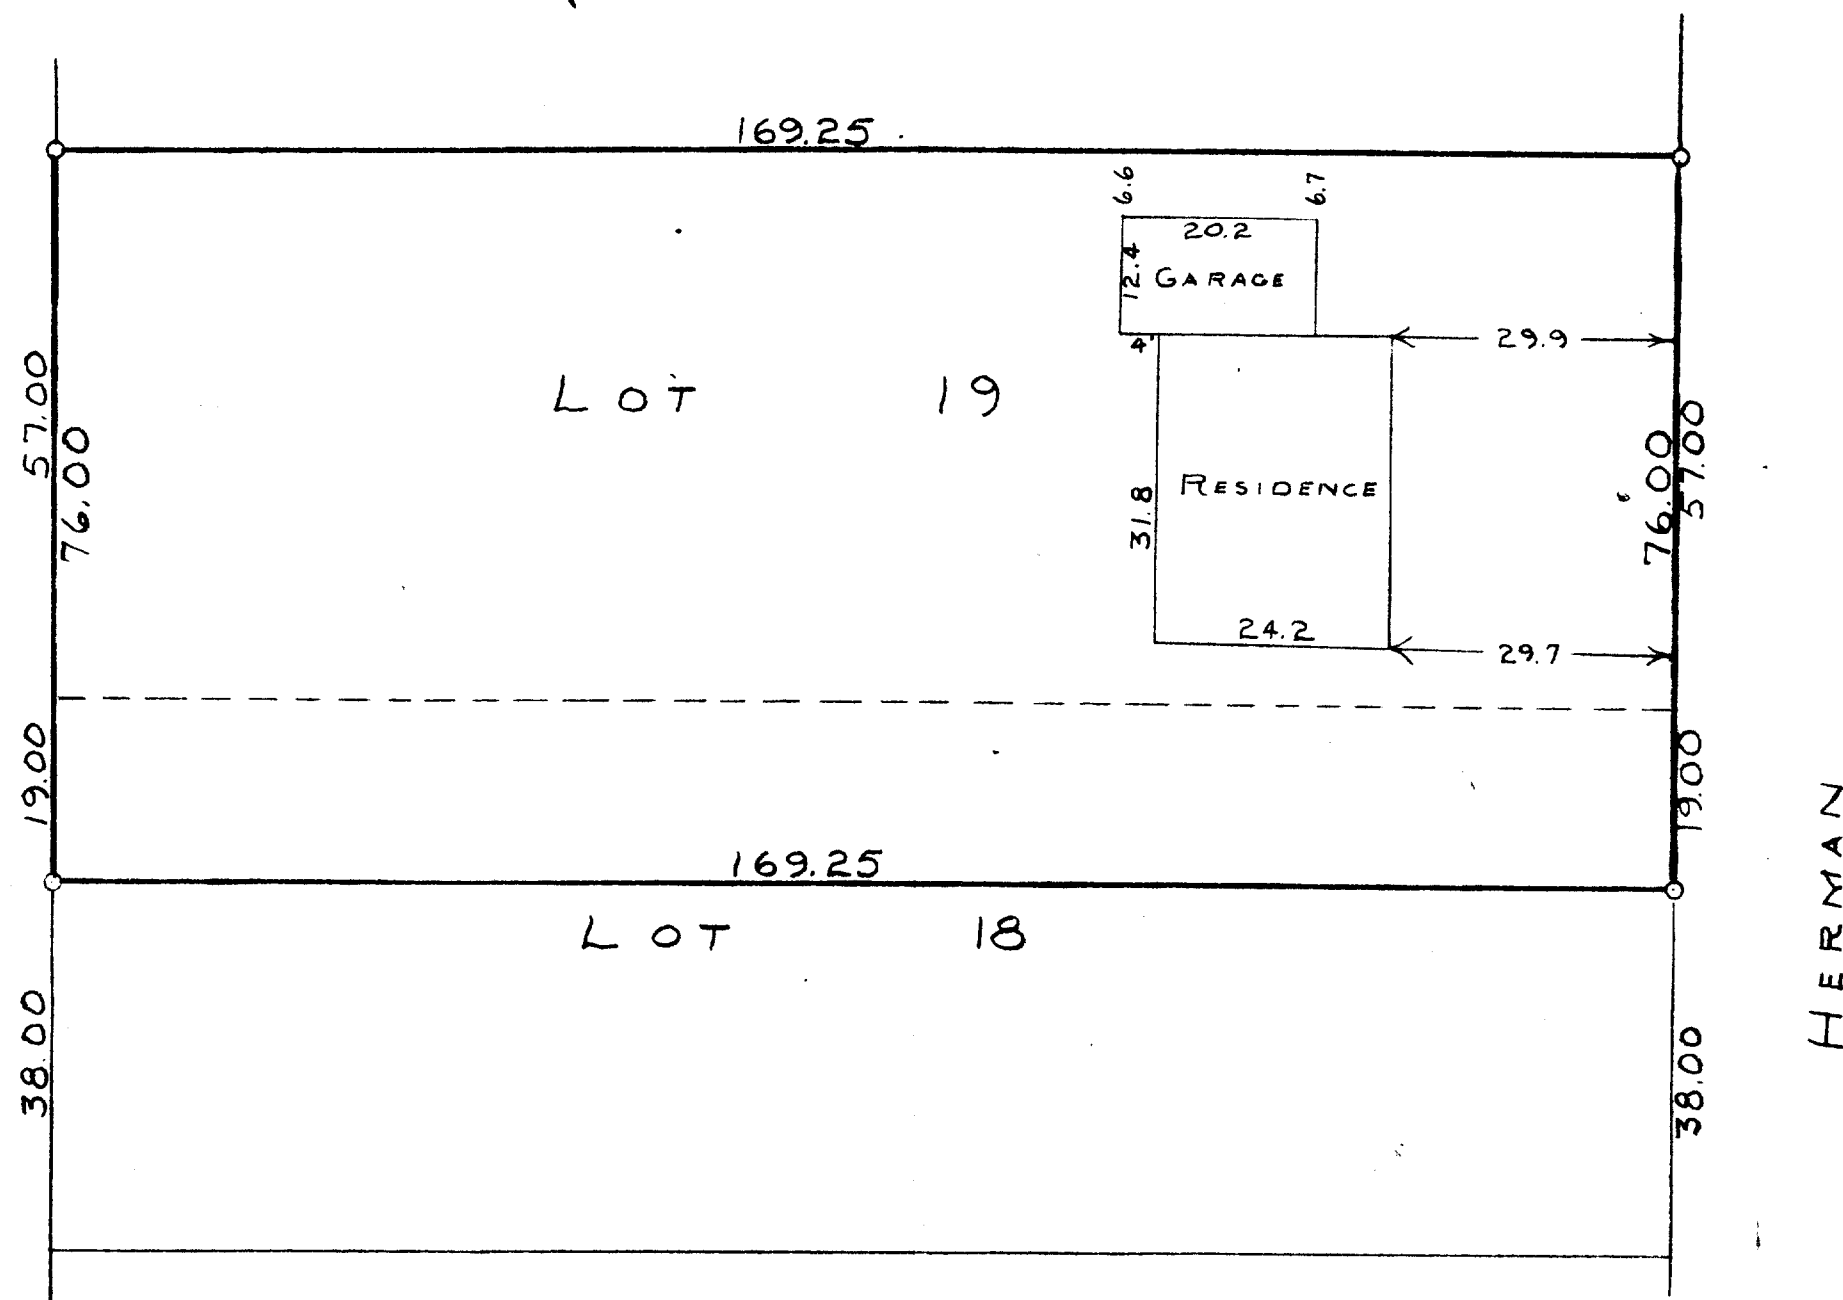

STATE OF WISCONSIN) ss
COUNTY OF WALWORTH)

I, GEORGE T. DUNHAM, DO HEREBY CERTIFY THAT I HAVE SURVEYED THE
PROPERTY DESCRIBED AS FOLLOWS:

LOT 19 AND THE NORTH 1/3 OF LOT 18, BLOCK 3 OF FAIRVIEW HEIGHTS
LOCATED IN THE CITY OF DELAVAN, WALWORTH COUNTY, WISCONSIN
AND THAT THE PLAT SHOWN ABOVE IS A CORRECT REPRESENTATION OF THE
PROPERTY LINES.
JUNE 9, 1955

George T. Dunham
GEORGE T. DUNHAM, SURVEYOR
DELAVAN, WISCONSIN