


PLAT OF SURVEY -OF-



LOT 3 OF LAUREL HEIGHTS, A SUBDIVISION BEING LOCATED IN THE CITY OF DELAVAN, ACCORDING TO THE PLAT THEREOF, RECORDED IN VOLUME 12 OF PLATS ON PAGE 34, WALWORTH COUNTY, WISCONSIN.

SURVEY FOR: BEAR REALTY

SURVEY ADDRESS: 512 LAUREL HEIGHTS DRIVE

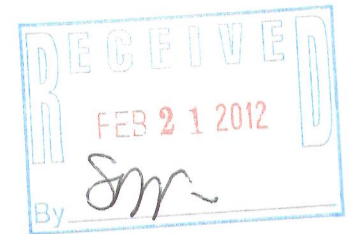

LAUREL HEIGHTS DRIVE
(75' WIDE)

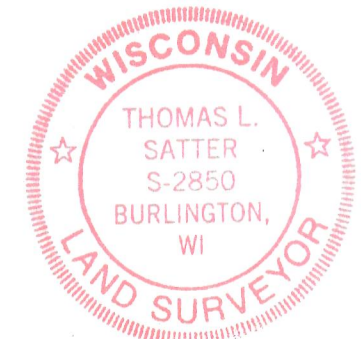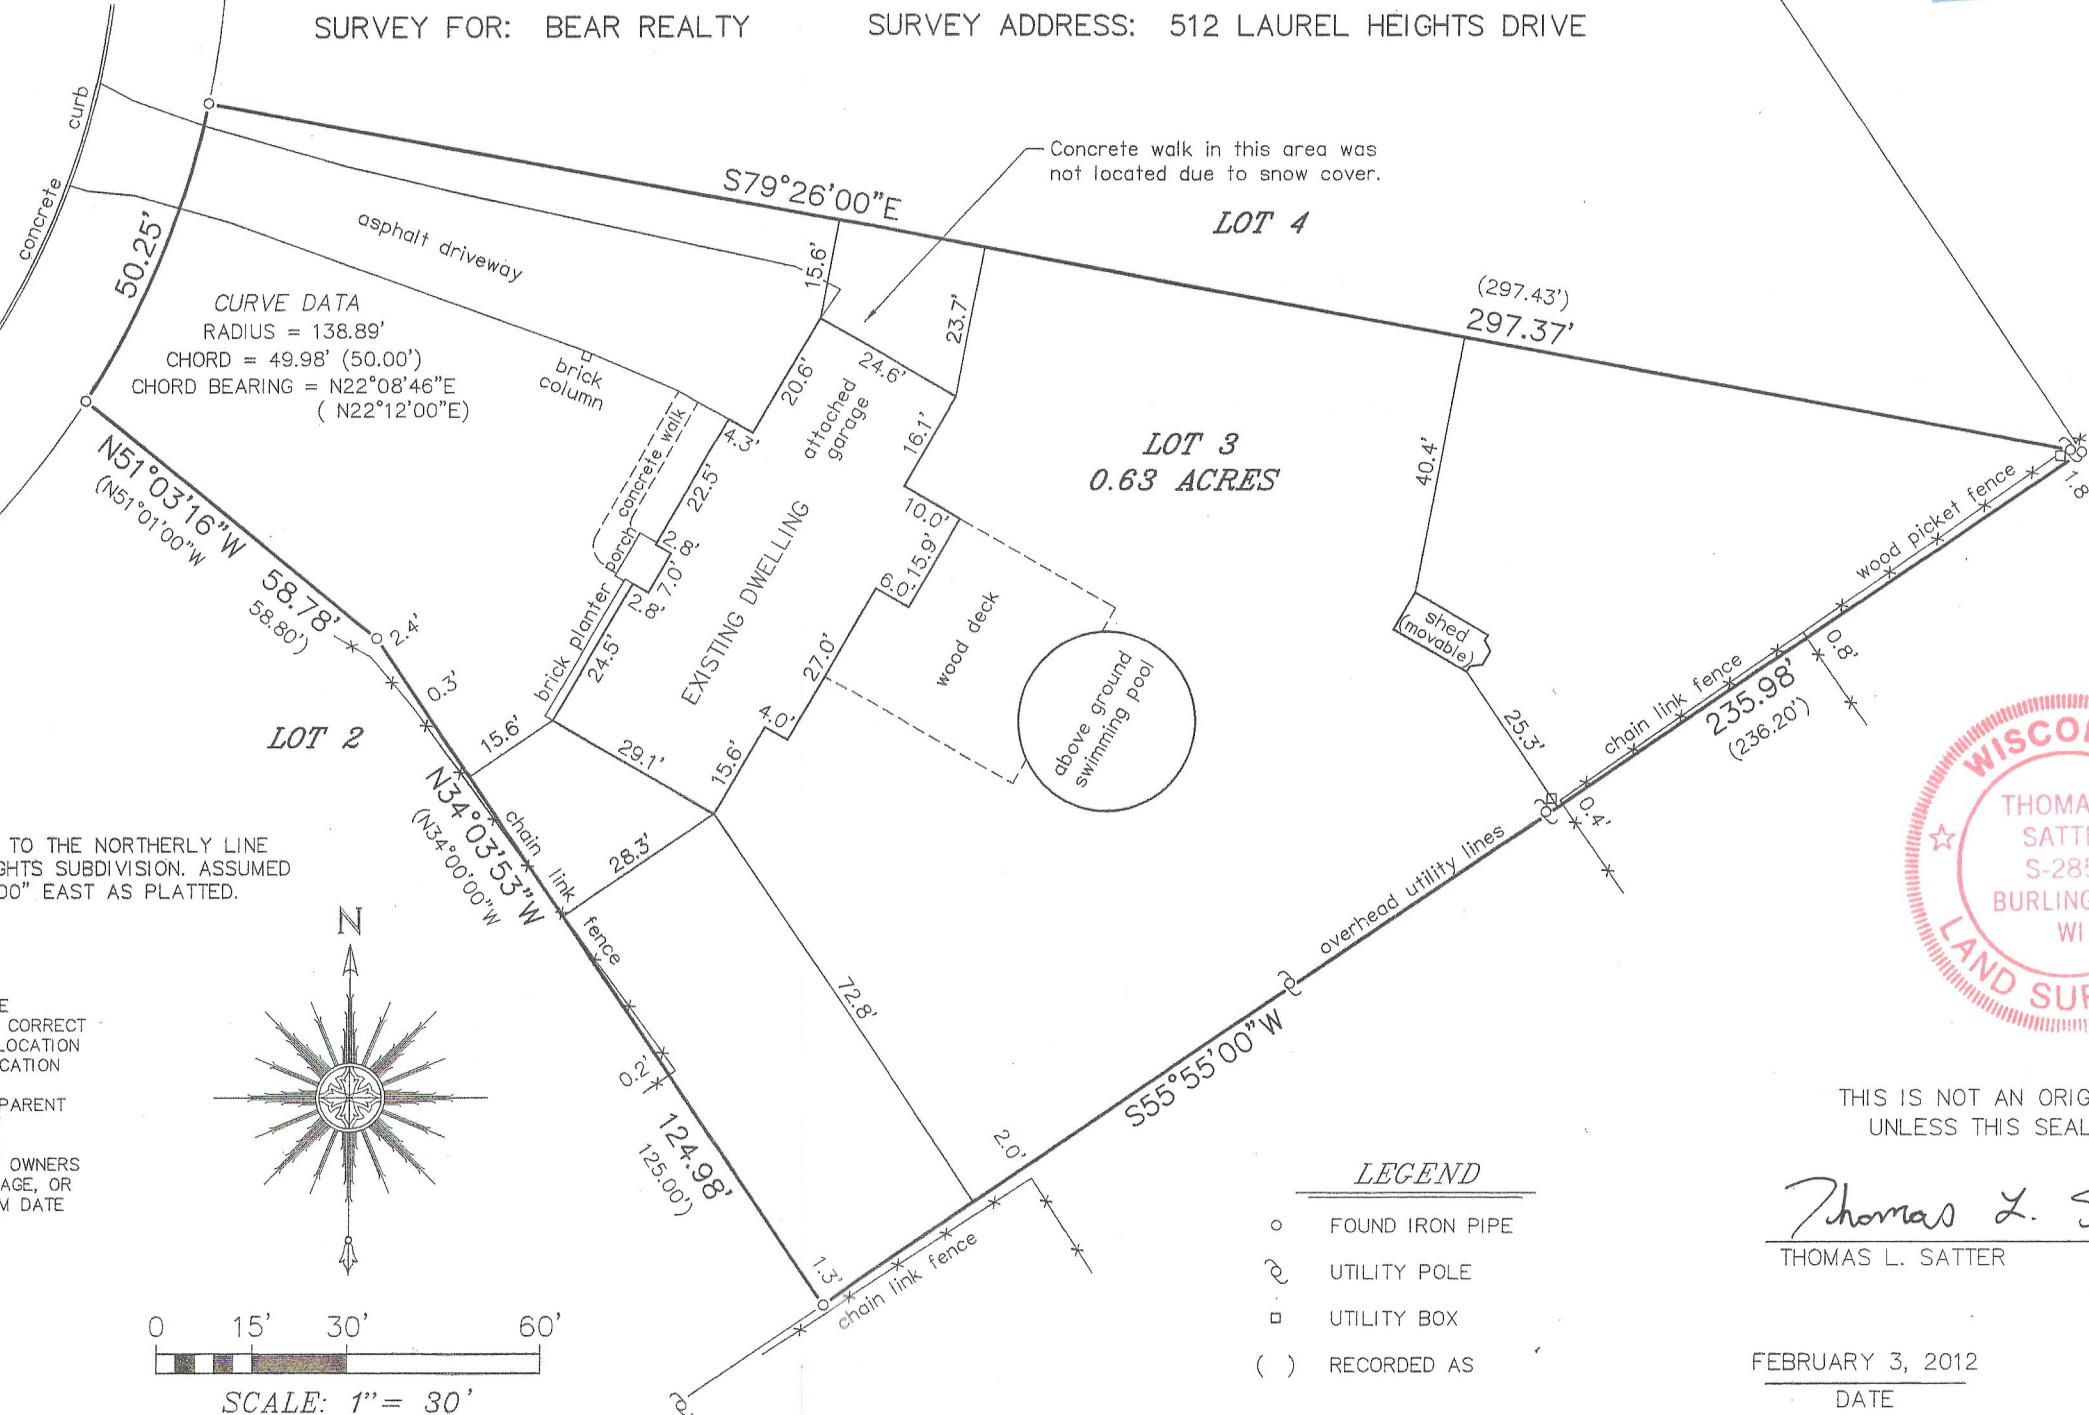

THIS IS NOT AN ORIGINAL PRINT
UNLESS THIS SEAL IS RED.


Thomas L. Satter
THOMAS L. SATTER S-2850

FEBRUARY 3, 2012 011205
DATE JOB NUMBER

"I HEREBY CERTIFY THAT I HAVE SURVEYED THE ABOVE DESCRIBED PROPERTY AND THAT THE ABOVE MAP IS A CORRECT REPRESENTATION THEREOF AND SHOWS THE SIZE AND LOCATION OF THE PROPERTY, ITS EXTERIOR BOUNDARIES, THE LOCATION OF ALL VISIBLE STRUCTURES AND DIMENSIONS OF ALL PRINCIPAL BUILDINGS THEREON, BOUNDARY FENCES, APPARENT EASEMENTS, ROADWAYS AND ENCROACHMENTS, IF ANY."

"THIS SURVEY IS MADE FOR THE USE OF THE PRESENT OWNERS OF THE PROPERTY, AND THOSE WHO PURCHASE, MORTGAGE, OR GUARANTEE THE TITLE THERETO WITHIN ONE YEAR FROM DATE HEREOF."

SATTER SURVEYING, LLC
LAND SURVEYS, MAPPING AND PLANNING
272 ORIGEN STREET
BURLINGTON, WI 53105
262-661-4239

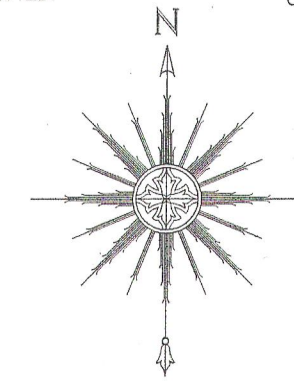

0 15' 30' 60'
SCALE: 1" = 30'

XL14-3

002-2515