

FARRIS, HANSEN & ASSOC. INC.

7 RIDGWAY COURT- P.O. BOX 437
ELKHORN, WISCONSIN 53121
PHONE (262) 723-2098
FAX (262) 723-5886

PLAT OF SURVEY


LOT 46 OF WHISPERING PINES
LOCATED IN THE NE 1/4 & SE 1/4 OF SEC. 13
TOWN 2 NORTH, RANGE 15 EAST
CITY OF DELAVAN, WALWORTH COUNTY, WI.

ORDERED BY: BILL MITCHELL
128 EVERGREEN DRIVE
DELAVAN, WI. 53115


ASSIGNED WEST LINE EVERGREEN DRIVE
S 00°24'36" E

Lot 46 of Whispering Pines as recorded under Document No. 201085, located in the NE 1/4 and the SE 1/4 of Section 13, T2N, R19E, in the City of Delavan, Walworth County, Wisconsin.

Parcel No.:
XWP 00046

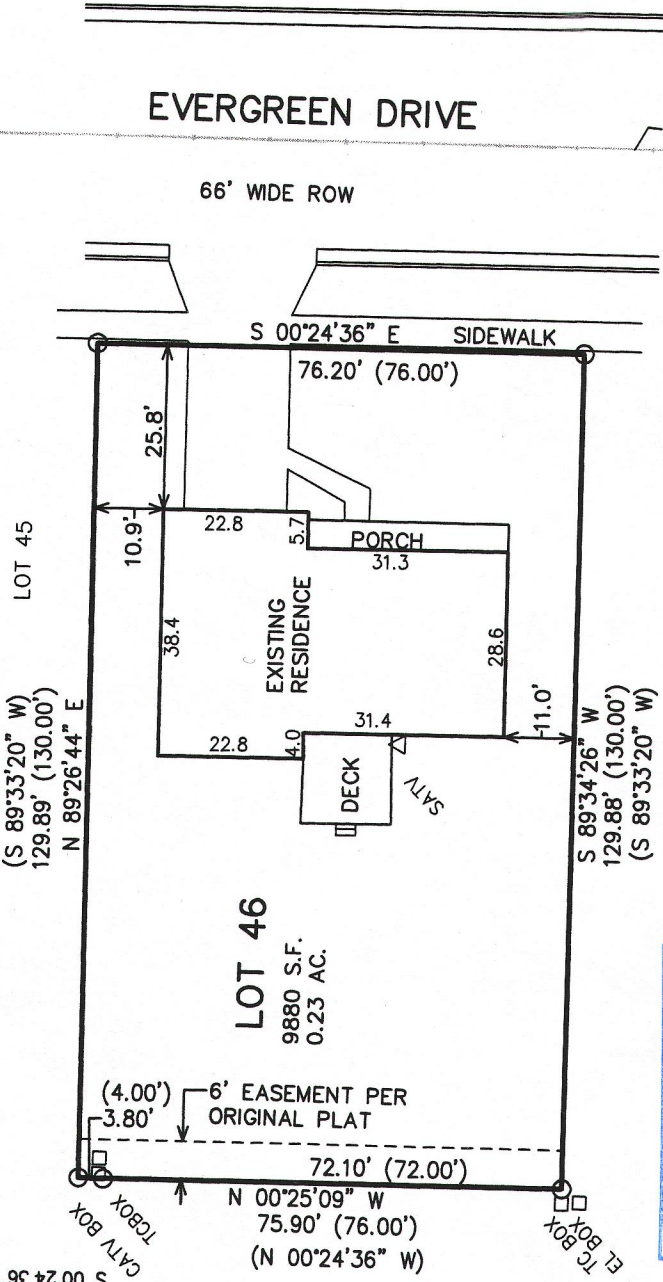

LEGEND
O = FOUND IRON PIPE STAKE
(xxx) = RECORDED AS

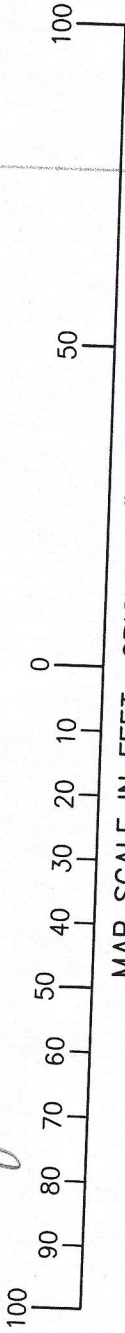

NOTE: COPIES OF THIS MAP TO WHICH THE FOLLOWING CERTIFICATE WILL APPLY SHOW THE SURVEYOR'S ORIGINAL SEAL AND SIGNATURE IN RED INK. COPIES BY ANY OTHER MEANS MAY HAVE ALTERATIONS WHICH DO NOT REPRESENT THE SURVEYOR'S WORK PRODUCT.

I HEREBY CERTIFY THAT THE ABOVE DESCRIBED PROPERTY HAS BEEN SURVEYED UNDER MY DIRECTION AND THAT THE ABOVE MAP IS A TRUE REPRESENTATION THEREOF AND SHOWS THE SIZE AND LOCATION OF THE PROPERTY, ITS EXTERIOR BOUNDARIES, AND LOCATION OF ALL VISIBLE STRUCTURES, AND DIMENSIONS OF ALL PRINCIPLE BUILDINGS THEREON, BOUNDARY FENCES, APPARENT EASEMENTS, ROADWAYS, AND VISIBLE ENCROACHMENTS, IF ANY. THIS SURVEY IS MADE FOR THE USE OF THE PRESENT OWNERS OF THE PROPERTY, AND ALSO THOSE WHO PURCHASE, MORTGAGE, OR GUARANTEE THE TITLE THERETO WITHIN ONE YEAR FROM THE DATE HEREOF.



DATED: MAY 30, 2013

PROJECT NO. 8811
DATED: 05-30-2013
SHEET 1 OF 1 SHEETS

PETER S. GORDON

XWP -46

002-2532