

PREPARE FOR:
MARY KILKENNY
KEEFE REAL ESTATE
DELAVAN, WI.


PLAT OF SURVEY

- OF -


PATHFINDER SURVEYING INC.
(formerly)
J.K. SURVEYING INC.
P.O. BOX 322
LAKE GENEVA, WI. 53147
WWW.PATHFINDERSURVEYING.NET
262-248-8303

LOT 37 AND THE WEST 20 FEET OF LOT 36, LAUREL HEIGHTS ADDITION
TO THE CITY OF DELAVAN, LOCATED IN SECTION 17, TOWN 2 NORTH,
RANGE 16 EAST, CITY OF DELAVAN, WALWORTH COUNTY, WISCONSIN.

LAUREL HEIGHTS DR.

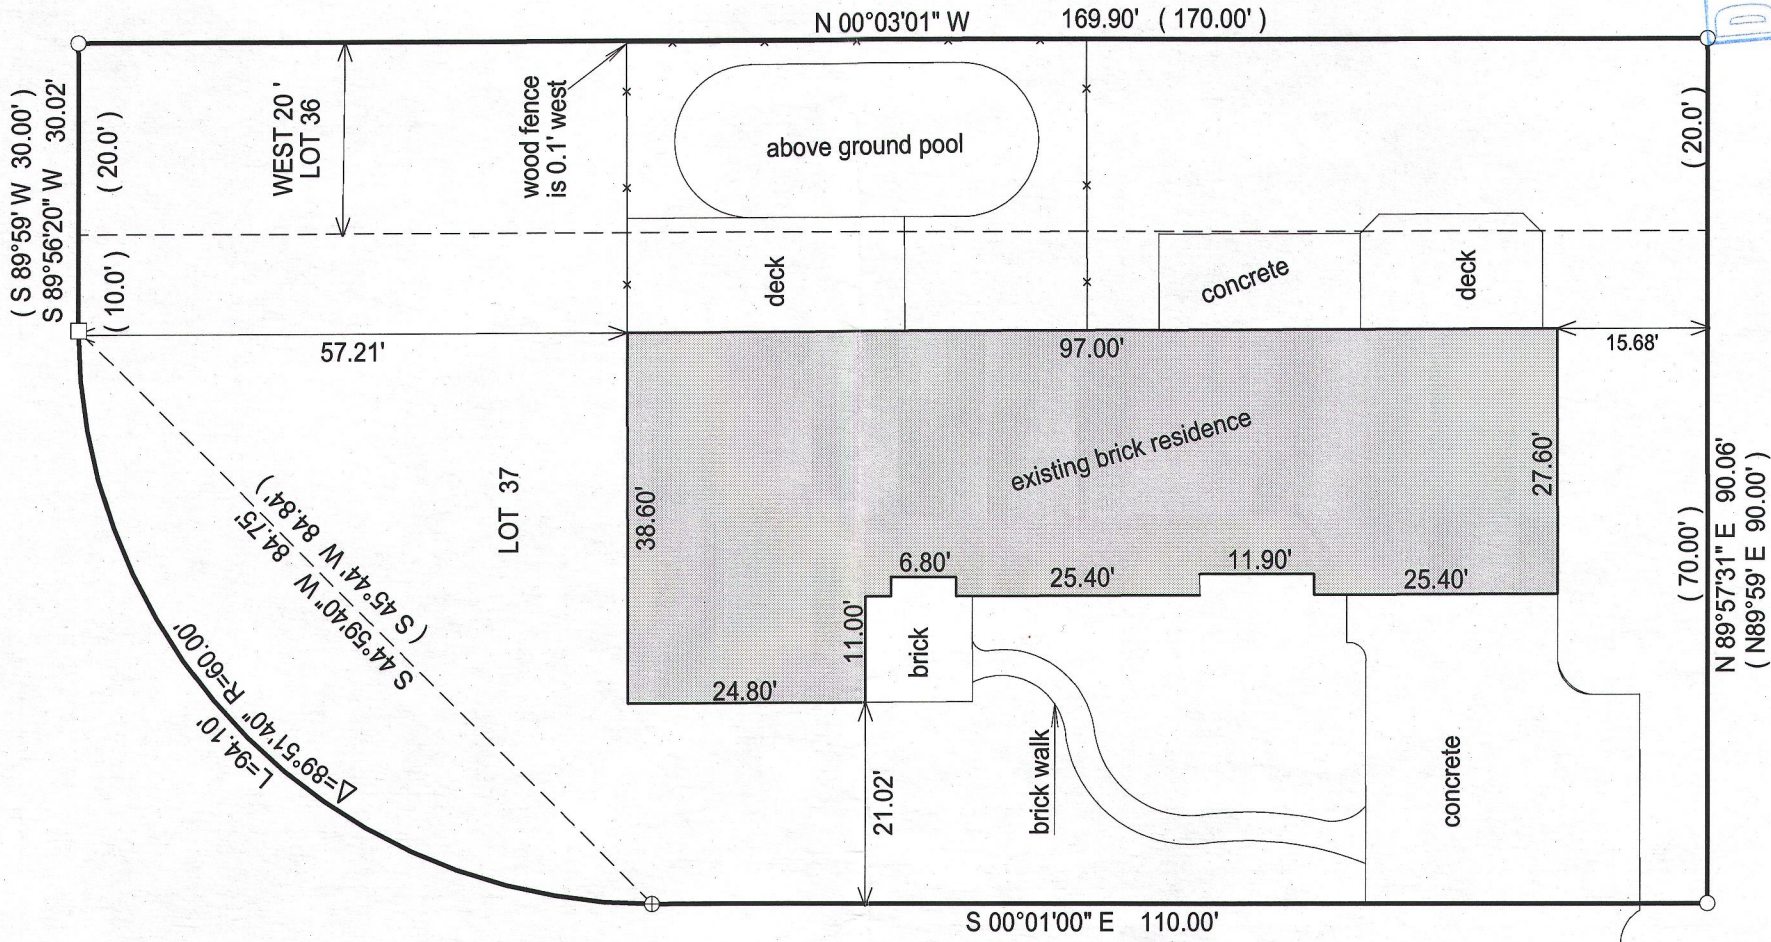

LAUREL HEIGHTS DR.

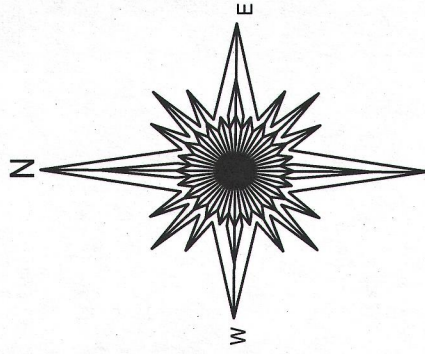

JEFFREY L. KIMPS S-2436
Wisconsin Registered Land Surveyor
(original if signed in red)

- () = recorded as
- = found iron bar
- = found iron pipe
- = set iron pipe
- = set iron bar

SCALE 1" = 20'

JOB # 13-37

TAX ID #
XLHA 00015

BASIS OF BEARING OF THIS PLAT: THE EAST LINE OF LAUREL
HEIGHTS DRIVE WAS ASSUMED TO BEAR: S 00°01'00" E AS
RECORDED ON THE RECORD PLAT.

I hereby certify that I have surveyed the above-described property and the
above map is a true representation thereof and shows the size and
location of the property, its exterior boundaries, the location and
dimensions of all structures thereon, fences, apparent easements and
roadways and visible encroachments if any.

This survey is made for the present owners of the property, and those who
purchase, mortgage, or guarantee the title thereto, within one year from
the date hereof.

DATED THIS 23RD DAY OF APRIL, 2013.

XLHA -15 002-2534