



PREPARED FOR
MONICA CLAUSEN
716 GROVE ST.
DELANAN WI. 53115

PLAT OF SURVEY OF


LOT 35 OF JOHN BARLOW'S SUBDIVISION OF BLOCK 16, PASSAGE, ARAM AND DOWNIE'S
ADDITION TO THE VILLAGE (NOW CITY) OF DELAVAN, WALWORTH COUNTY WISCONSIN.

KROTT SURVEYING INC.
(262) 248-3697
N 3705 WILLOW BEND LANE
LAKE GENEVA WI. 53147

C.L. GROVE STREET
(67.5' WIDE)

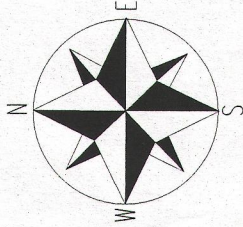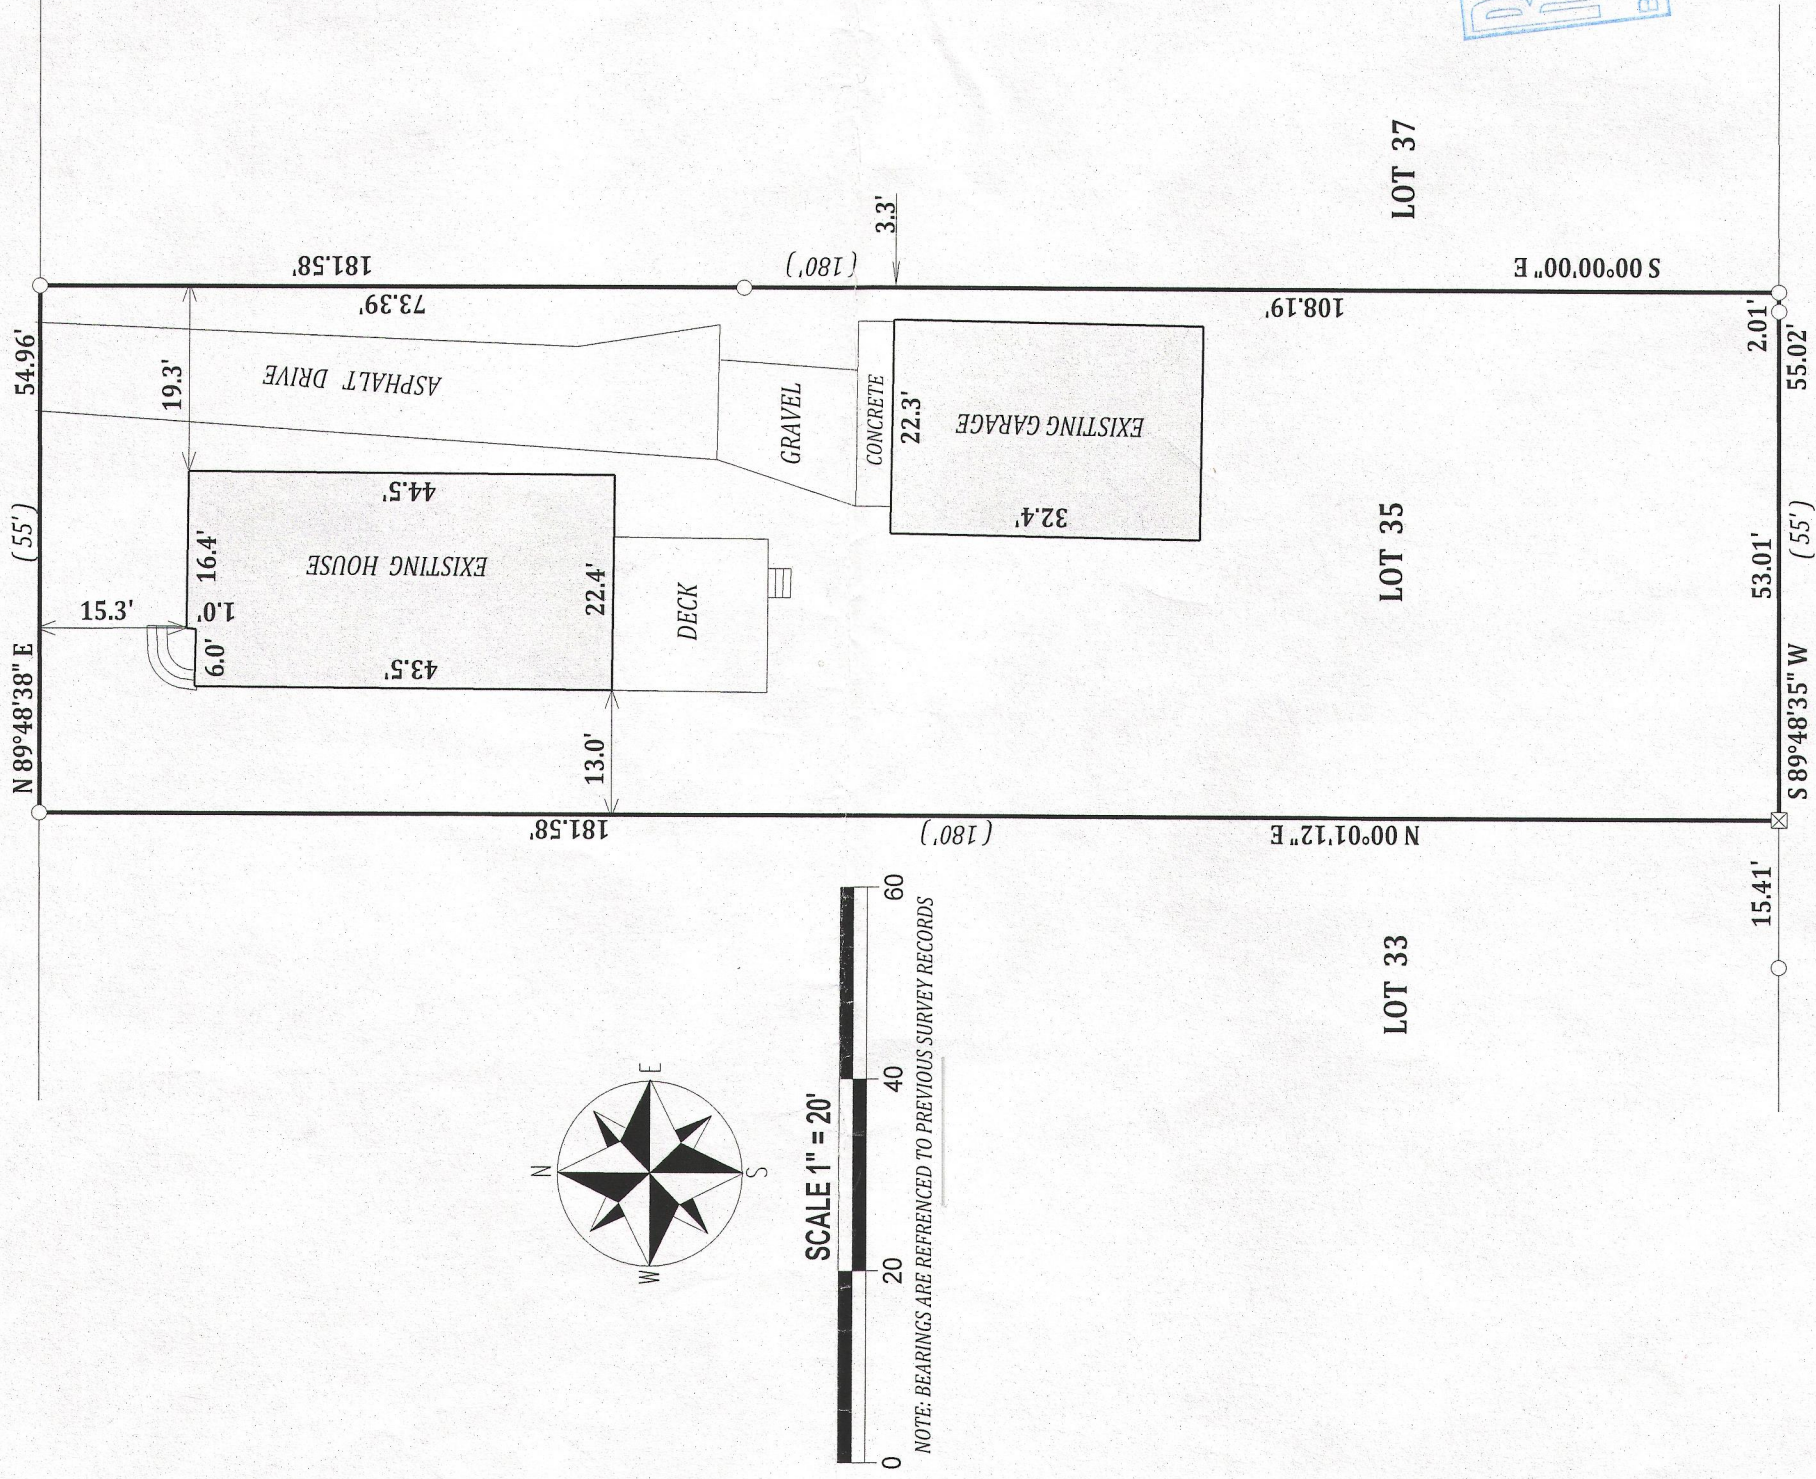

NOTE: BEARINGS ARE REFERENCED TO PREVIOUS SURVEY RECORDS

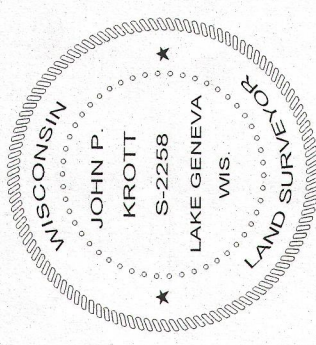

- LEGEND**
- FOUND IRON PIPE
 - ☒ FOUND AXLE
 - (XX) RECORDED AS

TAX ID # XPA00010

JOB # 13-117

I have surveyed the above-described property and the above map is a true representation thereof and shows the size and location of the property, its exterior boundaries, the location and dimensions of all structures thereon, fences apparent easements and roadways and visible encroachments, if any.

This survey is made for the exclusive use of the present owners of the property, and also those who purchase, mortgage, or insure the title thereto within one (1) year from date hereof; and as to them I warrant the accuracy of said survey map.

DATED THIS 5th DAY OF AUGUST 2013

John P. Krott
JOHN P. KROTT S-2258
WISCONSIN REGISTERED LAND SURVEYOR
(NOTE: THIS IS NOT A CERTIFIED COPY
UNLESS SIGNED IN RED INK)

002-2540