


FARRIS, HANSEN & ASSOCIATES, INC.

ENGINEERING - ARCHITECTURE - SURVEYING
7 RIDGWAY COURT - P.O. BOX 437 - ELKHORN, WISCONSIN 53121
PHONE: (262) 723-2098 FAX: (262) 723-5886


PLAT OF SURVEY

Lot 4 and the South 18.00 feet of Lot 3, Block 4, Atlynhurst Subdivision, City of Delavan, Walworth County, Wisconsin.

Tax Key No: XAS 00042

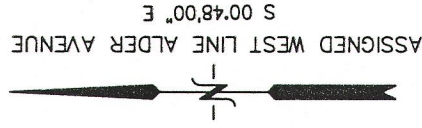


LUTHER MEMORIAL EVANGELICAL CHURCH
C/O DALE THORPE
1624 HOBBS DRIVE SUITE 1
DELAVAN, WI. 53115

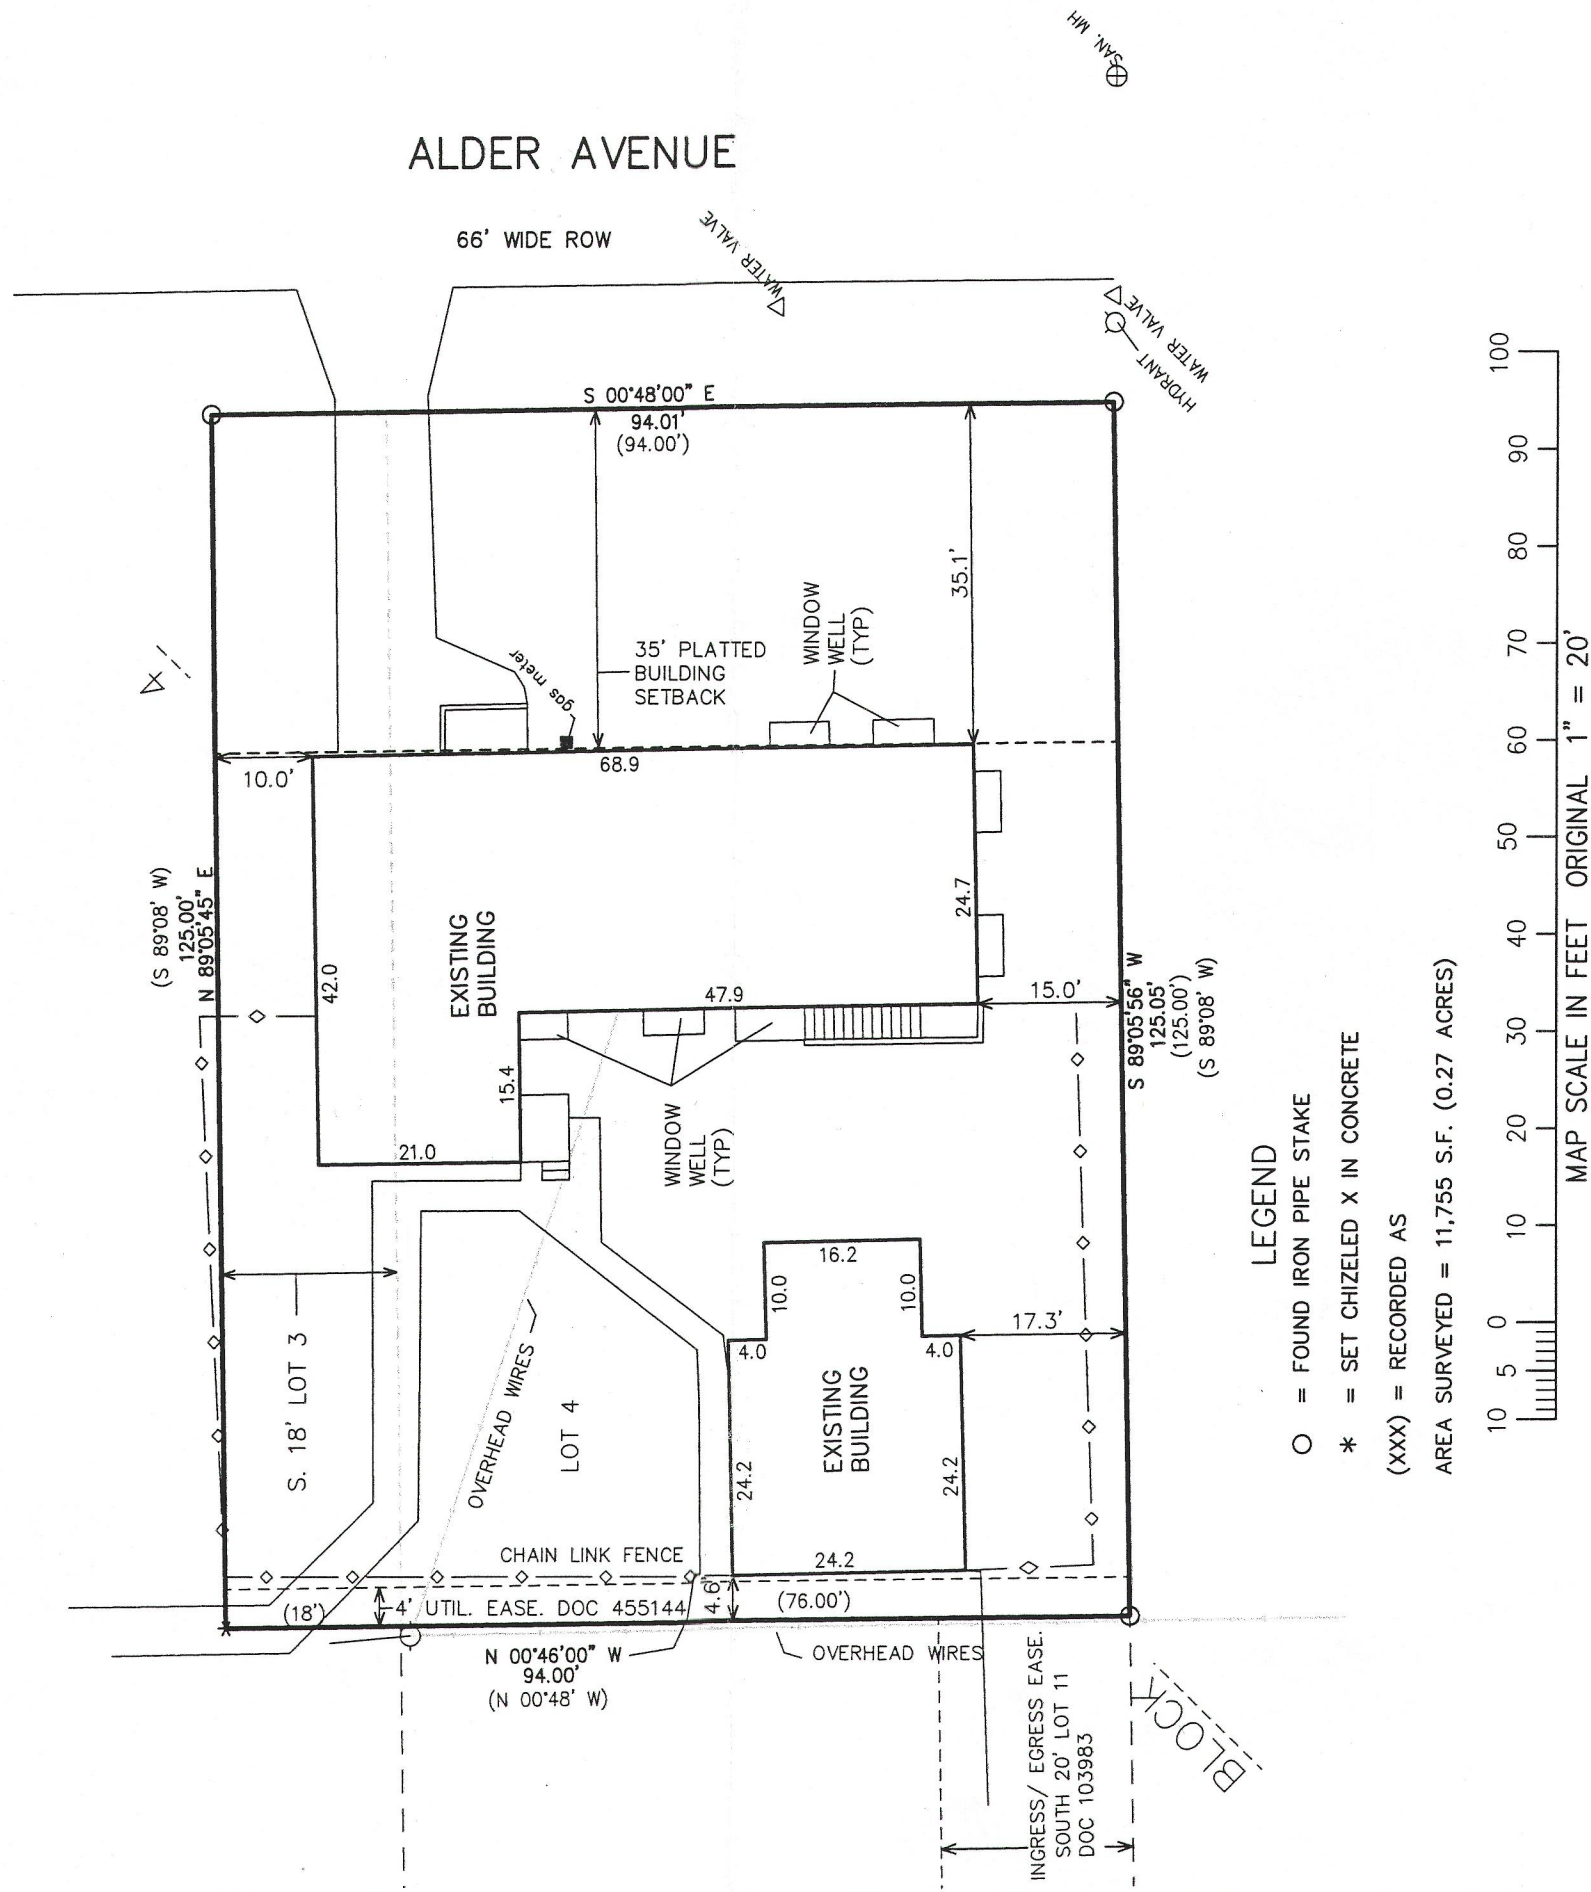

LEGEND

- O = FOUND IRON PIPE STAKE
- * = SET CHIZELED X IN CONCRETE
- (XXX) = RECORDED AS

AREA SURVEYED = 11,755 S.F. (0.27 ACRES)

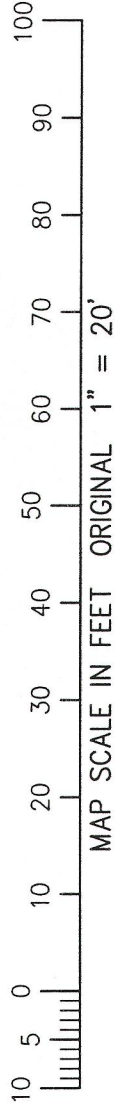

NOTE: COPIES OF THIS MAP TO WHICH THE FOLLOWING CERTIFICATE WILL APPLY SHOW THE SURVEYOR'S ORIGINAL SEAL AND SIGNATURE IN RED INK. COPIES BY ANY OTHER MEANS MAY HAVE ALTERATIONS WHICH DO NOT REPRESENT THE SURVEYOR'S WORK PRODUCT.

I HEREBY CERTIFY THAT THE ABOVE DESCRIBED PROPERTY HAS BEEN SURVEYED UNDER MY DIRECTION AND THAT THE ABOVE MAP IS A TRUE REPRESENTATION THEREOF AND SHOWS THE SIZE AND LOCATION OF THE PROPERTY, ITS EXTERIOR BOUNDARIES, THE LOCATION OF ALL VISIBLE STRUCTURES, AND DIMENSIONS OF ALL PRINCIPLE BUILDINGS THEREON, BOUNDARY FENCES, APPARENT EASEMENTS, ROADWAYS, AND VISIBLE ENCROACHMENTS, IF ANY. THIS SURVEY IS MADE FOR THE USE OF THE PRESENT OWNERS OF THE PROPERTY, AND ALSO THOSE WHO PURCHASE, MORTGAGE, OR GUARANTEE THE TITLE THERETO WITHIN ONE YEAR FROM THE DATE HEREOF.

DATED: SEPTEMBER 18, 2013

Peter S. Gordon
PETER S. GORDON



PROJECT: 8880
DATE: 09-18-2013
SHEET 1 OF 1

SEP 18 2013

XAS-42

002-2541