


FARRIS, HANSEN & ASSOCIATES, INC.

ENGINEERING - ARCHITECTURE - SURVEYING
7 RIDGWAY COURT - P.O. BOX 437 - ELKHORN, WISCONSIN 53121
PHONE: (262) 723-2098 FAX: (262) 723-5886


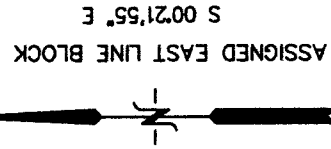


PLAT OF SURVEY

THE NORTH 50' OF LOT 8
BLOCK 4 PASSAGE, ARAM, & DOWNIE ADDITION
LOCATED IN THE SE 1/4 OF THE SE 1/4 OF SECTION 18
TOWN 2 NORTH, RANGE 16 EAST
CITY OF DELAVAN, WALWORTH COUNTY, WI.

The South 50 feet of Lot 9 in Block 4 of Passage, Aram and Downie's Addition to the Village, now City of Delavan, Walworth County, Wisconsin.



Tax Key No.: XP 00058

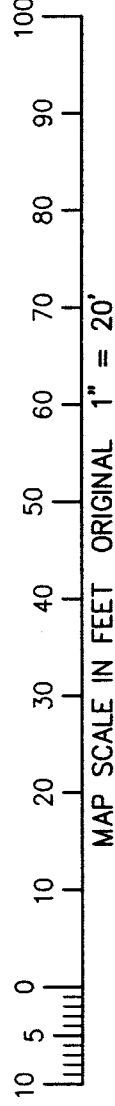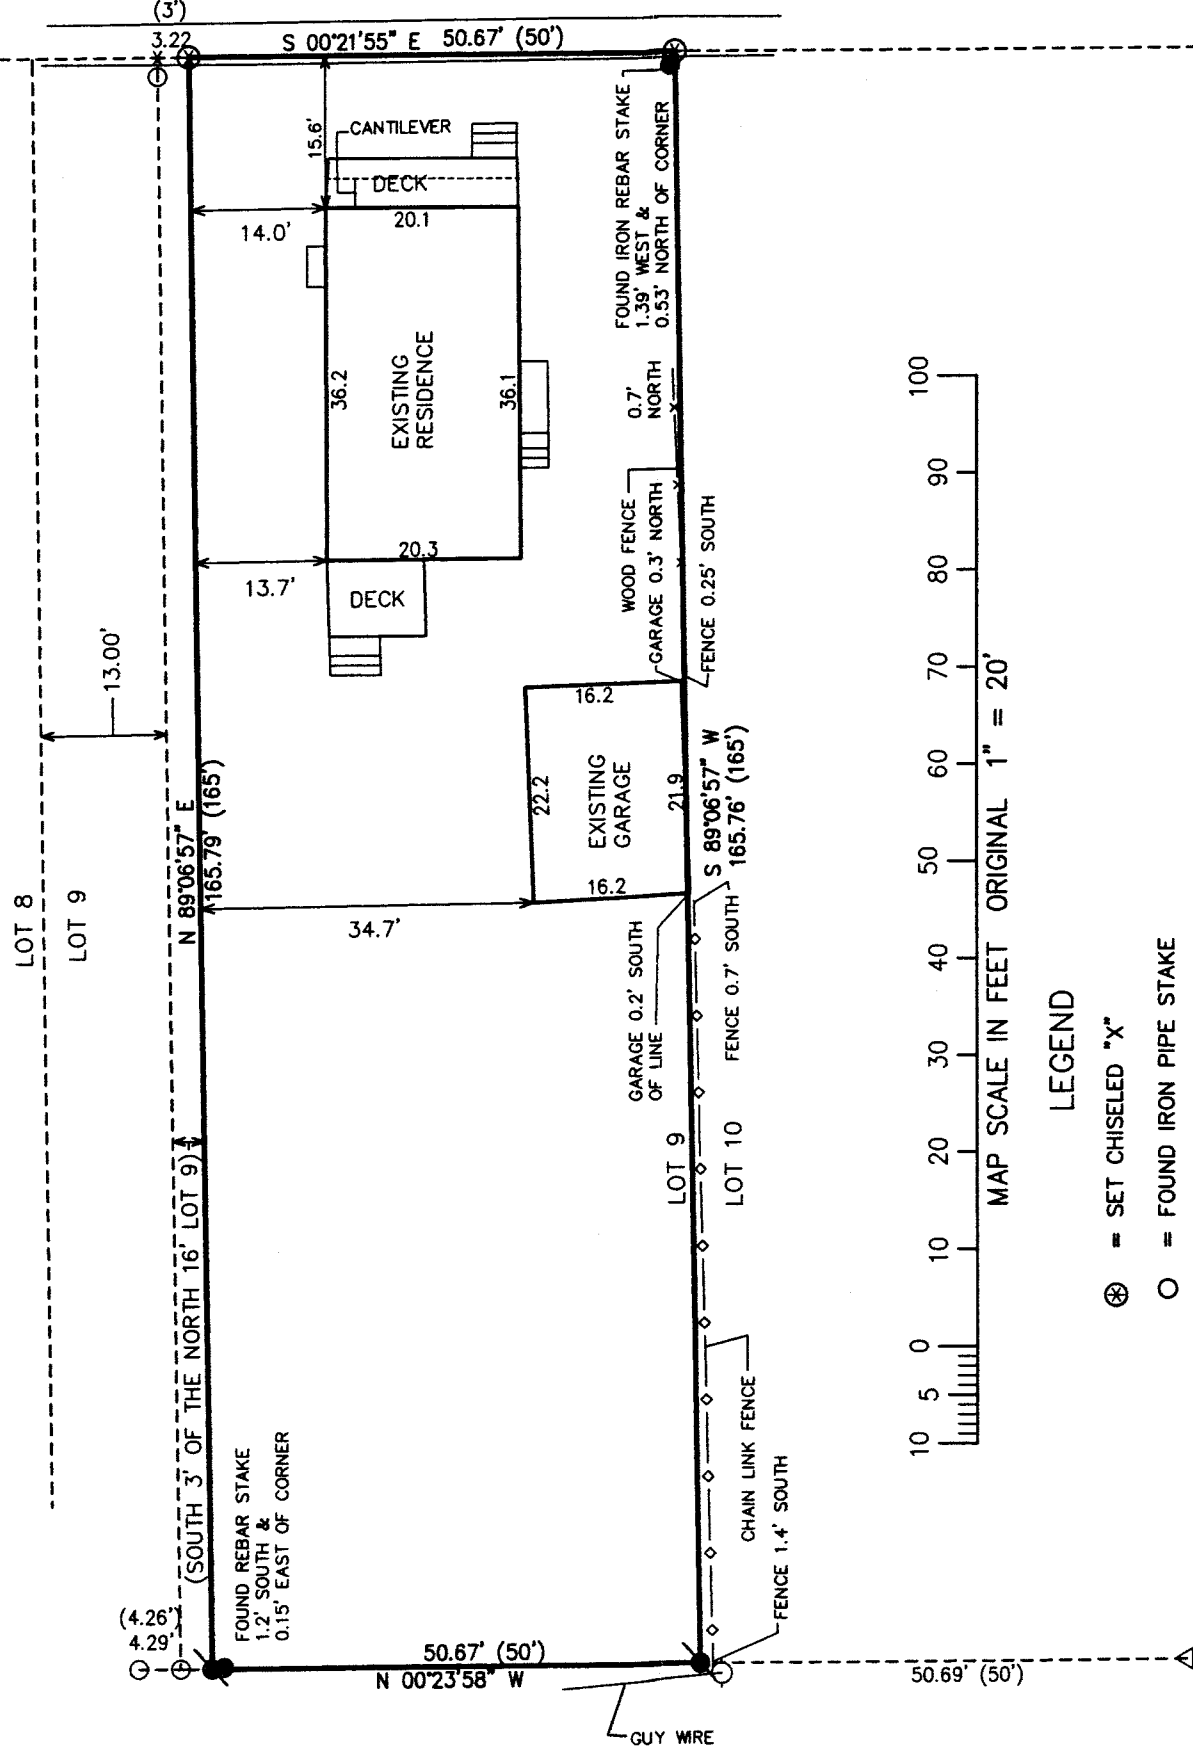

LEGEND

- ⊗ = SET CHISELED "X"
- = FOUND IRON PIPE STAKE
- = FOUND IRON REBAR STAKE
- ✕ = SET IRON REBAR STAKE
- * = FOUND CHISELED "X"
- △ = FOUND NAIL
- (XXX) = RECORDED AS

- WORK ORDERED BY -
ALVIN BRANDL
320 6th STREET
DELAVAN, WI. 53115

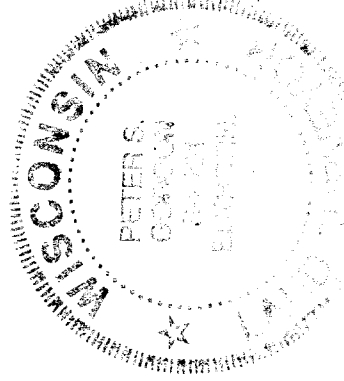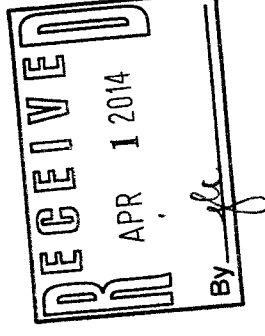

NOTE: COPIES OF THIS MAP TO WHICH THE FOLLOWING CERTIFICATE WILL APPLY SHOW THE SURVEYOR'S ORIGINAL SEAL AND SIGNATURE IN RED INK. COPIES BY ANY OTHER MEANS MAY HAVE ALTERATIONS WHICH DO NOT REPRESENT THE SURVEYOR'S WORK PRODUCT.

I HEREBY CERTIFY THAT THE ABOVE DESCRIBED PROPERTY HAS BEEN SURVEYED UNDER MY DIRECTION AND THAT THE ABOVE MAP IS A TRUE REPRESENTATION THEREOF AND SHOWS THE SIZE AND LOCATION OF THE PROPERTY, ITS EXTERIOR BOUNDARIES, THE LOCATION OF ALL VISIBLE STRUCTURES, AND DIMENSIONS OF ALL PRINCIPLE BUILDINGS THEREON, BOUNDARY FENCES, APPARENT EASEMENTS, ROADWAYS, AND VISIBLE ENCROACHMENTS, IF ANY. THIS SURVEY IS MADE FOR THE USE OF THE PRESENT OWNERS OF THE PROPERTY, AND ALSO THOSE WHO PURCHASE, MORTGAGE, OR GUARANTEE THE TITLE THERETO WITHIN ONE YEAR FROM THE DATE HEREOF.

DATED: MARCH 7, 2014

PETER S. GORDON

PROJECT: 8964
DATE: 03-03-2014
SHEET 1 OF 1

MAR 07 2014

XP -58A

002-2546