

PLAT OF SURVEY





-OF-

A PARCEL OF LAND LOCATED IN THE SOUTHEAST 1/4 OF THE NORTHEAST 1/4 OF SECTION 18, TOWNSHIP 2 NORTH, RANGE 16 EAST, CITY OF DELAVAN, WALWORTH COUNTY, WISCONSIN AND MORE FULLY DESCRIBED AS FOLLOWS: BEGINNING AT A POINT IN THE CENTER OF WALWORTH AVENUE IN THE CITY OF DELAVAN, WALWORTH COUNTY, WISCONSIN, 29 RODS (478.5 FEET) 1 FOOT, 9 INCHES EAST OF THE EAST LINE OF FIFTH STREET IN SAID CITY OF DELAVAN WHICH SAID EAST LINE OF FIFTH STREET CROSSES SAID WALWORTH AVENUE; RUN THENCE NORTH 17 RODS (280.5 FEET); THENCE WEST 4 RODS (66 FEET) TO THE NORTHEAST CORNER OF A STRIP OF LAND CONVEYED BY O.R. RICE AND MARY A. RICE, TO MARY L. LATIMER BY DEED DATED MAY 10, 1911 AND RECORDED IN THE OFFICE OF THE REGISTER OF DEEDS IN AND FOR SAID COUNTY OF WALWORTH IN VOLUME 131 OF DEEDS AT PAGE 510; THENCE SOUTH ALONG THE EAST LINE OF SAID STRIP OF LAND 17 RODS (280.5 FEET) TO THE CENTER OF SAID WALWORTH AVENUE; THENCE EAST 4 RODS (66 FEET) TO THE PLACE OF BEGINNING.

SURVEY FOR: RENE MENAGER

SURVEY ADDRESS: 601 E. WALWORTH AVENUE

BELL'S SUBDIVISION

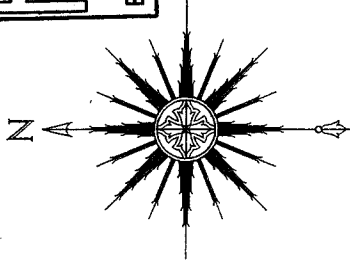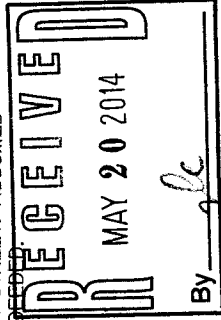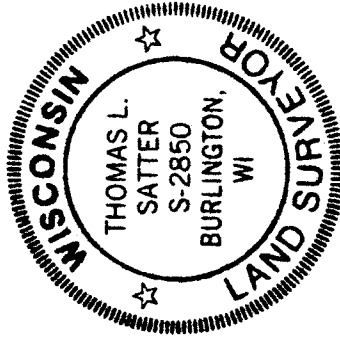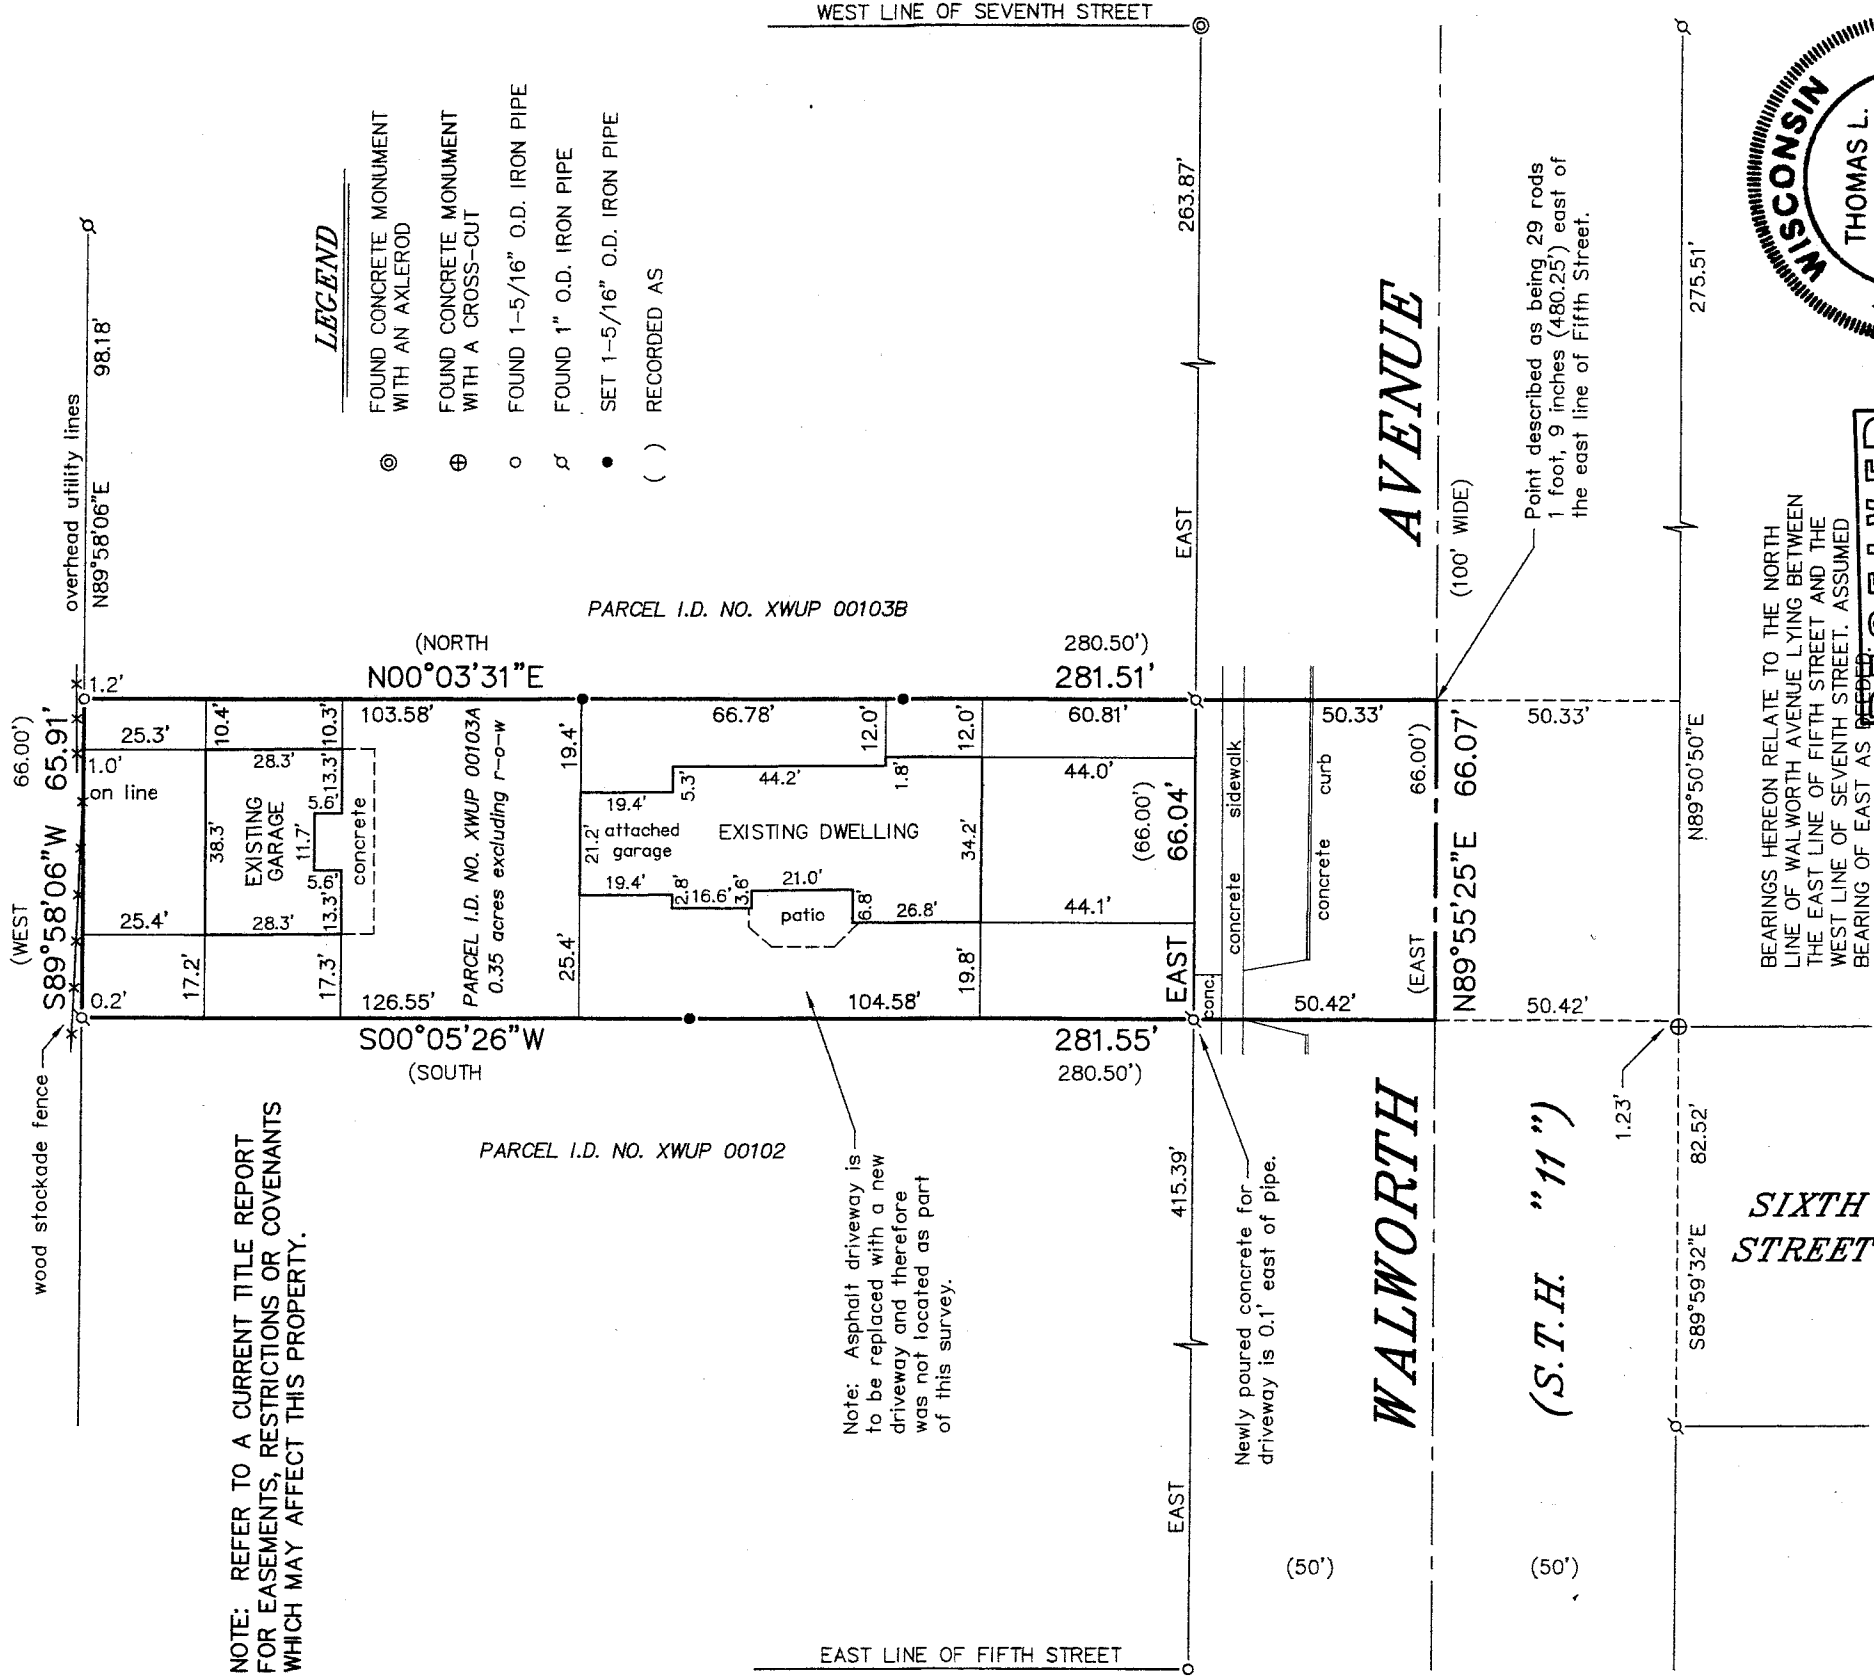

"I, HEREBY CERTIFY THAT I HAVE SURVEYED THE ABOVE DESCRIBED PROPERTY AND THAT THE ABOVE MAP IS A CORRECT REPRESENTATION THEREOF AND SHOWS THE SIZE AND LOCATION OF THE PROPERTY, ITS EXTERIOR BOUNDARIES, THE LOCATION OF ALL VISIBLE STRUCTURES AND DIMENSIONS OF ALL PRINCIPAL BUILDINGS THEREON, BOUNDARY FENCES, APPARENT EASEMENTS, ROADWAYS AND ENCROACHMENTS, IF ANY."

"THIS SURVEY IS MADE FOR THE USE OF THE PRESENT OWNERS OF THE PROPERTY, AND THOSE WHO PURCHASE, MORTGAGE, OR GUARANTEE THE TITLE THERETO WITHIN ONE YEAR FROM DATE HEREOF."


THIS IS NOT AN ORIGINAL PRINT UNLESS THIS SEAL IS RED.

Thomas L. Satter

SATTER SURVEYING, LLC
LAND SURVEYS, MAPPING AND PLANNING
272 ORIGIN STREET
BURLINGTON, WI 53105
262-661-4239

THOMAS L. SATTER S-2850

MAY 5, 2014 DATE
041412 JOB NUMBER

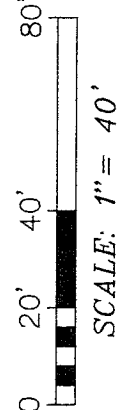

XWUP -103A

002-2547