


BOUNDARY SURVEY


Known as 207 McDowell Street, in the City of Delavan, Walworth County, Wisconsin.
PARCEL 1: Lot 2, except the Northerly 44.5 feet; all of Lots 3 and 4 and Lot 5, except the Northerly 61.80 feet; all in Block 2 of the Original Plat of the City of Delavan, Walworth County, Wisconsin.
March 6, 2014 WHPC Southern Bond Pool I Survey No.165961-BMJ

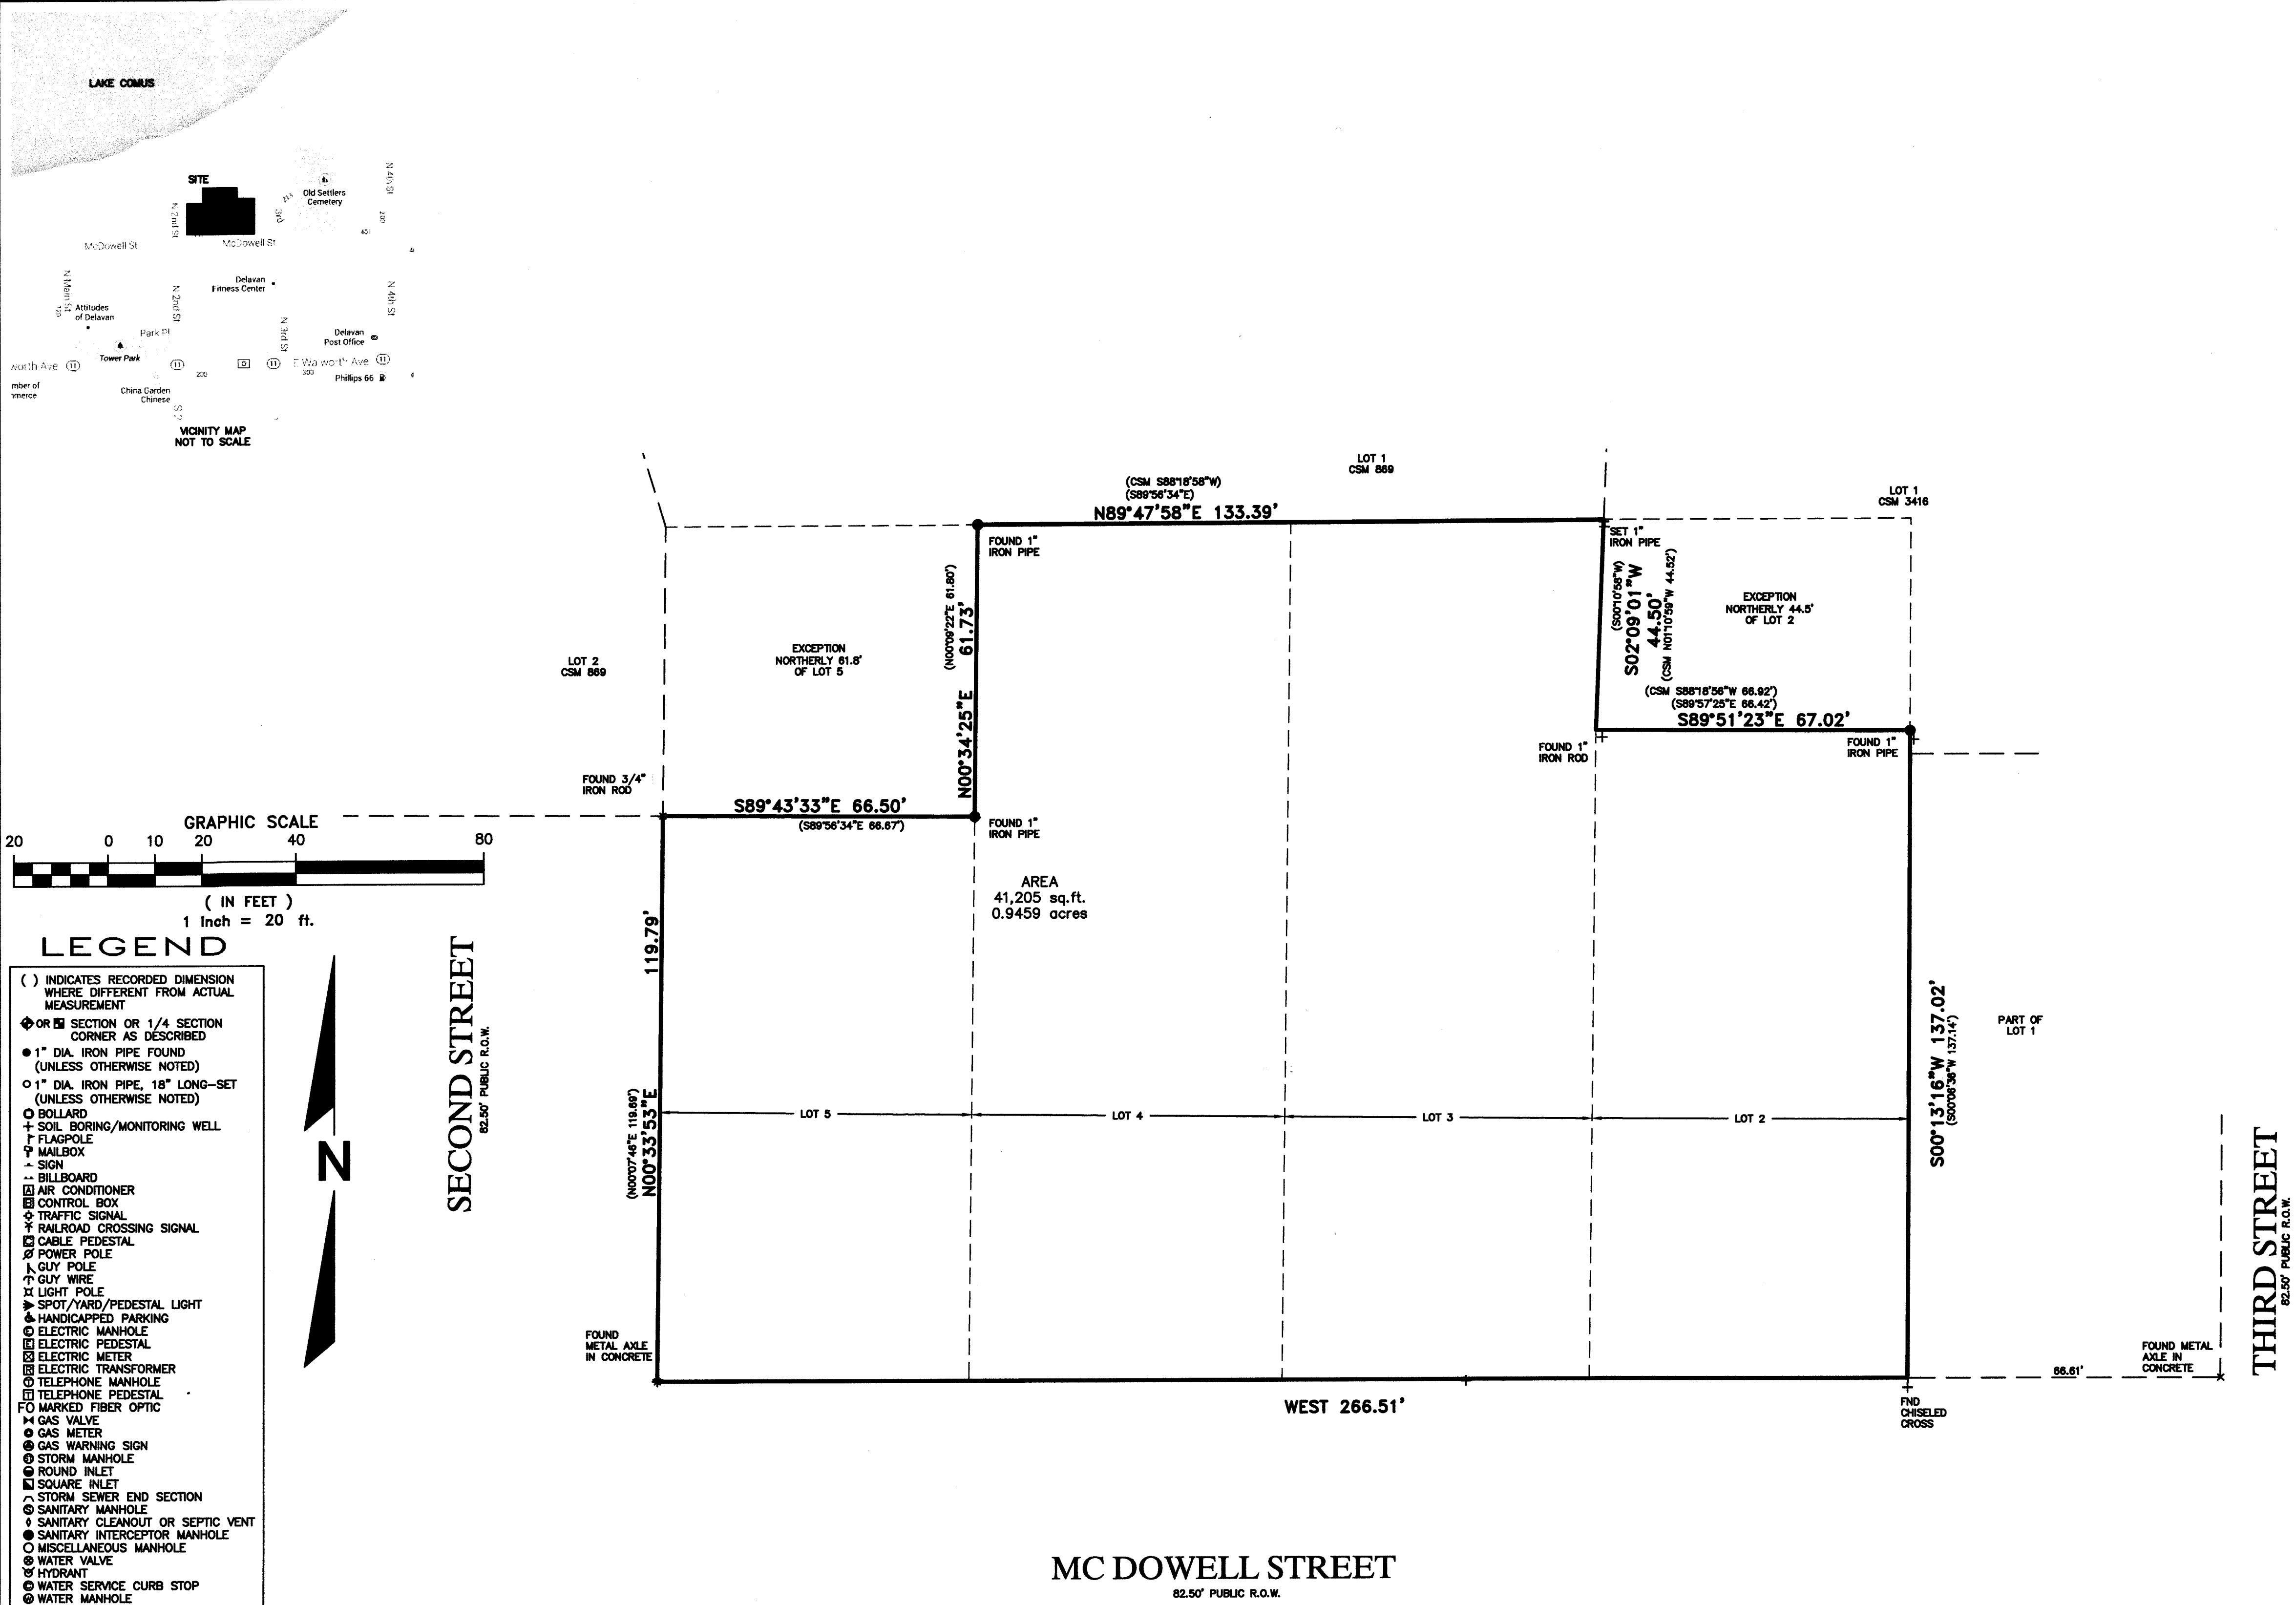

I CERTIFY, that this survey was prepared under my supervision and is correct to the best of my professional knowledge and belief.



Stephan G. Southwell
SURVEYOR NAME
REGISTERED WISCONSIN LAND SURVEYOR

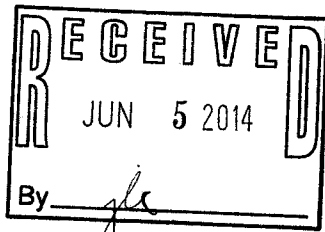

R.A. Smith National, Inc.
Beyond Surveying
and Engineering

16745 W. Bluemound Road, Brookfield, WI 53005-5538
262-781-1000 Fax 262-787-7373, www.ra-smithnational.com
Appleton, WI Orange County, CA Pittsburgh, PA
S:\165961\dwg\BS101D20.dwg\207 MCDOWELL ST