


GEORGE T. DUNHAM
SURVEYING & SUBDIVIDING
DELAVAN, WISCONSIN

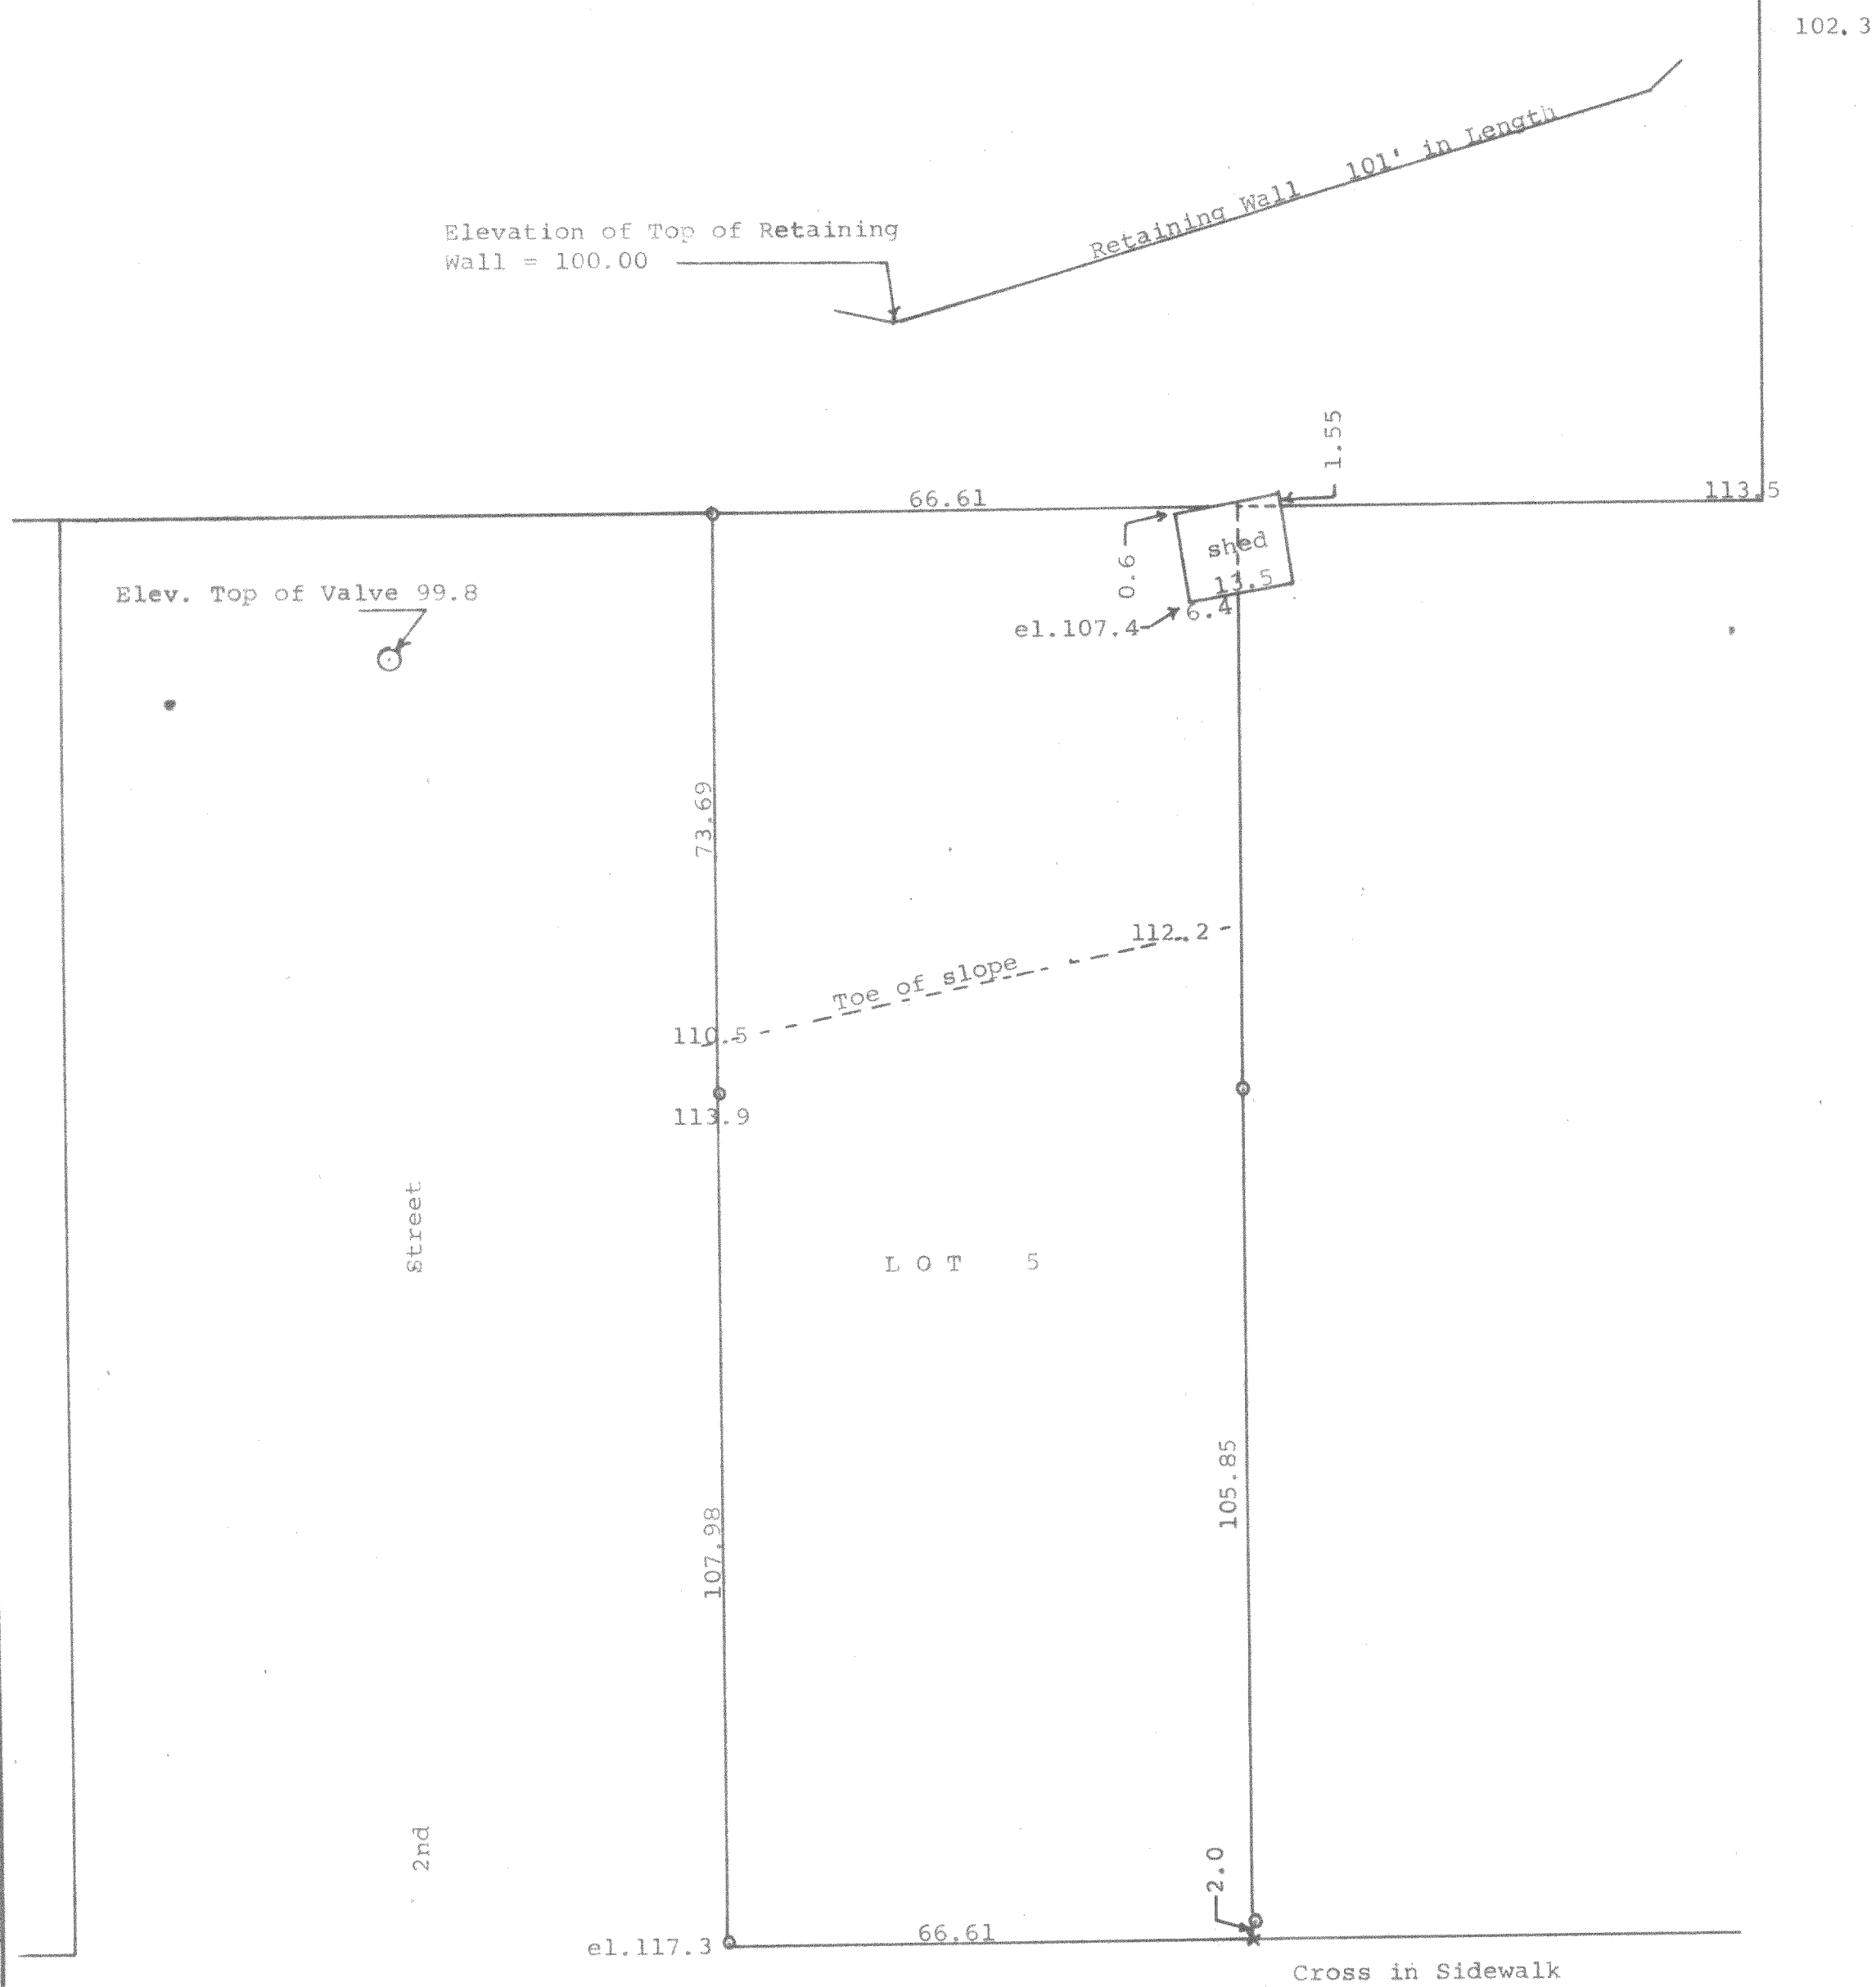

Scale - 1" = 20'
○ = Iron Pipe or Rod

Plat of survey of Lot 5, Block 2 of the Original Plat of the
City of Delavan, Walworth County, Wisconsin.
November 18, 1965

George T. Dunham
George T. Dunham, Surveyor