


LOT 5, BLOCK 7 SPRINGS PARK SUBDIVISION ADDITION No. 2, LOCATED
IN THE SW 1/4 OF SECTION 18, TOWN 2 NORTH, RANGE 16 EAST OF THE
FOURTH PRINCIPAL MERIDIAN, CITY OF DELAVAN, COUNTY OF WALWORTH
AND STATE OF WISCONSIN.

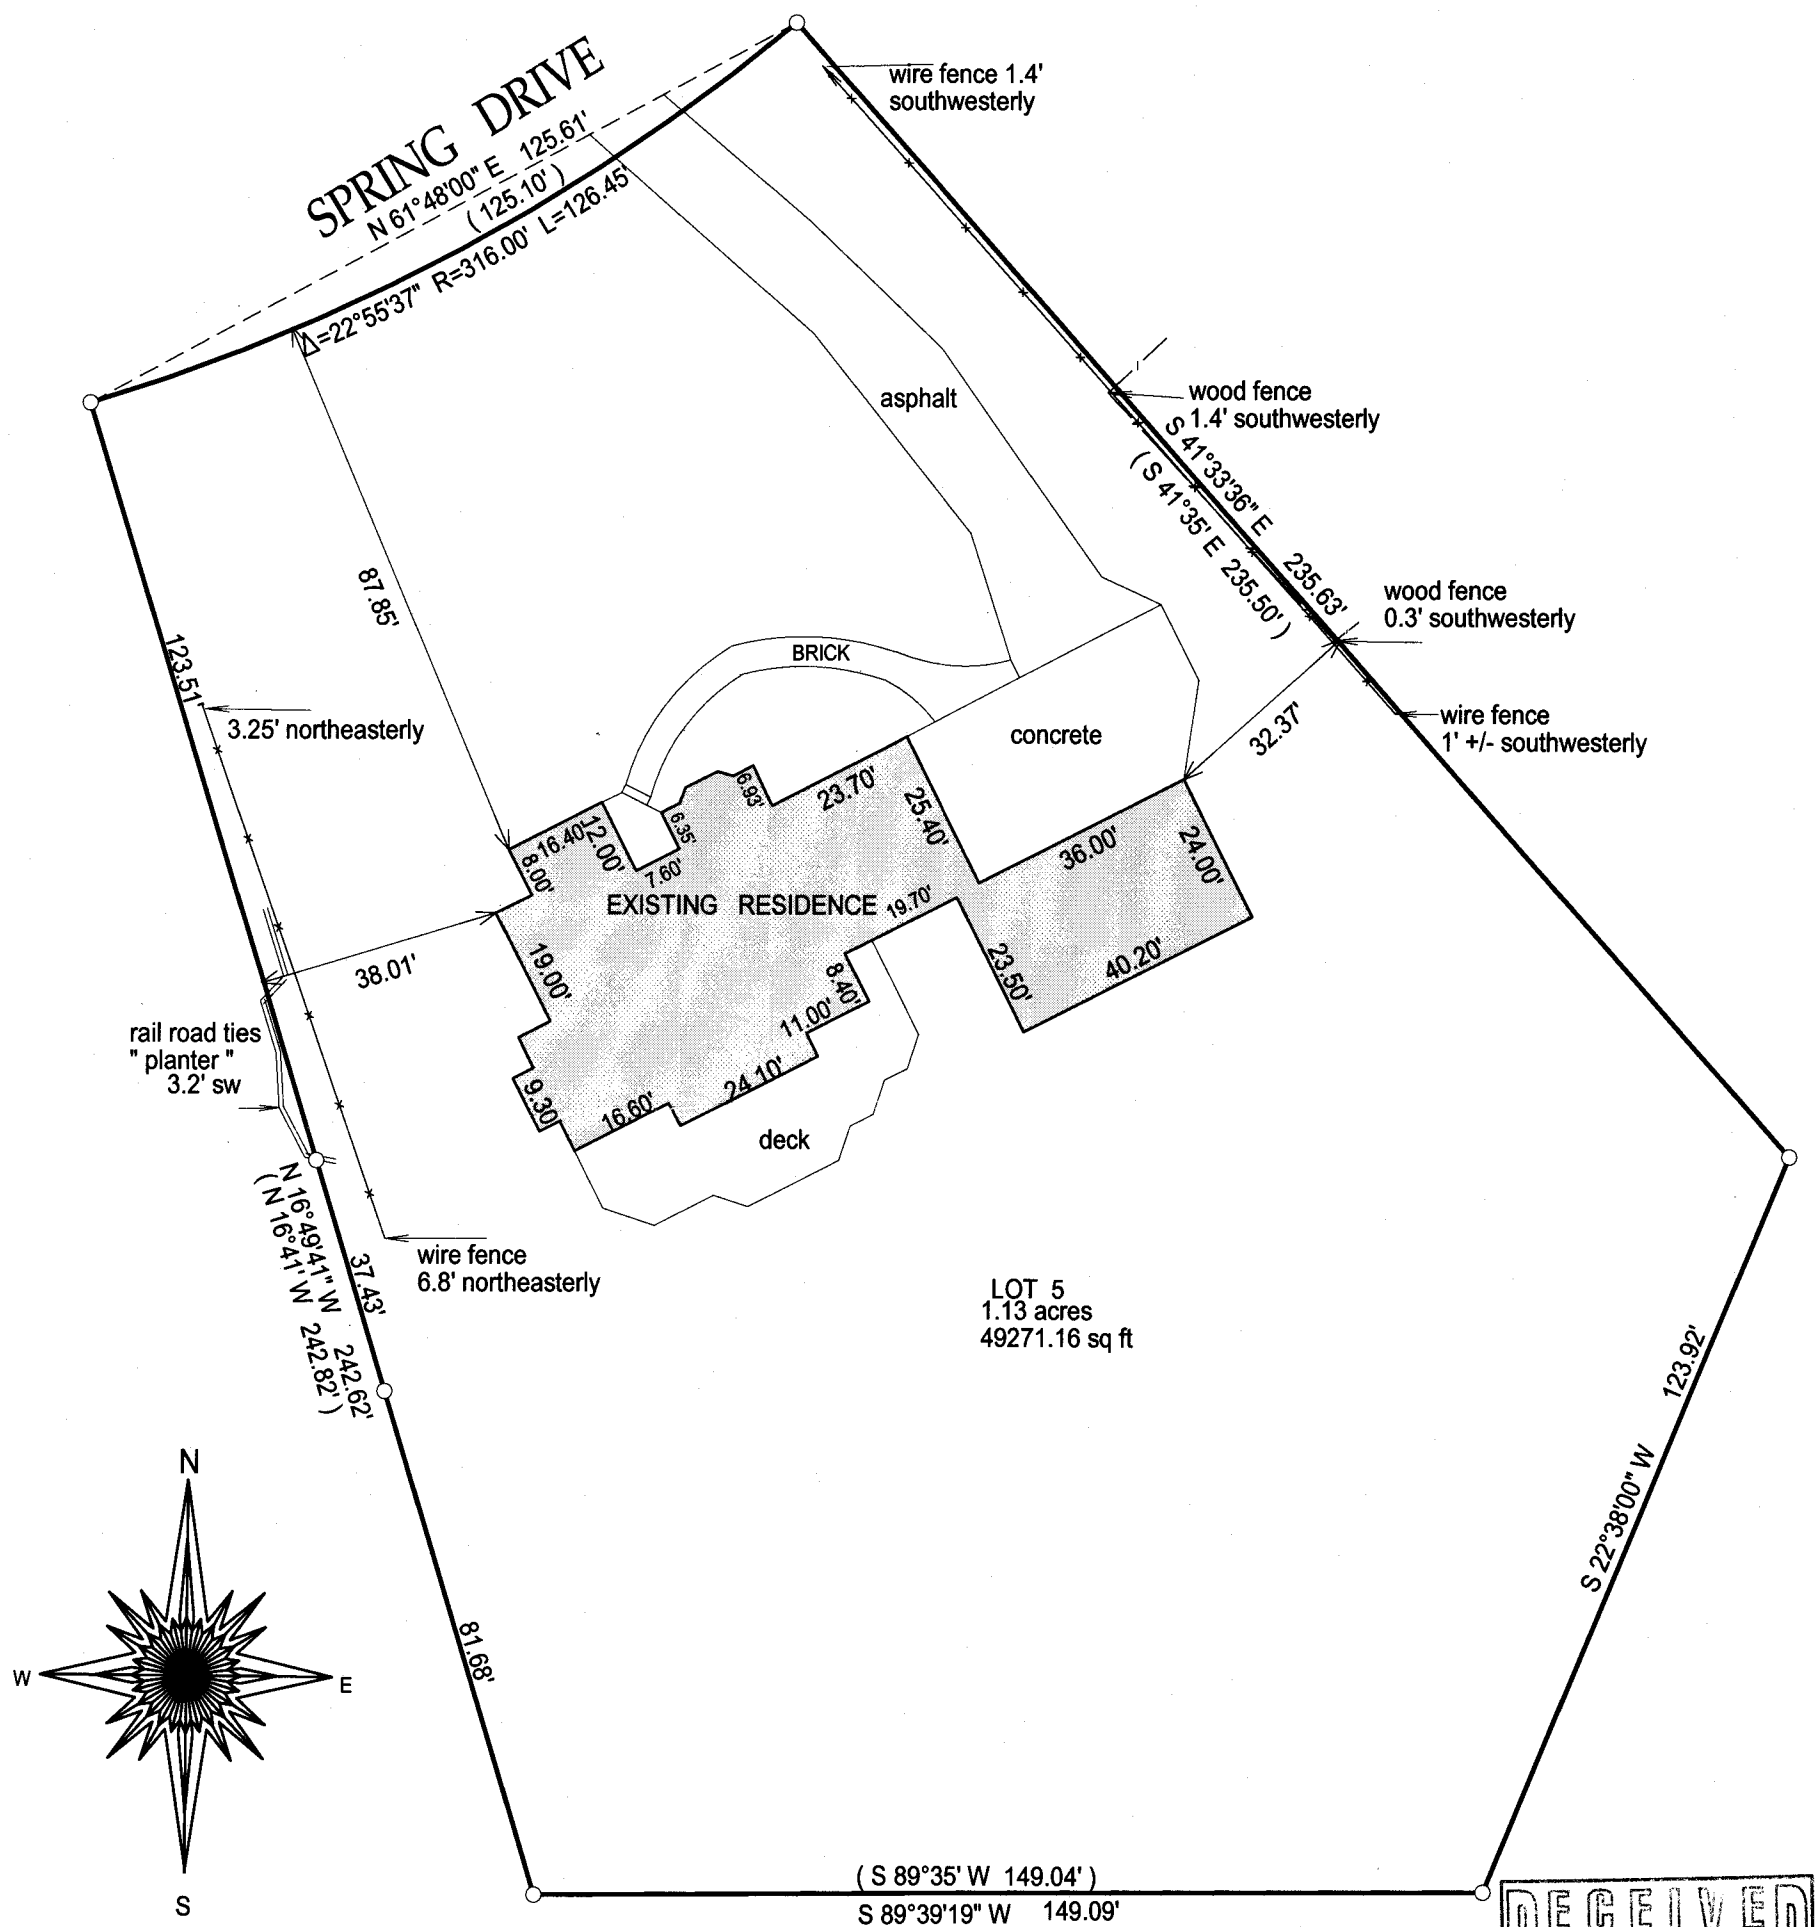

() = recorded as

☐ = found iron bar

○ = found iron pipe

● = set iron pipe


■ = set iron bar

SCALE 1" = ~~20'~~
30'

JOB # 14-182

TAX ID #

XSPS200012


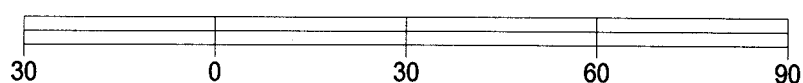


**BASIS OF BEARING OF THIS PLAT: THE SUBDIVISION PLAT
OF RECORD.**

I hereby certify that I have surveyed the above- described property and the above map is a true representation thereof and shows the size and location of the property, its exterior boundaries, the location and dimensions of all structures thereon, fences, apparrant easements and roadways and visible encroachments if any.

This survey is made for the present owners of the property, and those who purchase, mortgage, or guarantee the title thereto, within one year from the date hereof.

DATED THIS 15TH DAY OF AUGUST, 2014.

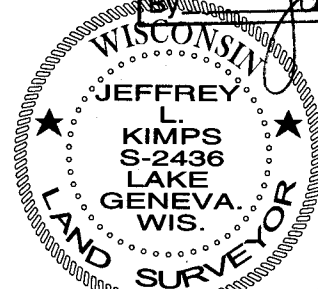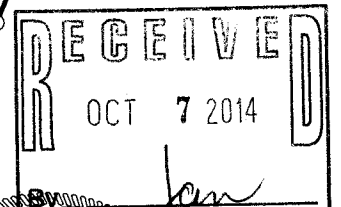

JEFFREY L KIMPS S - 2436
Wisconsin Registered Land Surveyor
(original if signed in red)

X8P82 -12

002-2562