

WORK ORDERED BY -
JIM KIRSCHLAGER
A MINI-STORAGE LLC
P.O. BOX 208
FONTANA, WI 53125

FARRIS, HANSEN & ASSOCIATES, INC.
ENGINEERING - ARCHITECTURE - SURVEYING
7 RIDGWAY COURT P.O. BOX 437
ELKHORN, WISCONSIN 53121
OFFICE: (262) 723-2098 FAX: (262) 723-5886

REVISIONS
7/6/2007-KB
TO SHOW SIZE AND
LOCATION OF AS-BUILT
BUILDINGS


PROJECT NO.
7187
DATE
05/08/2007
SHEET NO.
1 OF 1

PLAT OF SURVEY

LOT 1 OF CERTIFIED SURVEY MAP NO. 2949

LOCATED IN PART OF BLOCK "B" OF STOCK BUSINESS PARK BEING A PART OF
THE NW 1/4 OF THE NE 1/4 AND THE NE 1/4 OF THE NW 1/4 OF SECTION 16,
TOWN 2 NORTH, RANGE 16 EAST, CITY OF DELAVAN, WALWORTH COUNTY, WISCONSIN

GRID NORTH
WISCONSIN COORDINATE SYSTEM
N. LINE OF THE NE 1/4 OF SECTION 16-2-16
BEARS N 88°29'50" E

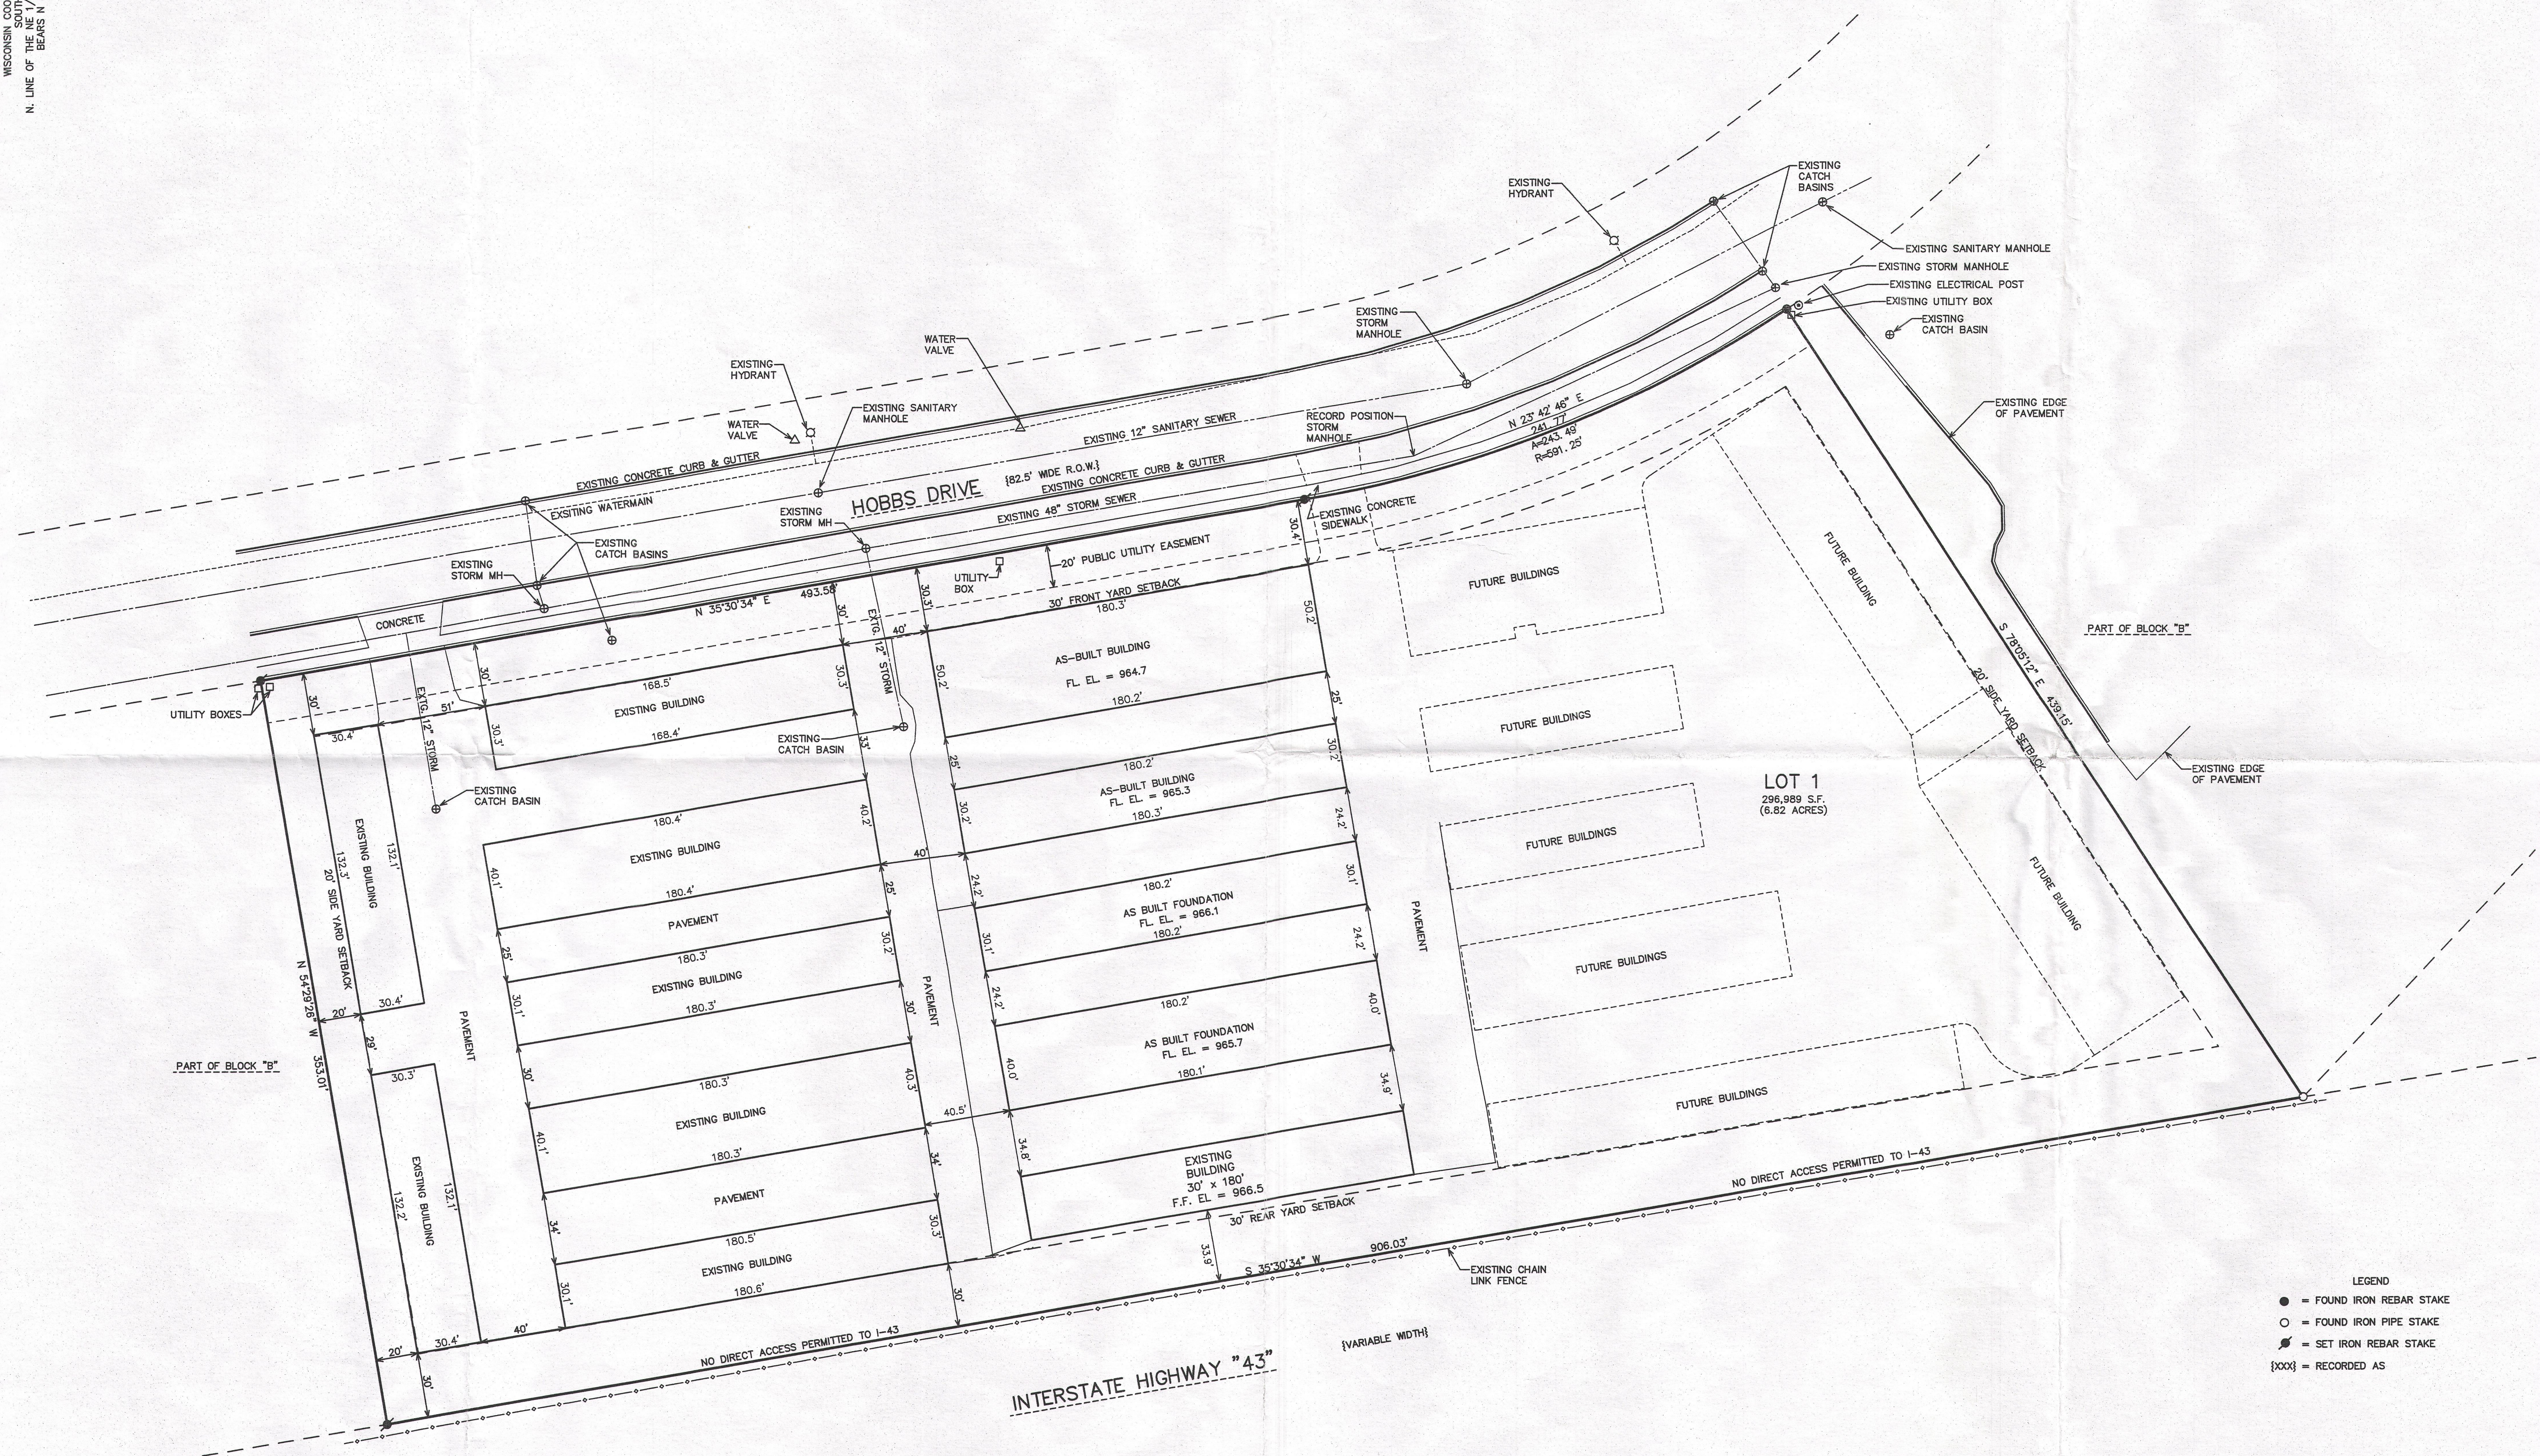

MAP SCALE IN FEET ORIGINAL 1" = 40'

RECEIVED
JAN 6 2015

PETER S. GORDON
S-2101
ELKHORN, WI
LAND SURVEYOR

DATED: MAY 8, 2007
TO SHOW ALL AS-BUILT BUILDINGS
TO DATE

REVISOR 09-16-2014
TO DATE

XA2949-1 002-2567