

PLAT OF SURVEY -OF-

LOT 68 OF "GLEN OAKS OF DELAVAN", A SUBDIVISION BEING A PART OF THE SOUTHEAST 1/4 OF THE NORTHWEST 1/4 AND PART OF THE SOUTHWEST 1/4 OF THE NORTHEAST 1/4 OF SECTION 13, TOWNSHIP 2 NORTH, RANGE 15 EAST OF THE FOURTH PRINCIPAL MERIDIAN, IN THE CITY OF DELAVAN, COUNTY OF WALWORTH AND STATE OF WISCONSIN.


SURVEY FOR: MILLENNIUM DREAM HOMES LLC

NOTE: REFER TO A CURRENT TITLE REPORT FOR EASEMENTS, RESTRICTIONS OR COVENANTS WHICH MAY AFFECT THIS PROPERTY.

EXISTING SUB-FLOOR ELEVATION = 947.9'
EXISTING GARAGE FLOOR = 946.4'

I HEREBY CERTIFY THAT THE EXISTING DWELLING UNDER CONSTRUCTION IS LOCATED AS SHOWN THUS (), DATED THIS 10TH DAY OF NOVEMBER, 2015.

Thomas L. Satter
THOMAS L. SATTER S-2850

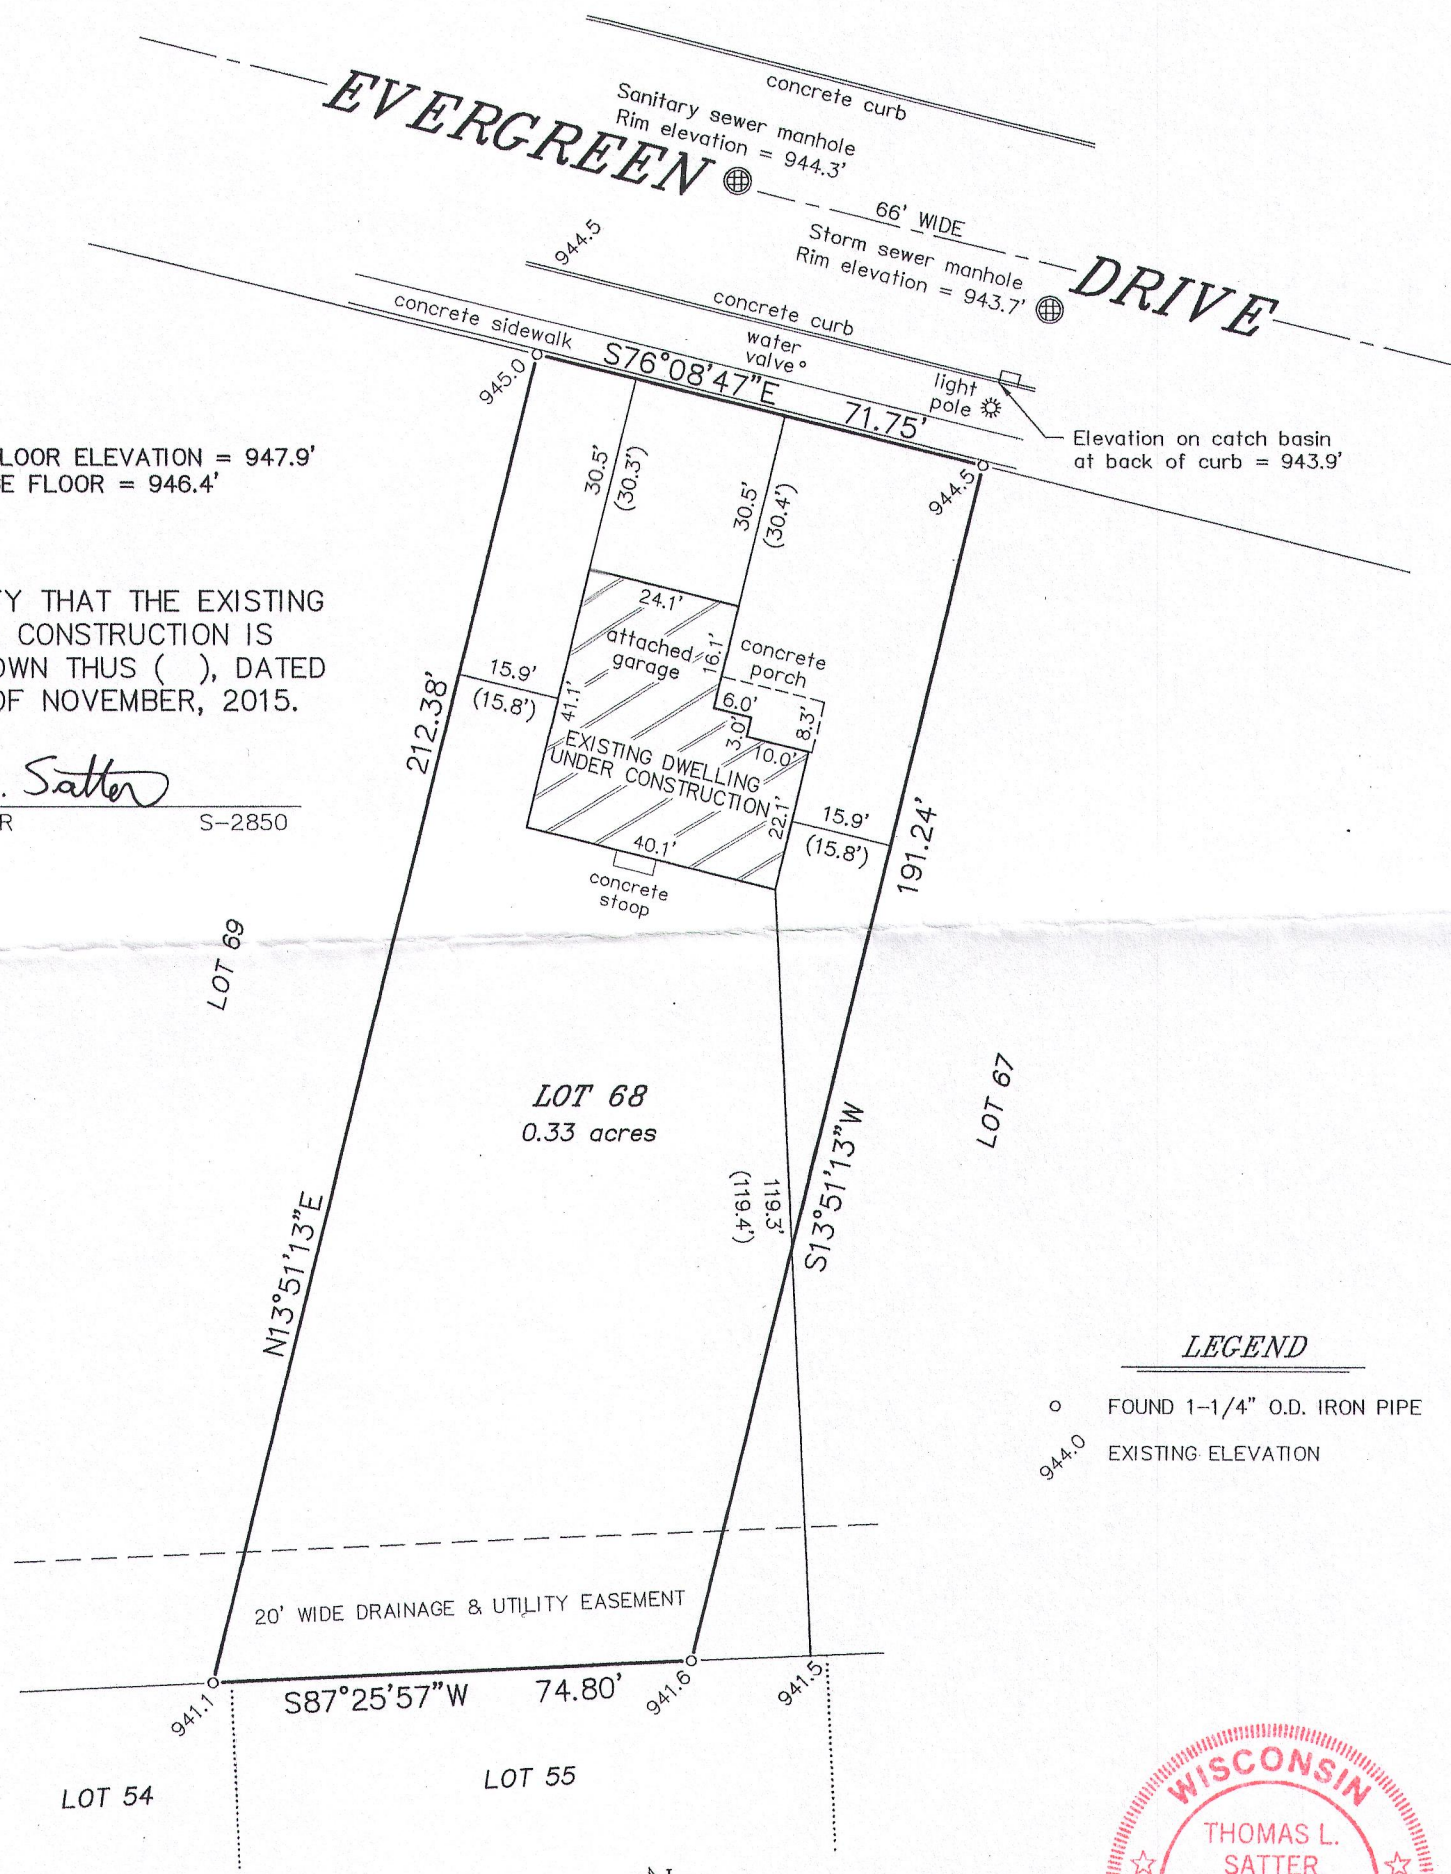




LEGEND

- FOUND 1-1/4" O.D. IRON PIPE
- 944.0 EXISTING ELEVATION

"I HEREBY CERTIFY THAT I HAVE SURVEYED THE ABOVE DESCRIBED PROPERTY AND THAT THE ABOVE MAP IS A CORRECT REPRESENTATION THEREOF AND SHOWS THE SIZE AND LOCATION OF THE PROPERTY, ITS EXTERIOR BOUNDARIES, THE LOCATION OF ALL VISIBLE STRUCTURES AND DIMENSIONS OF ALL PRINCIPAL BUILDINGS THEREON, BOUNDARY FENCES, APPARENT EASEMENTS, ROADWAYS AND ENCROACHMENTS, IF ANY."

"THIS SURVEY IS MADE FOR THE USE OF THE PRESENT OWNERS OF THE PROPERTY, AND THOSE WHO PURCHASE, MORTGAGE, OR GUARANTEE THE TITLE THERETO WITHIN ONE YEAR FROM DATE HEREOF."

SATTER SURVEYING, LLC
LAND SURVEYS, MAPPING AND PLANNING
272 ORIGIN STREET
BURLINGTON, WI 53105
262-661-4239

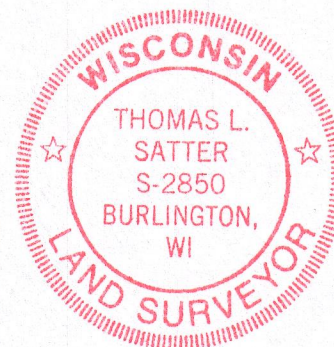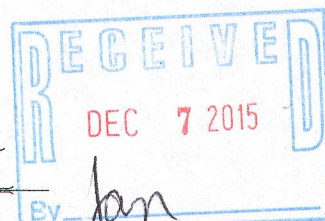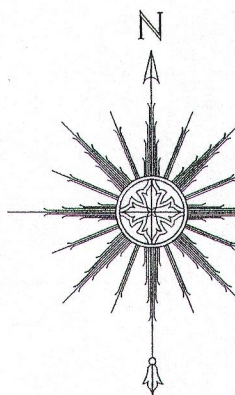

THIS IS NOT AN ORIGINAL PRINT
UNLESS THIS SEAL IS RED.

Thomas L. Satter
THOMAS L. SATTER S-2850

SEPTEMBER 4, 2015
DATE

081510
JOB NUMBER