


15858

LOT 1 of 1263
Spring Park Subd

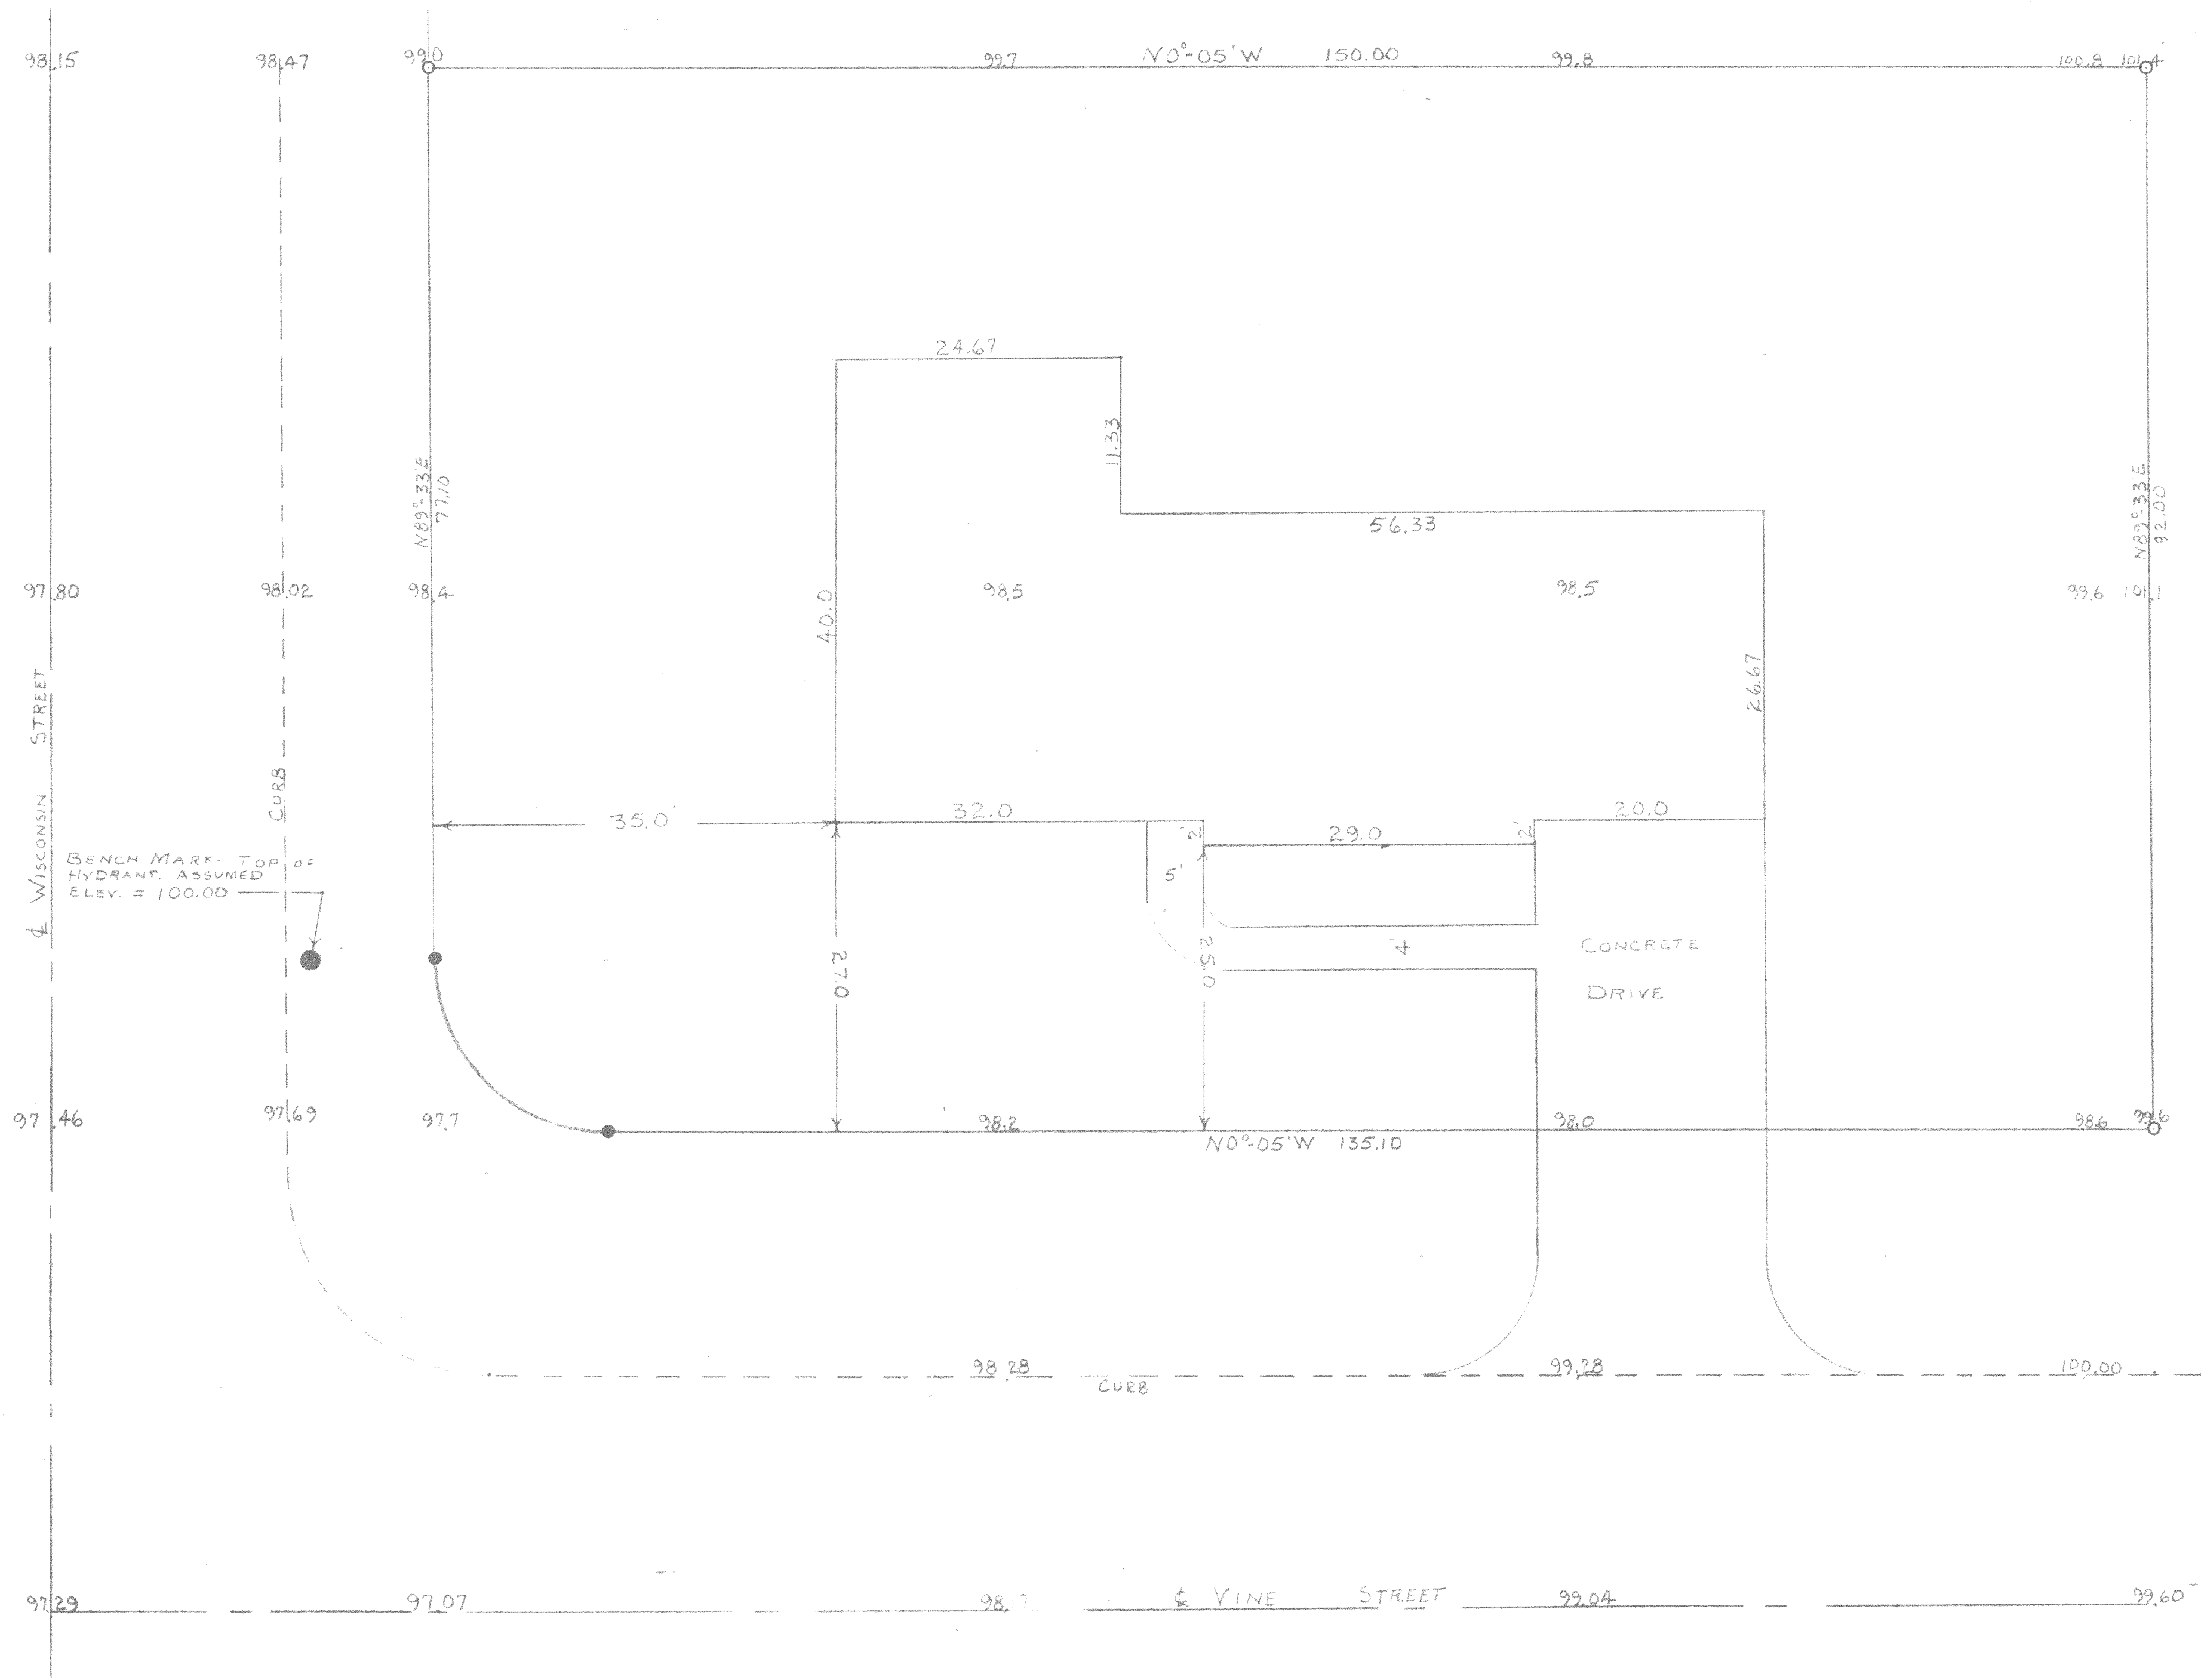

BENCH MARK: TOP OF HYDRANT, ASSUMED ELEV. = 100.00

SCALE 1"=10'

N

2-260