


GEORGE T. DUNHAM
SURVEYING & SUBDIVIDING
DELAVER, WISCONSIN

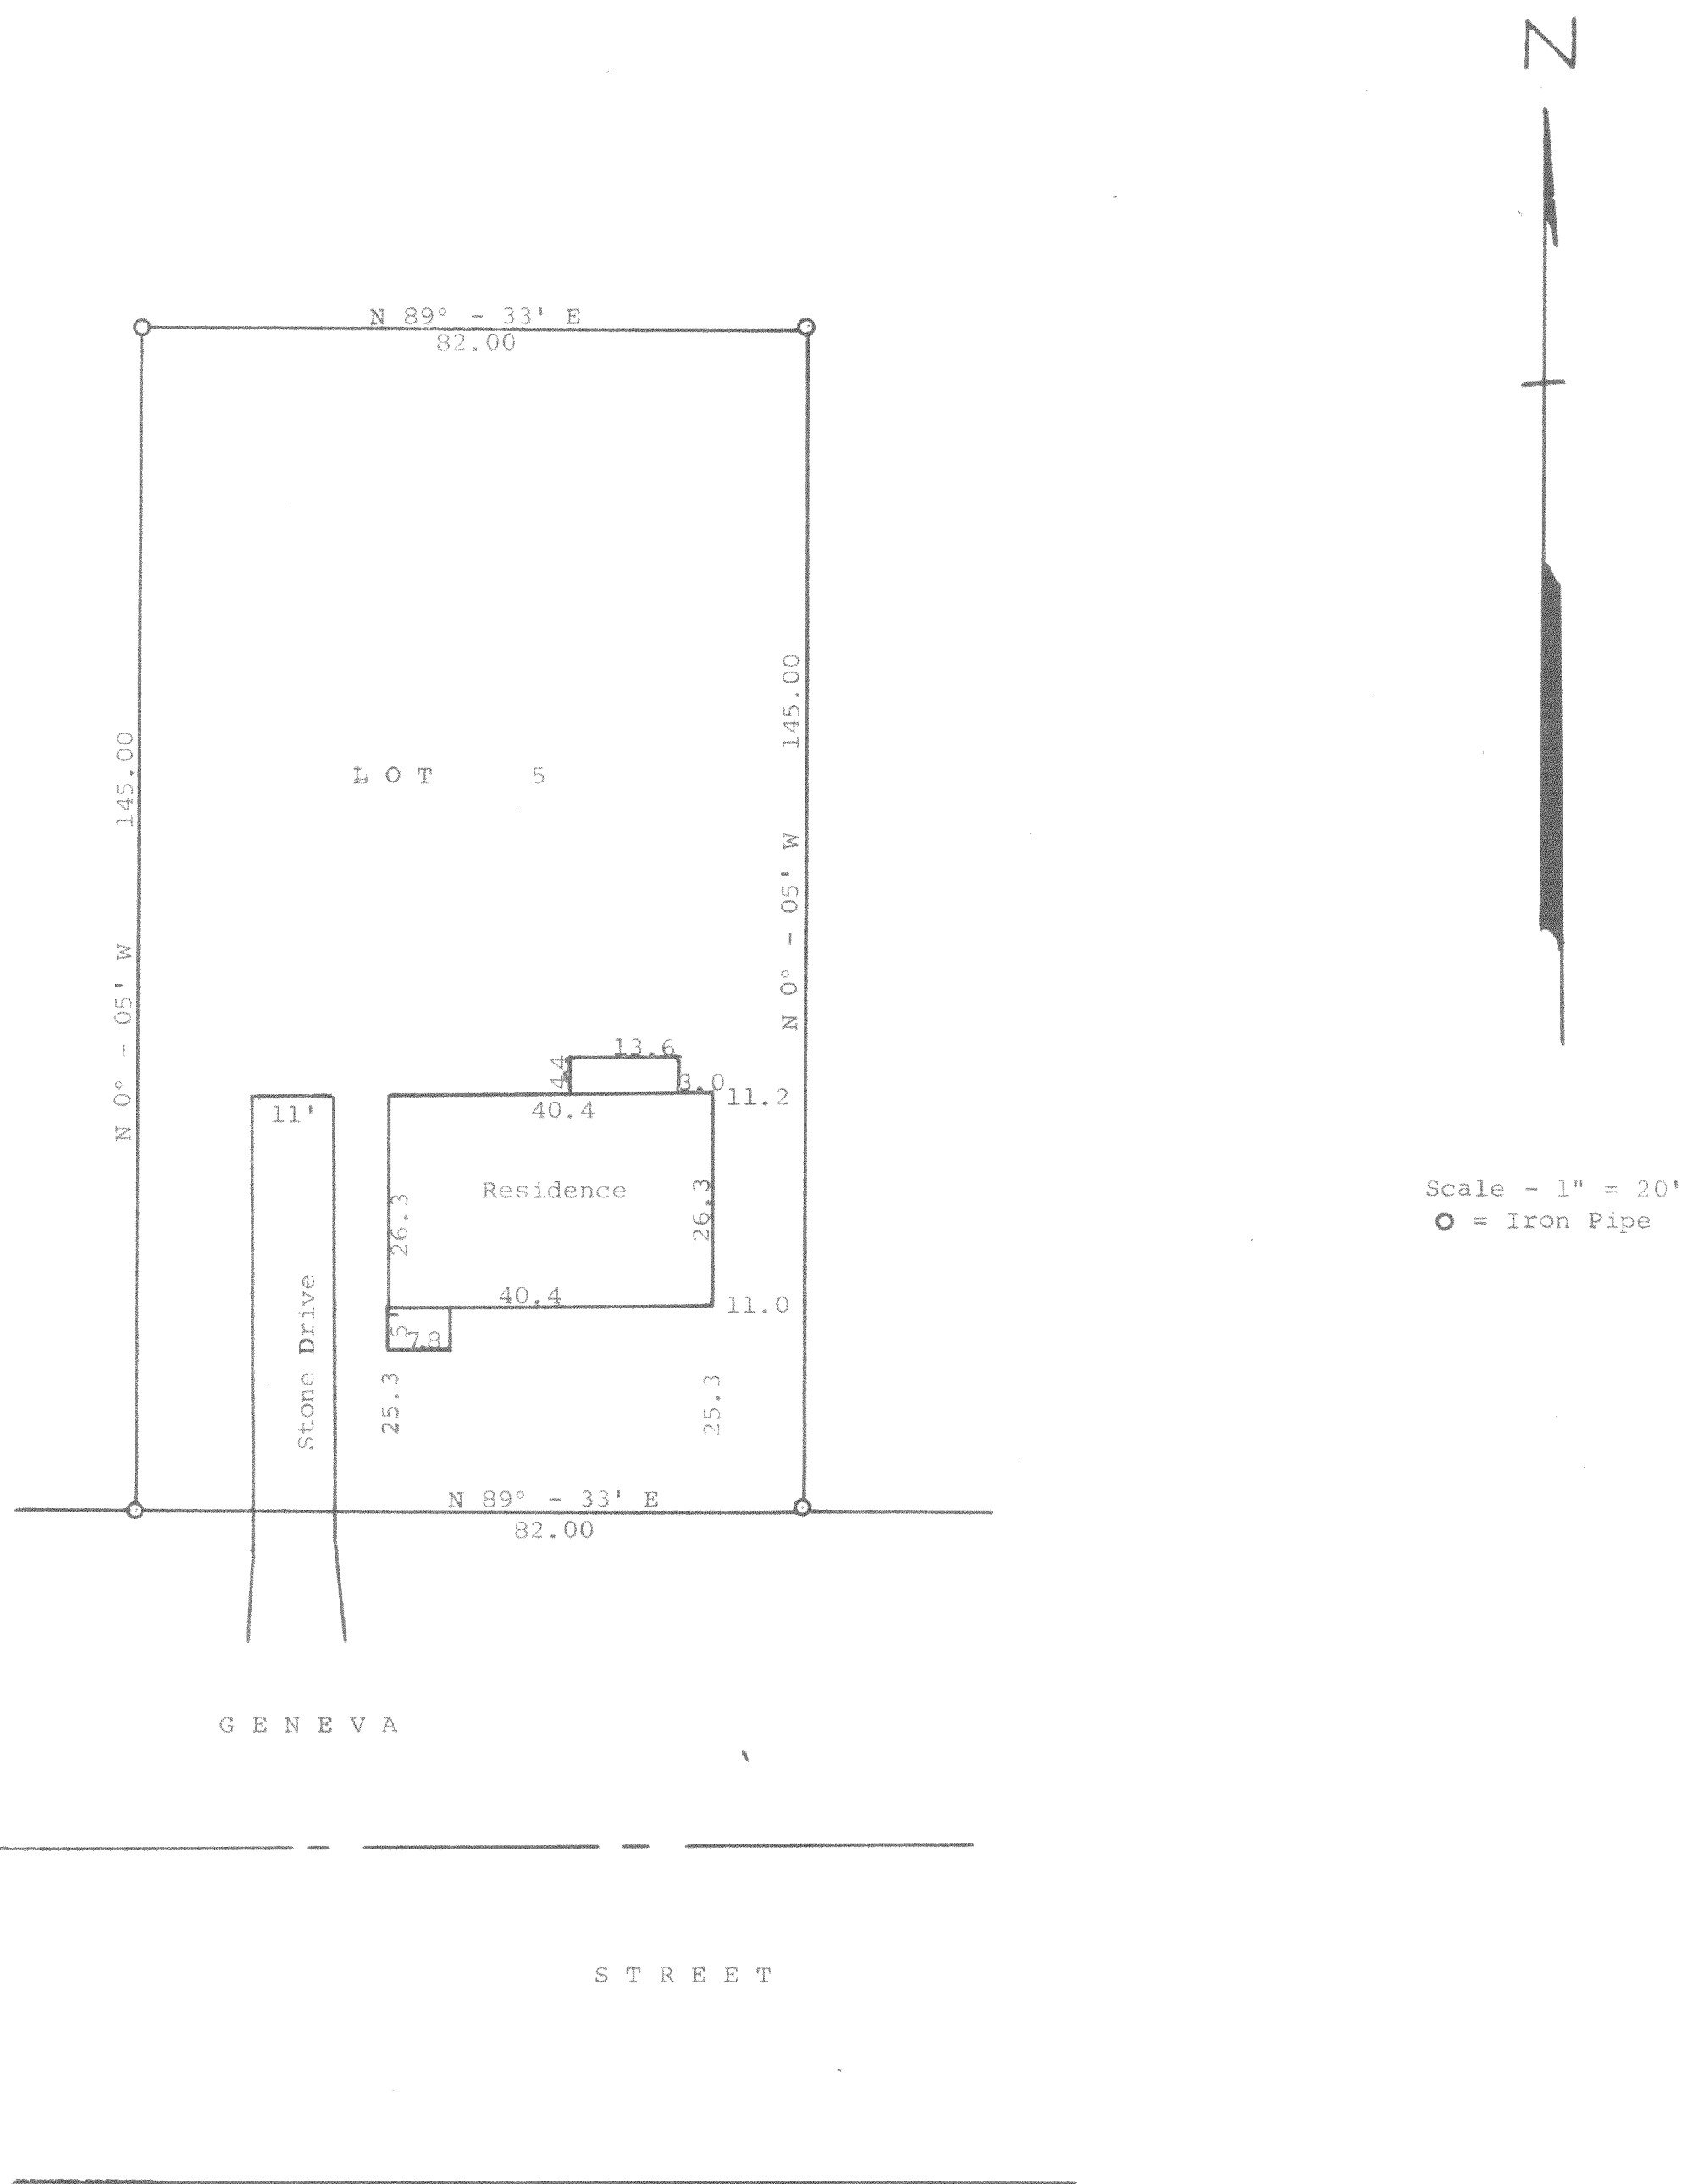

STATE OF WISCONSIN)
WALWORTH COUNTY) SS

I, George T. Dunham, Surveyor, do hereby certify that I have surveyed the property described as follows,

Lot 5, Block 5 of Springs Park Subdivision located in the City of Delavan, Walworth County, Wisconsin.

and the aboveplat is an accurate survey and a true representation thereof and correctly shows the location of a residence located thereon. March 10, 1965.

George T. Dunham
George T. Dunham, Surveyor