

of

Lot 3 in Block 2, of J.B. Devendorf's Addition to the Village, now City, of Delavan, and all of Lot 4 in said Block 2 of said J.B. Devendorf's Addition, except a strip of land off the south side of said Lot 4 deeded to the City of Delavan, and excepting from the above described real estate the east 80 feet thereof as more particularly described in warranty deed to Clyde W. Blakelee and Inez J. Blakelee, as recorded in Volume 338 of Deeds on page 293, Walworth County Records.

DEC 14 2017
JMK

All rights reserved. No part of this survey plat may be reproduced or transmitted in any form by any means - graphic, electronic, or mechanical, including photocopying, tracing, or information storage and retrieval systems - without permission in writing from Douglas G. Olson, Olson Land Surveying, LLC.


I hereby certify that I have surveyed the above described property in compliance with Chapter A-E 7 of the Wisconsin Administrative Code and that the map hereon is correct to the best of my professional knowledge and belief and shows the size and location of the property, its exterior boundaries, the location and dimensions of all visible structures thereon, boundary fences, apparent easements and roadways and visible encroachments, if any.

This survey is made for the exclusive use of the present owners of the property, and also those who purchase, mortgage or guarantee title thereto, within one year from the date hereof.

Douglas G. Olson
Wisconsin Professional Land Surveyor - 2093



- 1) This Plat of Survey is not certified unless signed and sealed in red ink.
- 2) This survey is subject to Wisconsin lien laws. This Plat of Survey is the notice of intent to file lien. Lien waiver required.
- 3) The Survey Date shown on this Plat of Survey is the completion date of the field work.

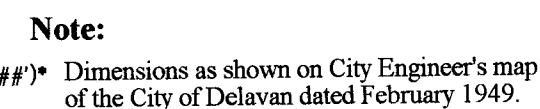

Eighth Street

Survey Date: October 2, 2017.
Revisions:

Scale in Feet
1" = 20'



A horizontal graphic scale bar with alternating black and white segments. The segments are labeled from left to right: 0', 10', 20', 40', and 60'.

45 South Wisconsin Street | P.O. Box 322
Elkhorn, Wisconsin. 53121
Telephone: (262) 723-3434
Facsimile: (262) 723-8044
Email: doug@olsonsurveying.com
Website: www.olsonsurveying.com

OLSON
LAND SURVEYING, LLC
Rural | Residential | Commercial

[illegible]

2017.105

Sheet 1 of 1 Sheets

Drawing Name:

Job Reference Number

2017.105

002-2631