


GEORGE T. DUNHAM
SURVEYING & SUBDIVIDING
DELAN, WISCONSIN

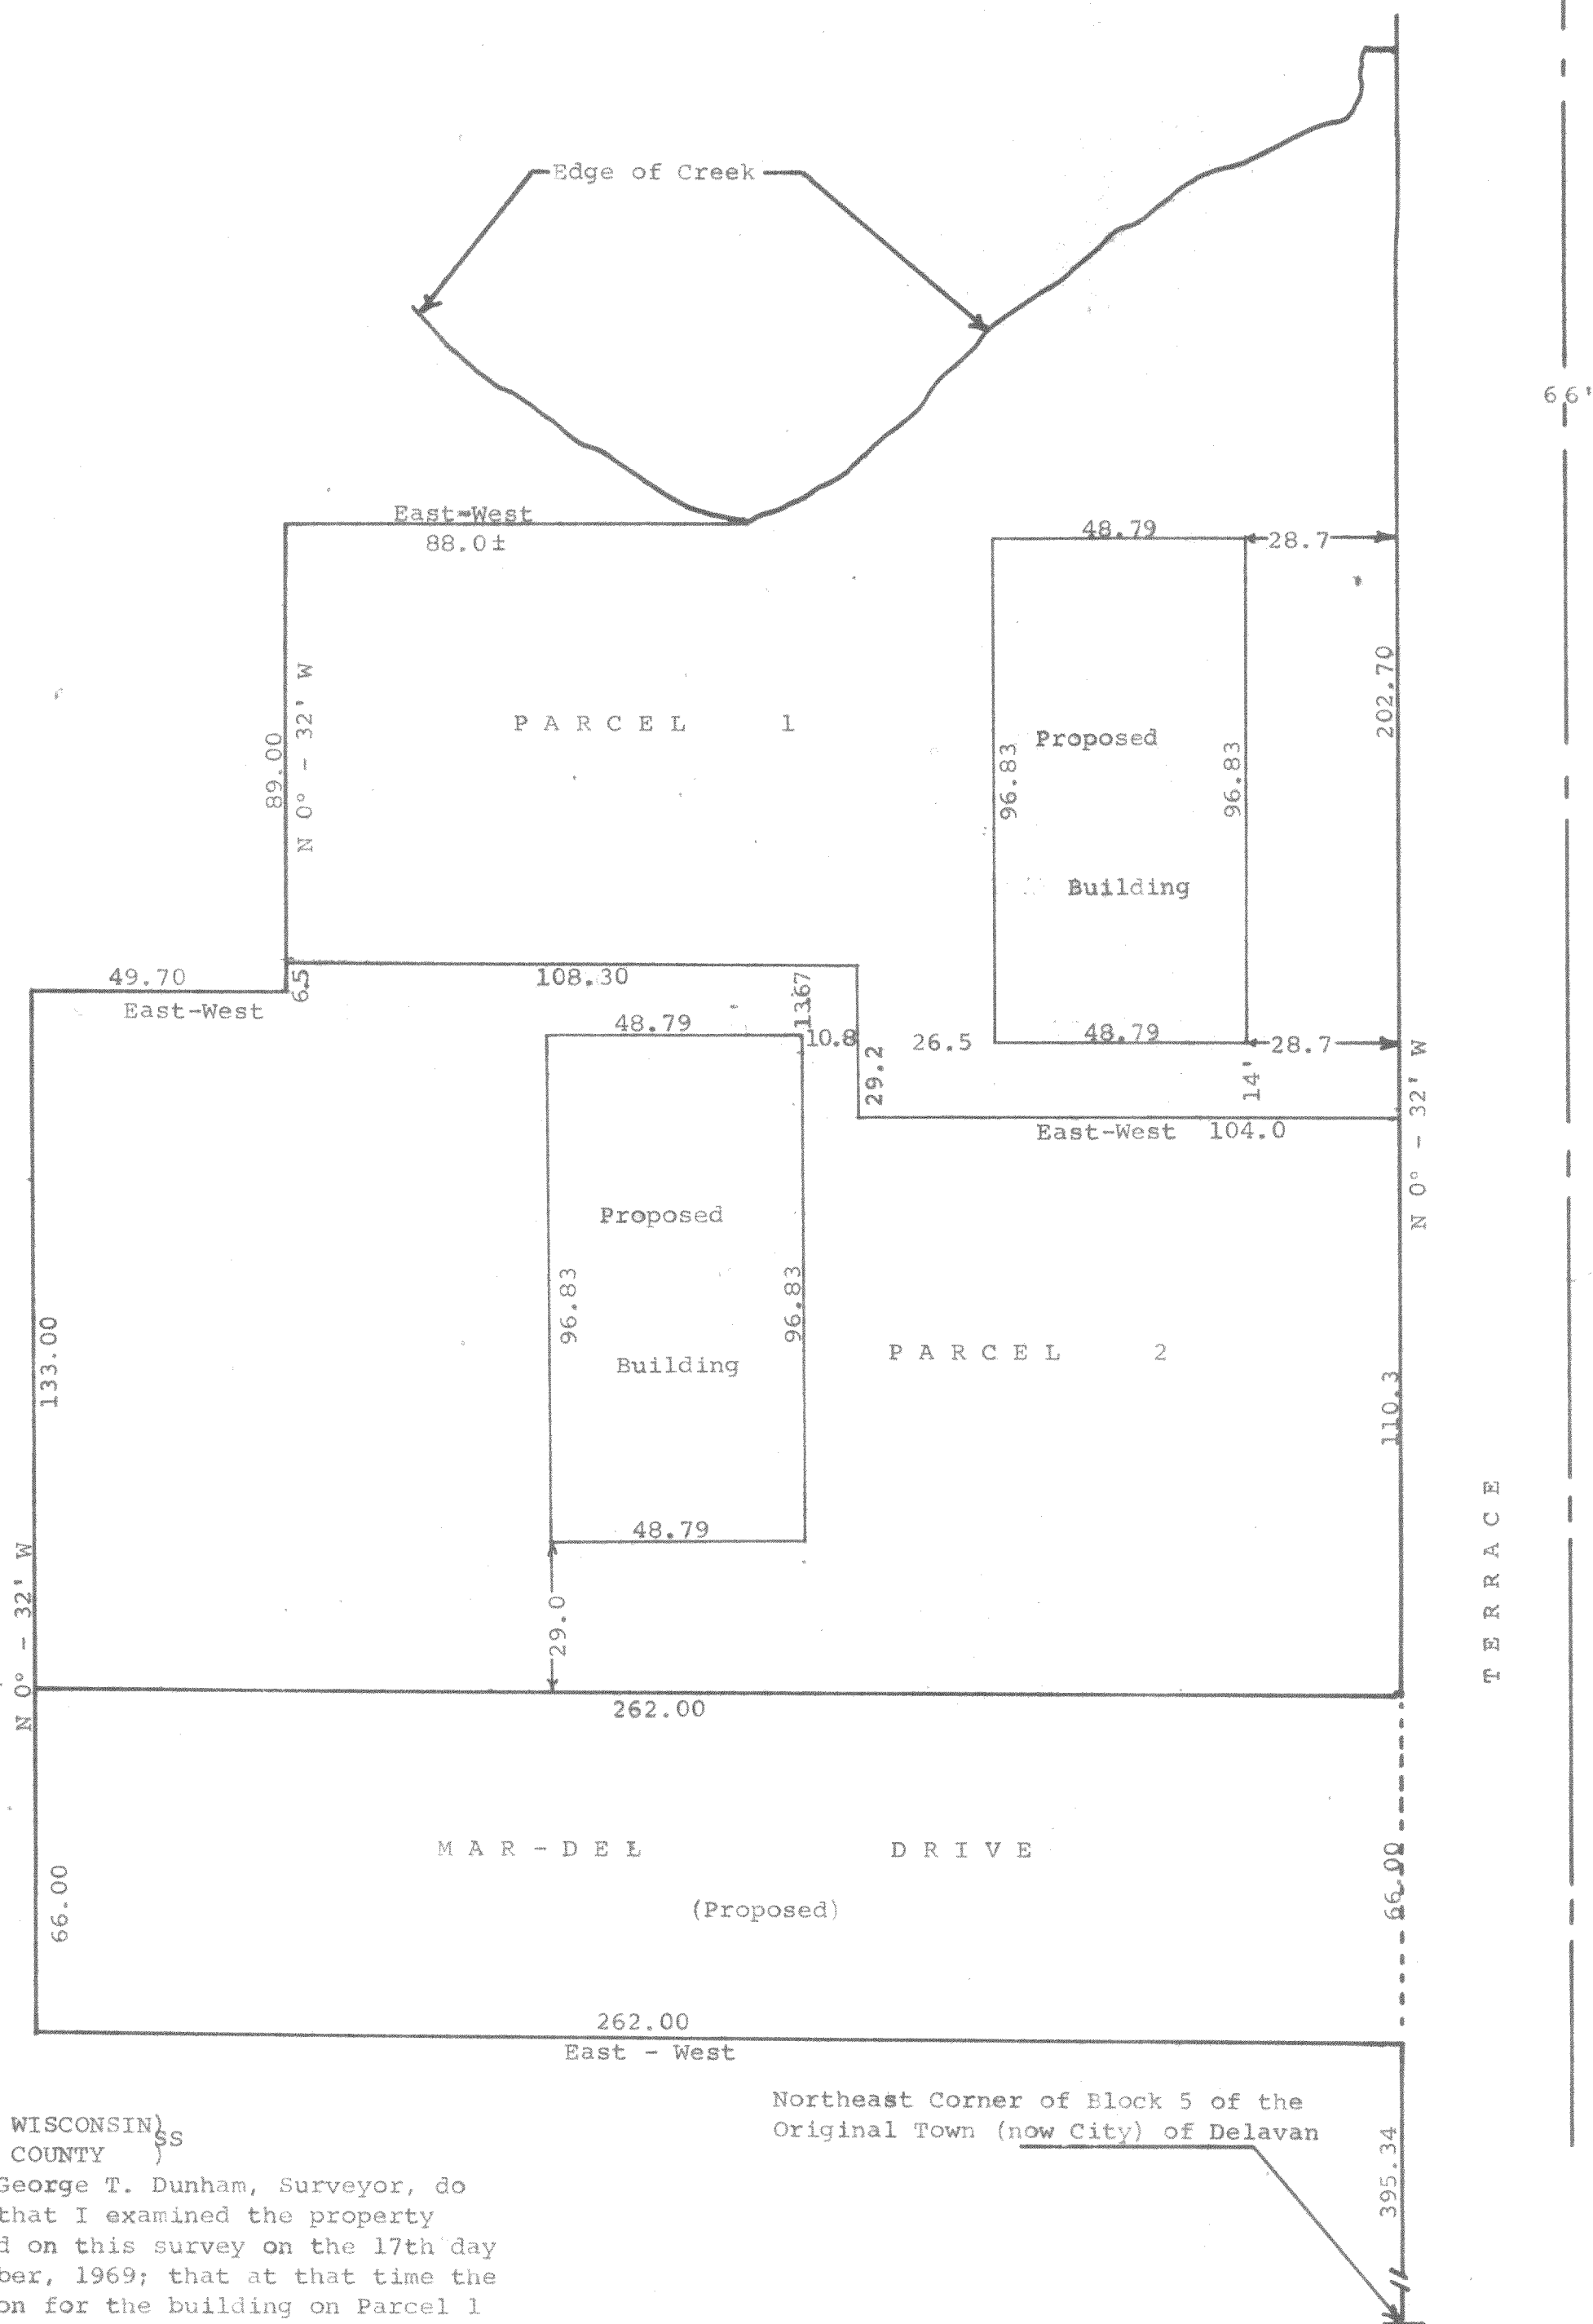

STATE OF WISCONSIN)
WALWORTH COUNTY)

I, George T. Dunham, Surveyor, do certify that I examined the property described on this survey on the 17th day of December, 1969; that at that time the foundation for the building on Parcel 1 was completed and the dimensions on said building and those of the street and side yard setback were as shown on the above plat; that the footings for the building on Parcel 2 were constructed and the dimensions on said building and those of the street and side yard setback were as shown on the above plat.

December 18, 1969

George T. Dunham
George T. Dunham, Surveyor

STATE OF WISCONSIN)
WALWORTH COUNTY)

I, George T. Dunham, Surveyor, do certify that I have surveyed the property described as follows,

A parcel of land located in the Northwest 1/4 of Section 18, T 2 N, R 16 E, City of Delavan, Walworth County, Wisconsin, described as follows, to-wit: Commencing at the northeast corner of Block 5 of the Original Town (now City) of Delavan; thence N 0° - 32' W along the west line of Terrace Street 395.34 feet to the place of beginning; thence West 262.00 feet; thence N 0° - 32' W 199.00 feet; thence East 49.70 feet; thence N 0° - 32' W 89.00 feet; thence East 88.00 feet more or less to the southerly bank of Turtle Creek; thence northeasterly along the creek bank to a point on the west line of said Terrace Street located 379.00 feet N 0° - 32' W of the place of beginning; thence S 0° - 32' E 379.00 feet to the place of beginning.

and that the above plat is an accurate survey and a true representation thereof and correctly shows the location of the proposed buildings to be built on said property.

November 18, 1965

Revised 5/8/69

Revised 6/10/69

George T. Dunham
George T. Dunham, Surveyor

STATE OF WISCONSIN)
COUNTY OF WALWORTH)

I, George T. Dunham, Surveyor, certify that I examined the property described on this survey on the 13th day of July, 1970; that the apartment houses are built on Parcels 1 and 2 and the dimensions on said buildings and those on the street and sideyard setback were as shown on the adjoining plat.

July 13, 1970

George T. Dunham
George T. Dunham, Surveyor

STATE OF WISCONSIN)
WALWORTH COUNTY)

I, George T. Dunham, Surveyor, do certify that I examined the property described on this survey on the 15th day of August, 1969 at 1:00 P.M.; that at that time there was no construction work started on such premises and no materials stored thereon.

August 18, 1969

George T. Dunham
George T. Dunham, Surveyor