


PLAT OF SURVEY

OF

Lot 12, Block 6, SPRINGS PARK SUBDIVISION ADDITION NUMBER 2, in the City of Delavan, County of Walworth and State of Wisconsin.

Tax Key Number: XSPS2 00002

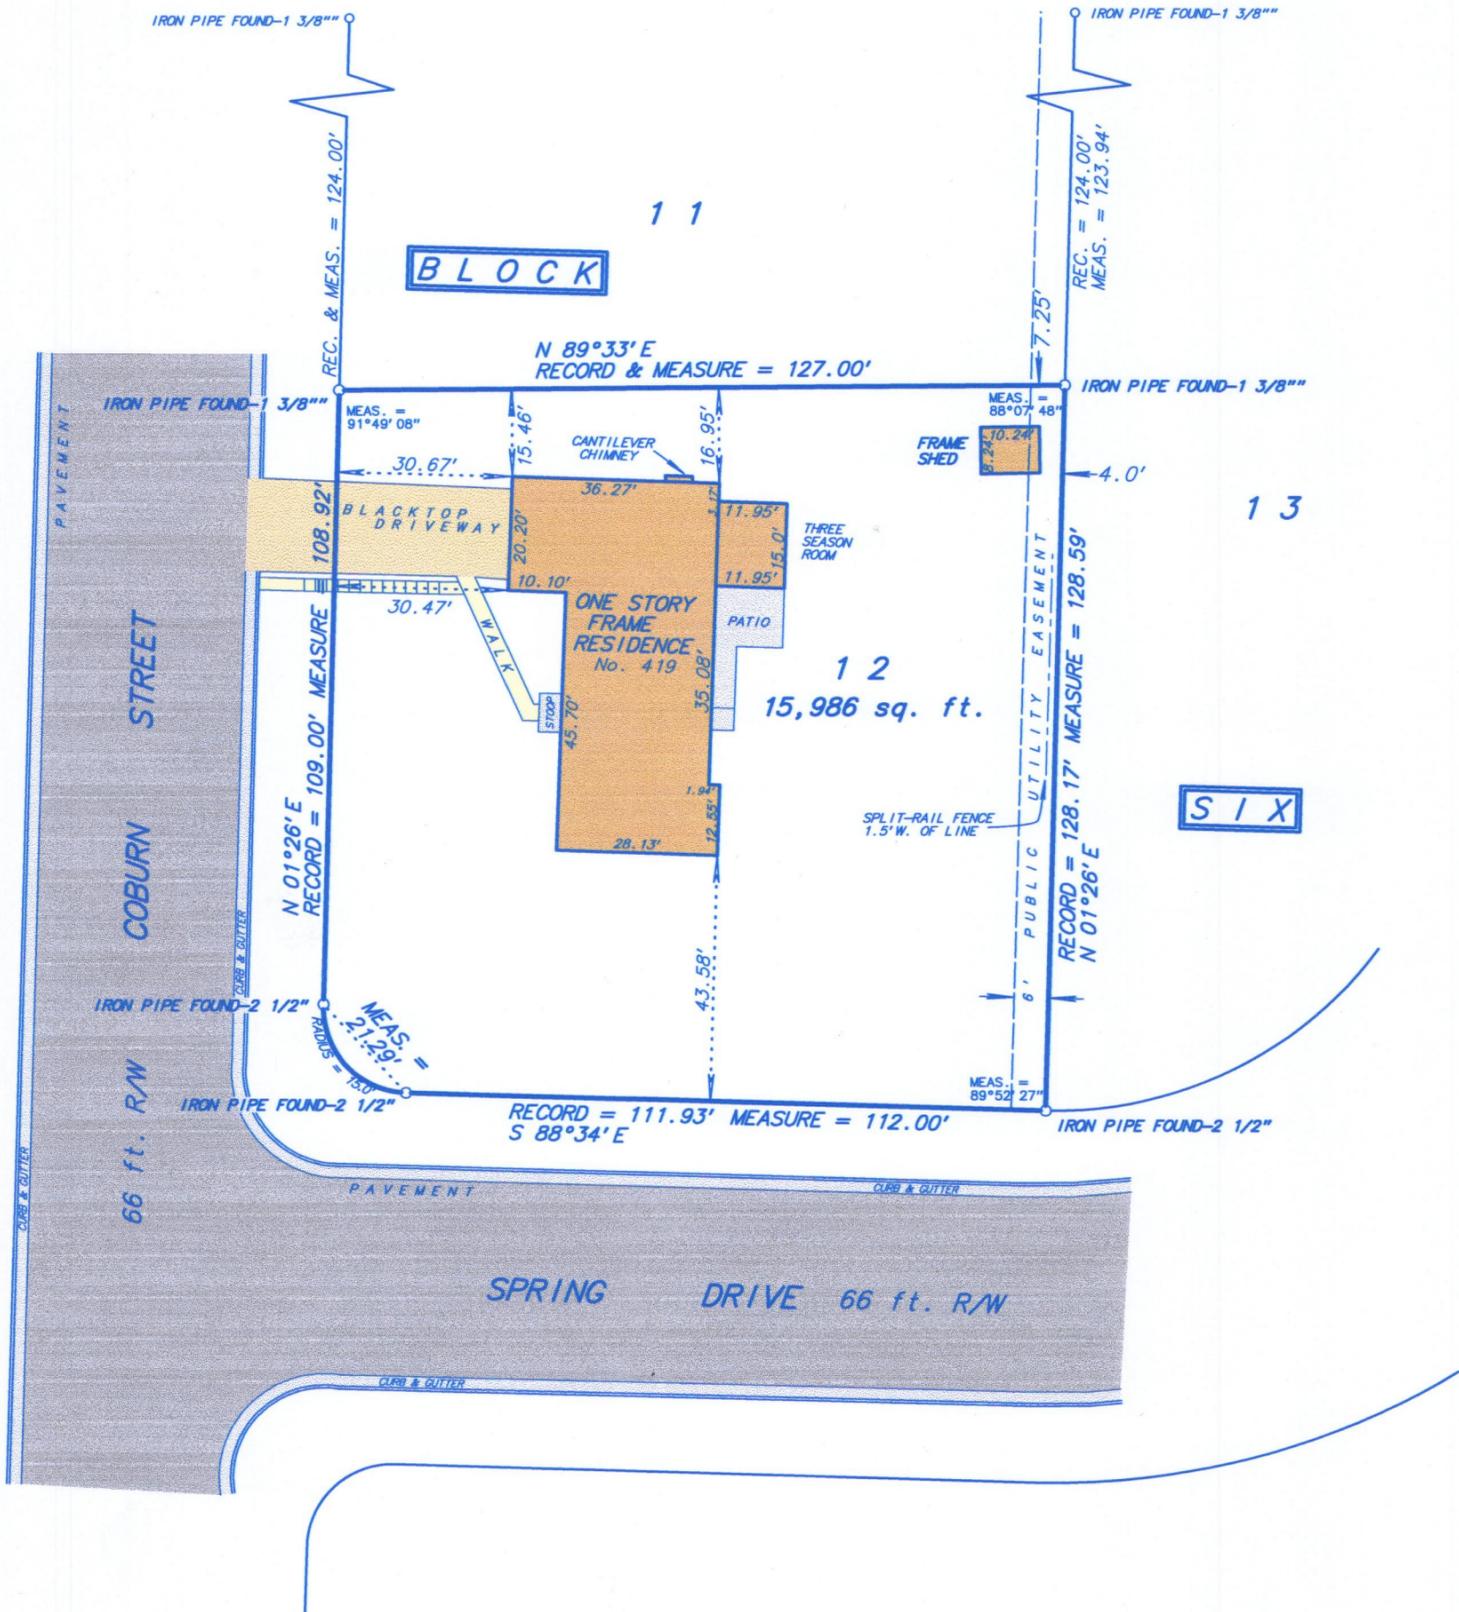

SCALE: 1 inch = 30 feet
 ORDERED BY: D. Schiltz/David Schiltz Law Offices
 JOB NO.: 16031

RECEIVED
 DEC 12 2017
 By Jan

Fieldwork completed on and date of certification: March 30, 2016

I hereby certify that I have surveyed the above described property and the above plat is a true representation thereof and shows the size and location of the property, its exterior boundaries, the location and dimensions of all visible structures thereon, boundary fences, apparent easements and roadways and visible encroachments, if any.

This survey is made for the exclusive use of the present owners of the property, and also those who purchase, mortgage or guarantee the title thereto within ONE YEAR from the date hereof.

Dated at Wheatland, Wisconsin this _____ day of _____ 2016.

Mark A. Bolender
 Wisconsin Professional Land Surveyor 1784