



Batterman
engineers surveyors planners
2857 Barrells Drive
Beloit, Wisconsin 53511
608.365.4464
www.batterman.com

PLAT OF SURVEY

FOR THE EXCLUSIVE USE OF:

TIETZ CONSTRUCTION

ORDER NO: 33029

BOOK: SEE FILE

FIELD CREW: DGM


DRAWN BY: DGM

DATE: September 20, 2018

File Name: 1432000-32000-32000 - Tietz Construction GI DEVLBYR PD ADMINI CIL ETC

PLAT OF SURVEY

OF LOT 48, GLEN OAKS OF DELAVAN, BEING PART OF THE
SE 1/4 OF THE NW 1/4 AND SW 1/4 OF THE NE 1/4 OF
SECTION 13, T. 2 N., R. 15 E., OF THE 4TH P.M., CITY OF
DELAHAN, WALWORTH COUNTY, WISCONSIN.

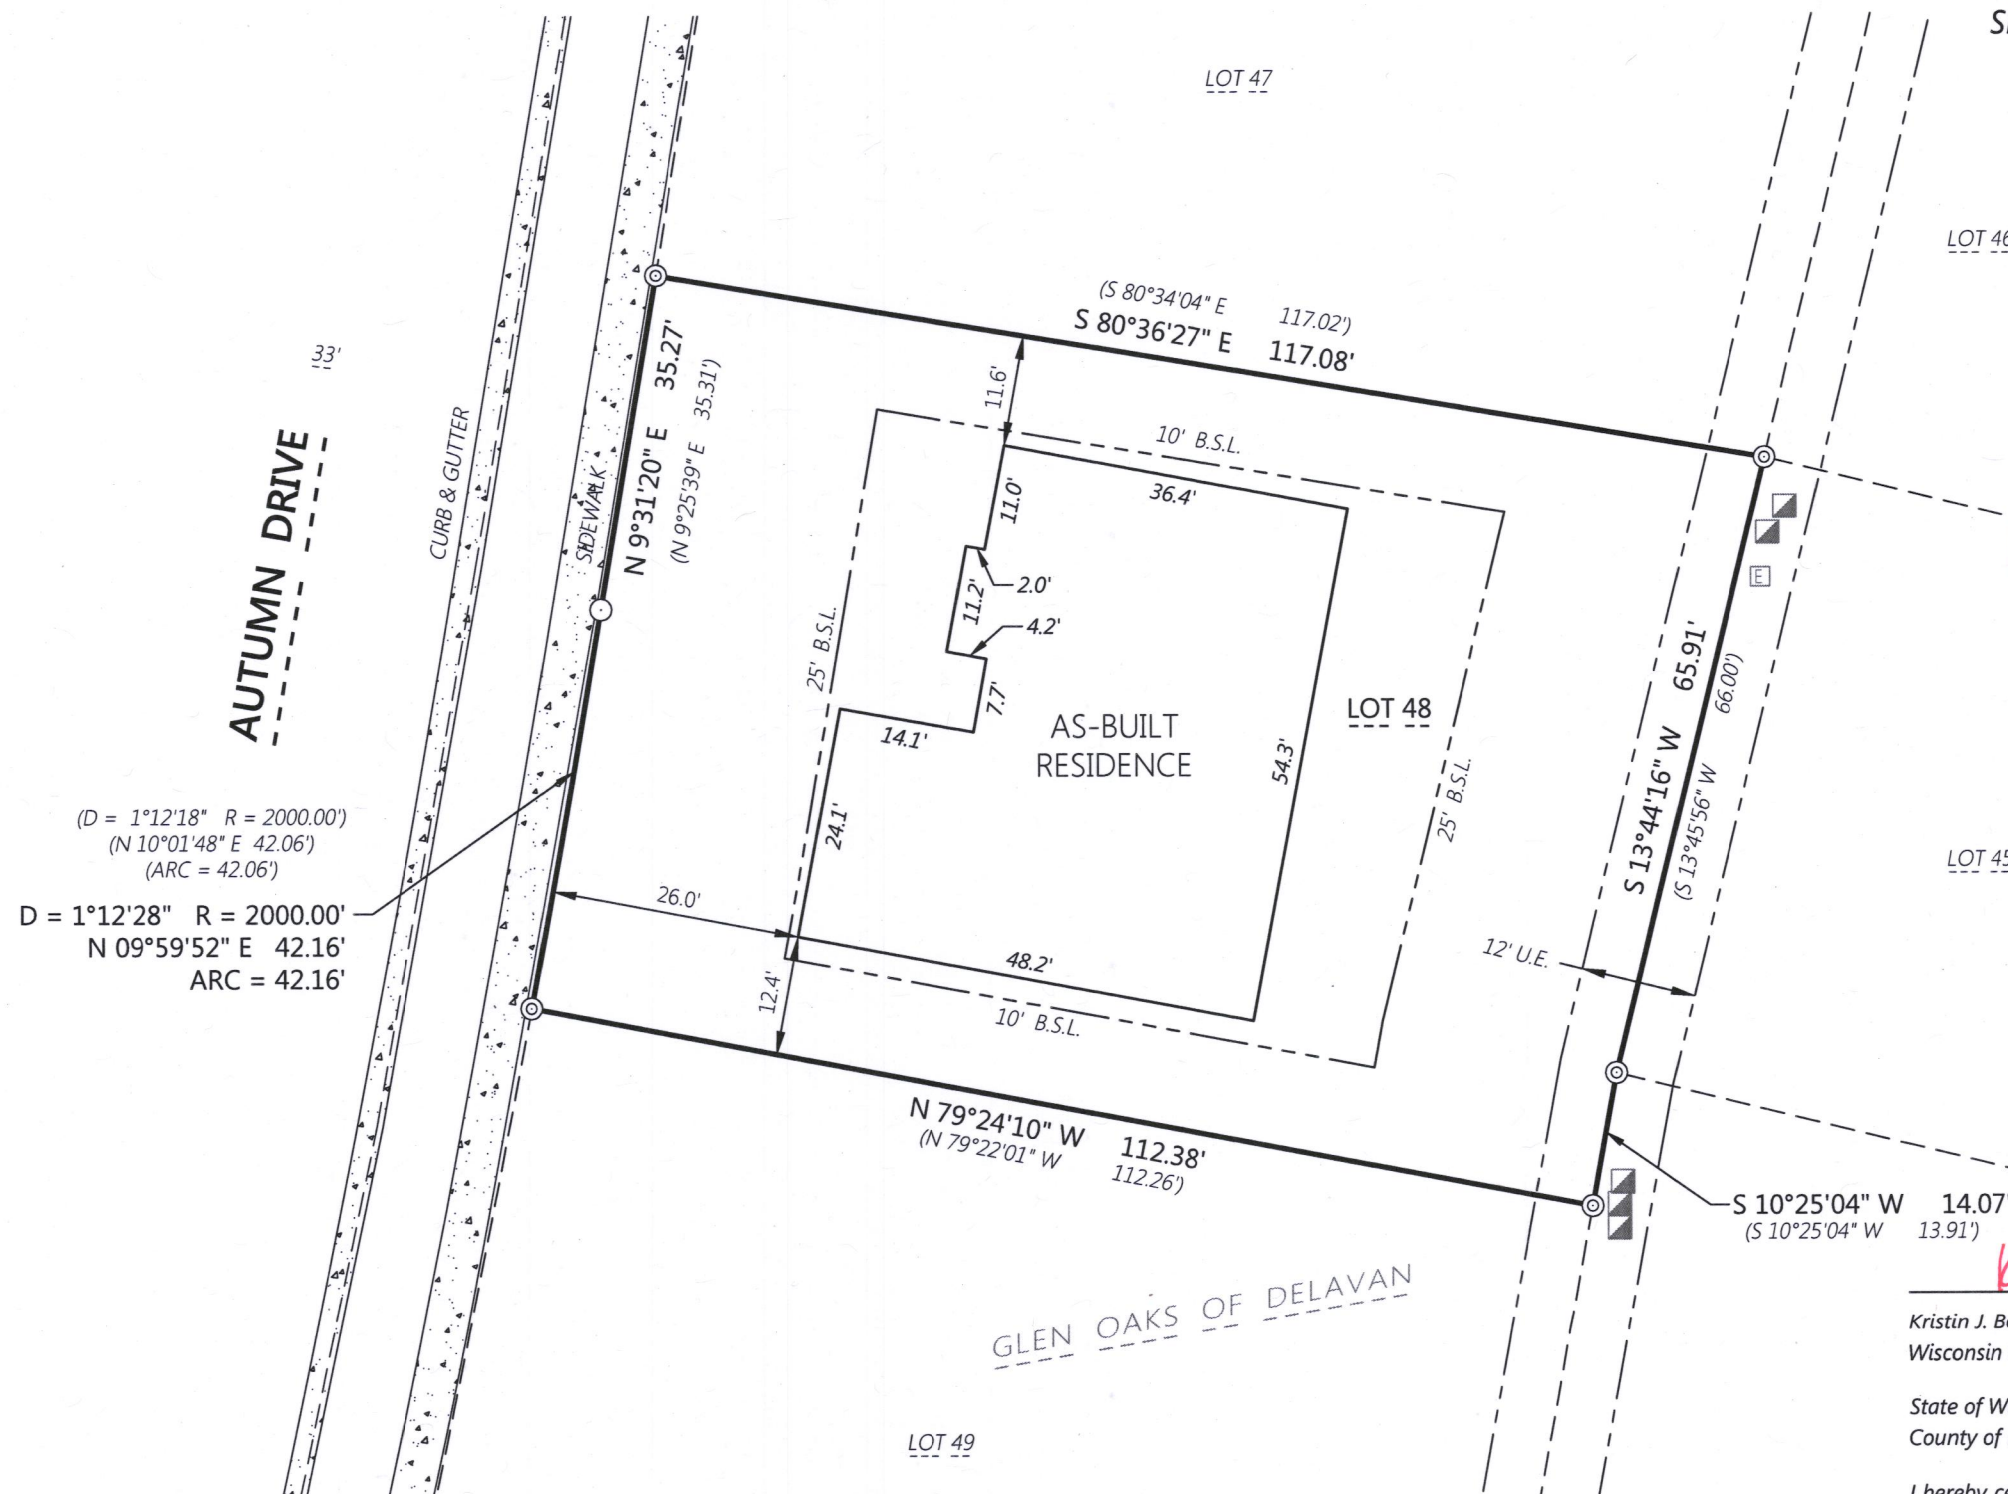

XGLE -48 002-2668