





PLAT OF SURVEY

OF LOT 50, GLEN OAKS OF DELAVAN, BEING PART OF THE
SE 1/4 OF THE NW 1/4 AND SW 1/4 OF THE NE 1/4 OF
SECTION 13, T. 2 N., R. 15 E., OF THE 4TH P.M., CITY OF
DELAVAN, WALWORTH COUNTY, WISCONSIN.

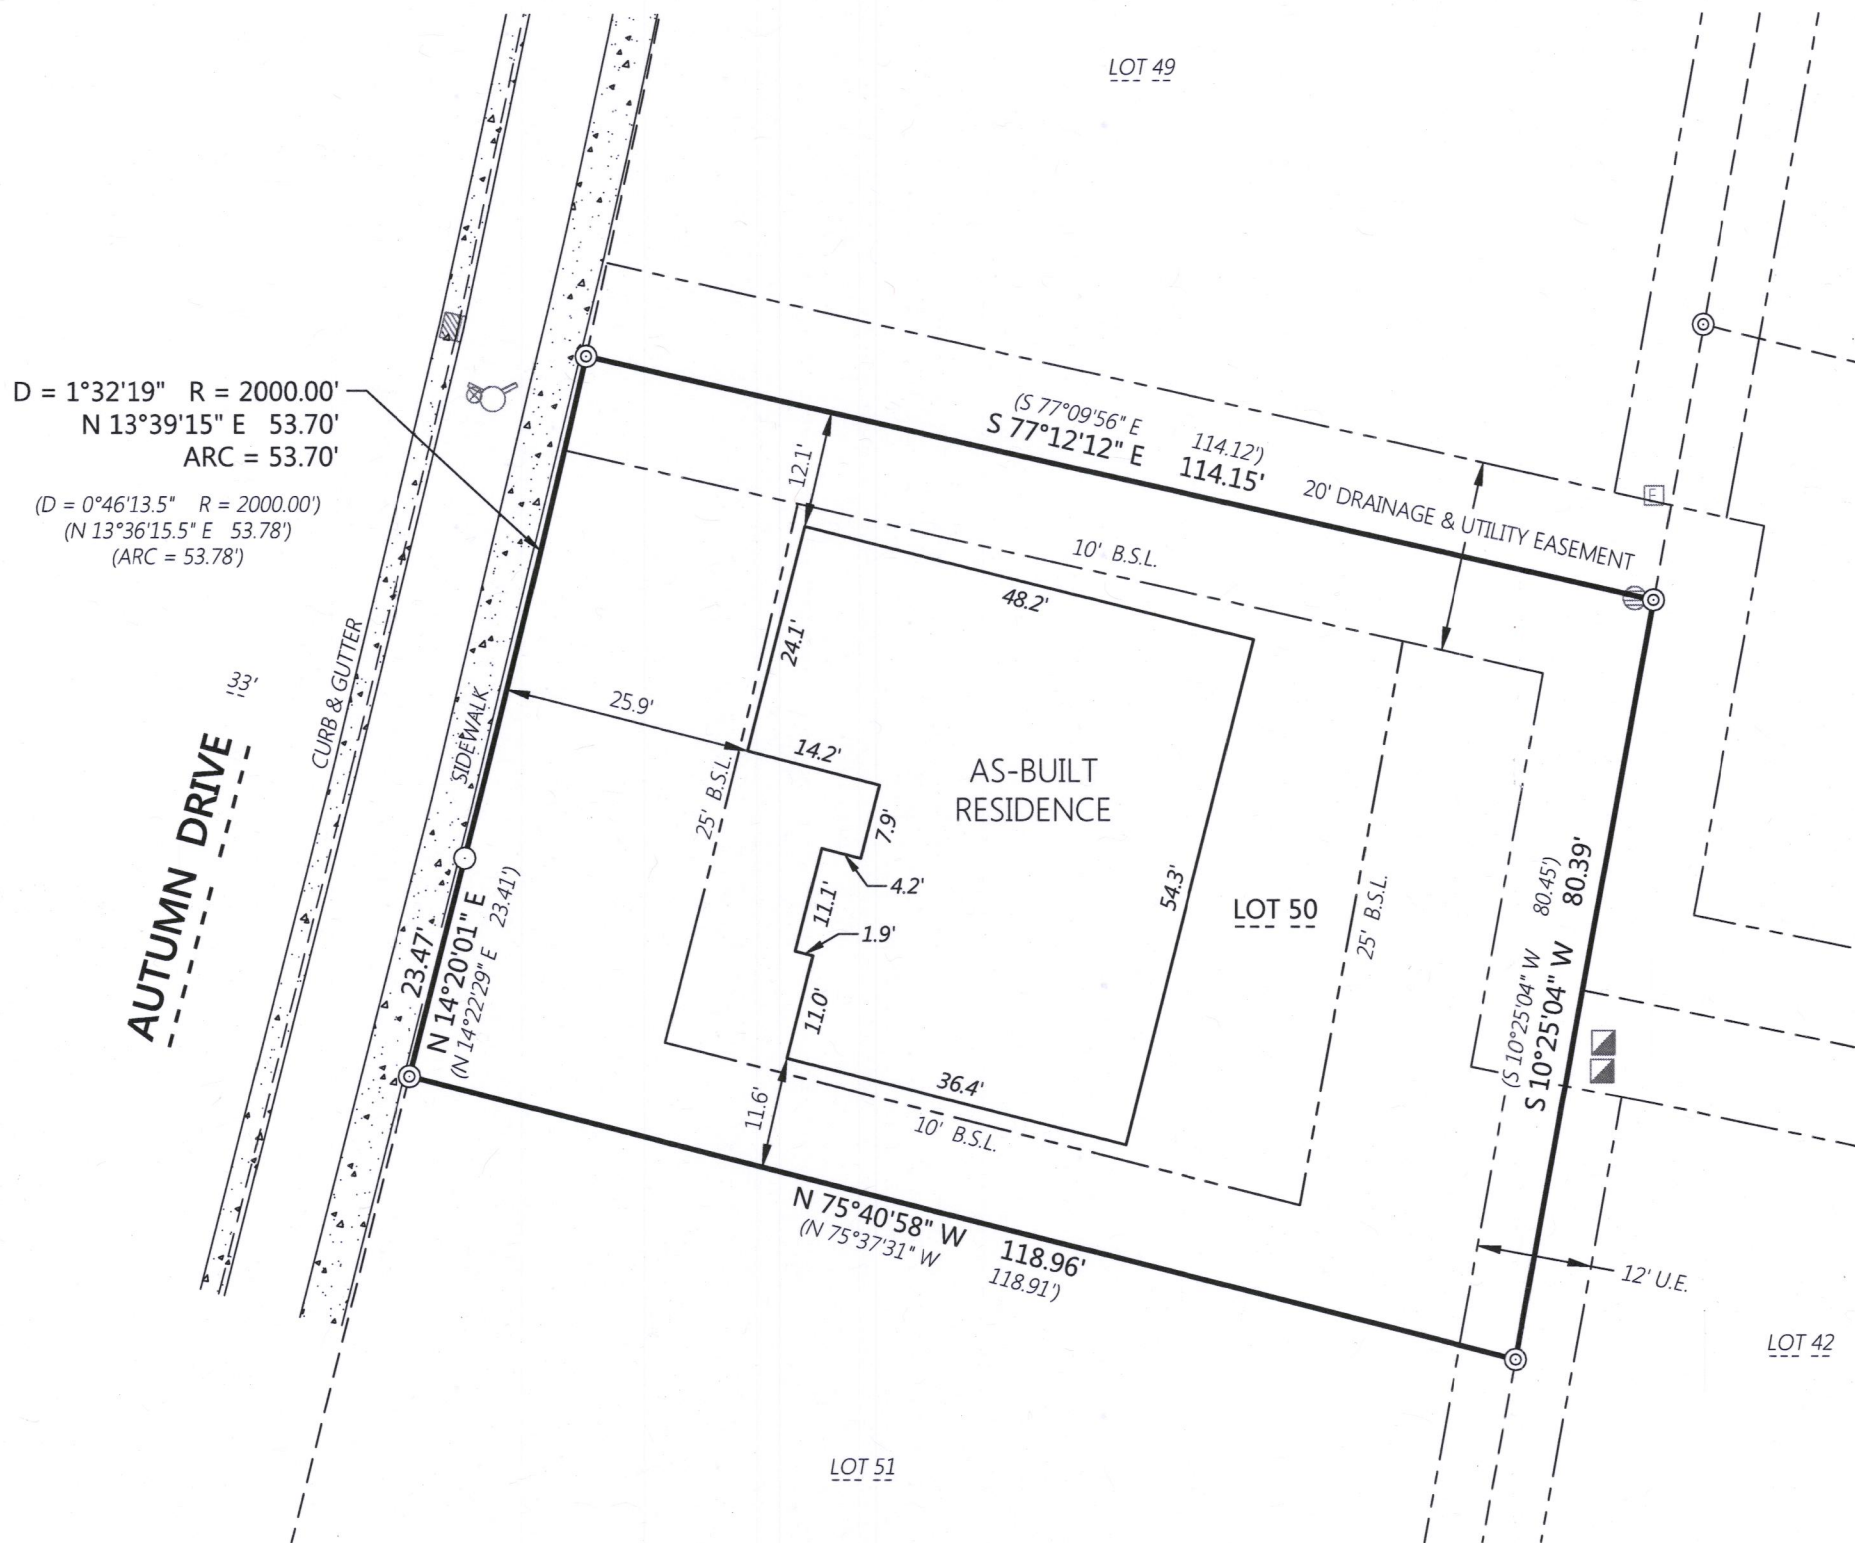

Scale: 1" = 20'

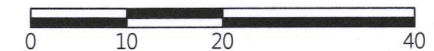

BEARINGS BASED ON THE EAST LINE OF
LOT 50, BEARING S 10°25'04" W

LEGEND

- ⊙ 1" Iron Pipe Found
- 2" Iron Pipe Found

Kristin Belongia

Kristin J. Belongia, P.L.S.
Wisconsin Professional Land Surveyor S-2943

State of Wisconsin } ss
County of Rock }

If the surveyor's signature is not red in color,
the plan is a copy that should be assumed to
contain unauthorized alterations.
The certification contained on this document
shall not apply to any copies.

I hereby certify that I have supervised the survey of the property described above and to the best
my knowledge and belief, the plat drawn hereon complies with Chapter A-E 7 of the State of
Wisconsin Administrative Code, Minimum Standards for Property Surveys and correctly
represents said survey and its location.

Given under my hand and seal this 5th day of June, 2018 at Deloit, Wisconsin.

Last day of field work September 17th, 2018.

Revised this 19th day of September, 2018 to show size and location of as-built residence.



Batterman
engineers surveyors planners
Beloit, Wisconsin 53511
2857 Bartells Drive
608.365.4464
www.rhbatterman.com

PLAT OF SURVEY

FOR THE EXCLUSIVE USE OF:

TIETZ CONSTRUCTION

ORDER NO: 33029

BOOK: SEE FILE

FIELD CREW: DGM

DRAWN BY: DGM

DATE: September 20, 2018

File Name: 192000-33000-3-2018 - Tietz Construction SUBMITTAL DRAWING E1.E

XGLE-50 002-2669