## PLAT OF SURVEY

LOT 51, TURTLE CREEK, A SUBDIVISION LOCATED IN THE SOUTHEAST QUARTER OF SECTION 13, TOWNSHIP 2 NORTH, RANGE 15 EAST, CITY OF DELAVAN, WALWORTH COUNTY, WISCONSIN.

## **ABBREVIATION LEGEND**

(M)=MEASURED DIMENSION (R)=RECORD DIMENSION COR.=CORNER CONC.=CONCRETE ASPH.=ASPHALT BSL=BUILDING SETBACK LINE **UE=UTILITY EASEMENT** 



SYMBOL LEGEND

B-BOX **HYDRANT** 

WATER VALVE

AIR CONDITIONER

**ELECTRIC METER** 

6 GAS METER

U UTILITY BOX

UTILITY POLE

STEEL POST MONUMENTATION

**BASIS OF BEARINGS:** TURTLE CREEK RECORDED NOVEMBER 15, 1974 AS DOCUMENT P685642 IN WALWORTH COUNTY, WISCONSIN.

LINE LEGEND

 WOOD FENCE OVERHEAD WIRES

NOTES: 1. NO DIMENSIONS TO BE ASSUMED BY SCALED MEASUREMENTS.

2. UNDERGROUND UTILITIES MAY EXIST THAT ARE NOT SHOWN HEREON. UTILITIES SHOWN HEREON ARE PER OBSERVED EVIDENCE TOGETHER WITH EVIDENCE FROM MARKINGS BY UTILITY COMPANIES AND OTHER APPROPRIATE SOURCES.

ONLY EASEMENTS AND SETBACK LINES INDICATED ON THE RECORDED SUBDIVISION PLAT AND INFORMATION PROVIDED BY CLIENT AND THAT AFFECT THE SURVEYED PARCEL ARE SHOWN HEREON.
4. BUILDING TIE DIMENSIONS ARE NOT BE USED TO

DETERMINE LOT LINE LOCATIONS. REFER TO ACTUAL LOT

5. ANY DISCREPANCIES FOUND BETWEEN THIS PLAT AND ACTUAL SITE CONDITIONS MUST BE REPORTED TO THE SURVEYOR IMMEDIATELY. 6. DIMENSIONS ARE SHOWN IN FEET AND DECIMAL PARTS


7. THIS PLAT IS VOID WITHOUT THE SEAL AND

SIGNATURE OF THE SURVEYOR.

8. LOT DIMENSIONS ARE RECORD UNLESS OTHERWISE. TIES ARE MEASURED TO AND ALONG THE FACE OF

THE BUILDING AT BREAST HEIGHT.

COPYRIGHT © 2020 JACOBS SURVEYING & ENGINEERING. ALL RIGHTS RESERVED.

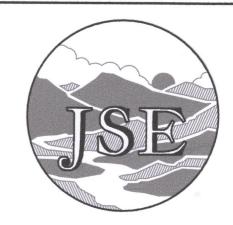

JACOBS SURVEYING & ENGINEERING

2035 KENNEDY DR, MCHENRY, IL 60050 PH: 815-482-1233 JJACOBS@JACOBS-SE.COM WEB: WWW.JACOBS-SE.COM

ILLINOIS PROFESSIONAL DESIGN FIRM NUMBER 184-008077

> CLIENT: BECKER

**BOUNDARY SURVEY** 

LOT 51 IN TURTLE CREEK ADDRESS: 1118 COTTONWOOD ST, DELAVAN PIN: XTC 00051 AREA: 0.25 ACRES

> DRAWN BY: JMJ CHECKED BY: JMJ

DATE: 4/27/2020

PAGE 1 OF 1


PROJECT NUMBER: 2020-059

COTTONWOOD ST

(66' R.O.W.)

ASPH.

CONC. CURB & GUTTER

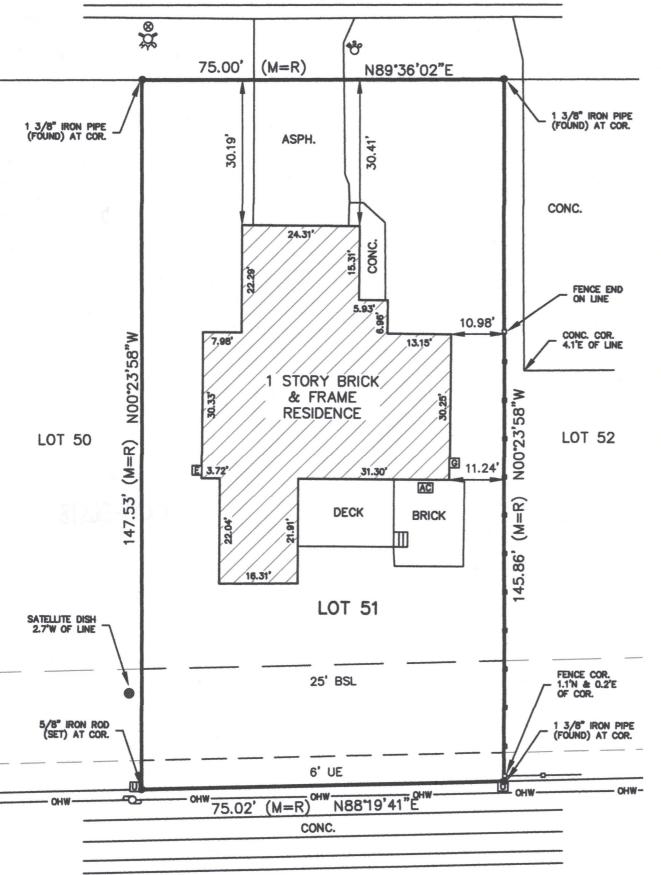

CREEK RD

(66' R.O.W.)

ASPH.

FIELD WORK COMPLETED 4/24/2020.

STATE OF ILLINOIS

CONC. CURB & GUTTER

COUNTY OF MCHENRY

I, JONATHAN M. JACOBS, A WISCONSIN PROFESSIONAL LAND SURVEYOR HEREBY CERTIFY THAT I HAVE SURVEYED THE ABOVE DESCRIBED PROPERTY AND THAT THE ABOVE MAP, TO THE BEST OF MY KNOWLEDGE AND BELIEF, IS A TRUE REPRESENTATION THEREOF AND SHOWS THE SIZE AND LOCATION OF ALL VISIBLE STRUCTURES, APPARENT EASEMENTS AND ENCROACHMENTS

THIS SURVEY IS MADE FOR THE PRESENT OWNERS OF THE PROPERTY, AND THOSE WHO PURCHASE, MORTGAGE, OR GUARANTEE THE TITLE THERETO, WITHIN ONE YEAR FROM THE DATE HEREOF.

DATED THIS 27TH DAY OF APRIL, A.D., 2020.

JONATHAN M. JACOBS WISCONSIN PROFESSIONAL LAND SURVEYOR 3080-8 JACOBS SURVEYING & ENGINEERING



002-2698

EXPIRES 1/31/22