

Plat of Survey

of


Lot 3 in Block 2 of Elmhurst,

a subdivision located in the Northeast 1/4 of the Northwest 1/4 of Section 17,
Town 2 North, Range 16 East, City of Delavan, Walworth County, Wisconsin.

Surveyed for: **Sheila Lundin**
1105 Barnes Street
Delavan, Wisconsin. 53115



Bearings referenced to the North line of Barnes Street,
recorded as N56°E on the plat of Elmhurst.

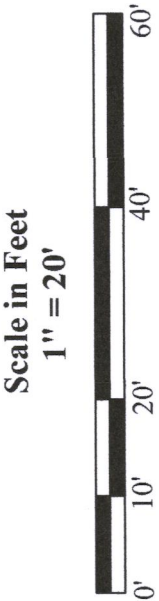

45 South Wisconsin Street | P.O. Box 322
Elkhorn, Wisconsin. 53121
Telephone: (262) 723-3434
Facsimile: (262) 723-8044
Email: doug@olsonsurveying.com
Website: www.olsonsurveying.com



Legend of Symbols & Abbreviations

N	North
S	South
E	East
W	West
B	Bearings
I	Inches
M	Minutes
S	Seconds
D	Distances
F	Feet
Found Iron Pipe	
Found Iron Rod	
Recorded Information	
Utility Pole	
Utility Pedestal	
Asphalt Surface	
Concrete Surface	
Brick Pavers	



Sheet 1 of 1 Sheets
Drawing Name
Job Reference Number
2021.032

2021.032

Survey Date: April 22, 2021.
Revisions:



- Notes:
- 1) This Plat of Survey is not certified unless signed and sealed in red ink.
 - 2) This survey is subject to Wisconsin lien laws. This Plat of Survey is the notice of intent to file lien. Lien waiver required.
 - 3) The Survey Date shown on this Plat of Survey is the completion date of the field work.

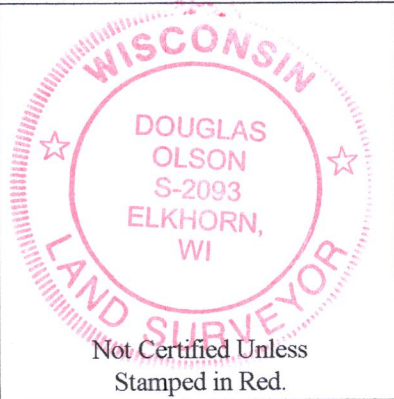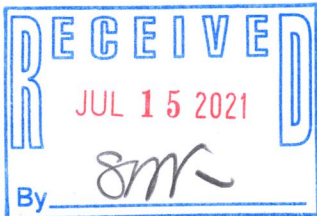

Copyright ©2021 by Olson Land Surveying, LLC.

All rights reserved. No part of this survey plat may be reproduced or transmitted in any form by any means - graphic, electronic, or mechanical, including photocopying, tracing, or information storage and retrieval systems - without permission in writing from Douglas G. Olson, Olson Land Surveying, LLC.

I hereby certify that I have surveyed the above described property in compliance with Chapter A-E 7 of the Wisconsin Administrative Code and that the map hereon is correct to the best of my professional knowledge and belief and shows the size and location of the property, its exterior boundaries, the location and dimensions of all visible structures thereon, boundary fences, apparent easements and roadways and visible encroachments, if any.
This survey is made for the exclusive use of the present owners of the property, and also those who purchase, mortgage or guarantee title thereto, within one year from the date hereof.

Douglas G. Olson
Wisconsin Professional Land Surveyor - 2093

XEA-0A

002-9739